


11-00-015-000-917
11-00-015-B
Scan# 47918

David G. Jaeger
Nov. 14-1942 D. Vol. 324 P. 455

N. 1°34'E. 179'
Slag Drive
0.2356 Acre

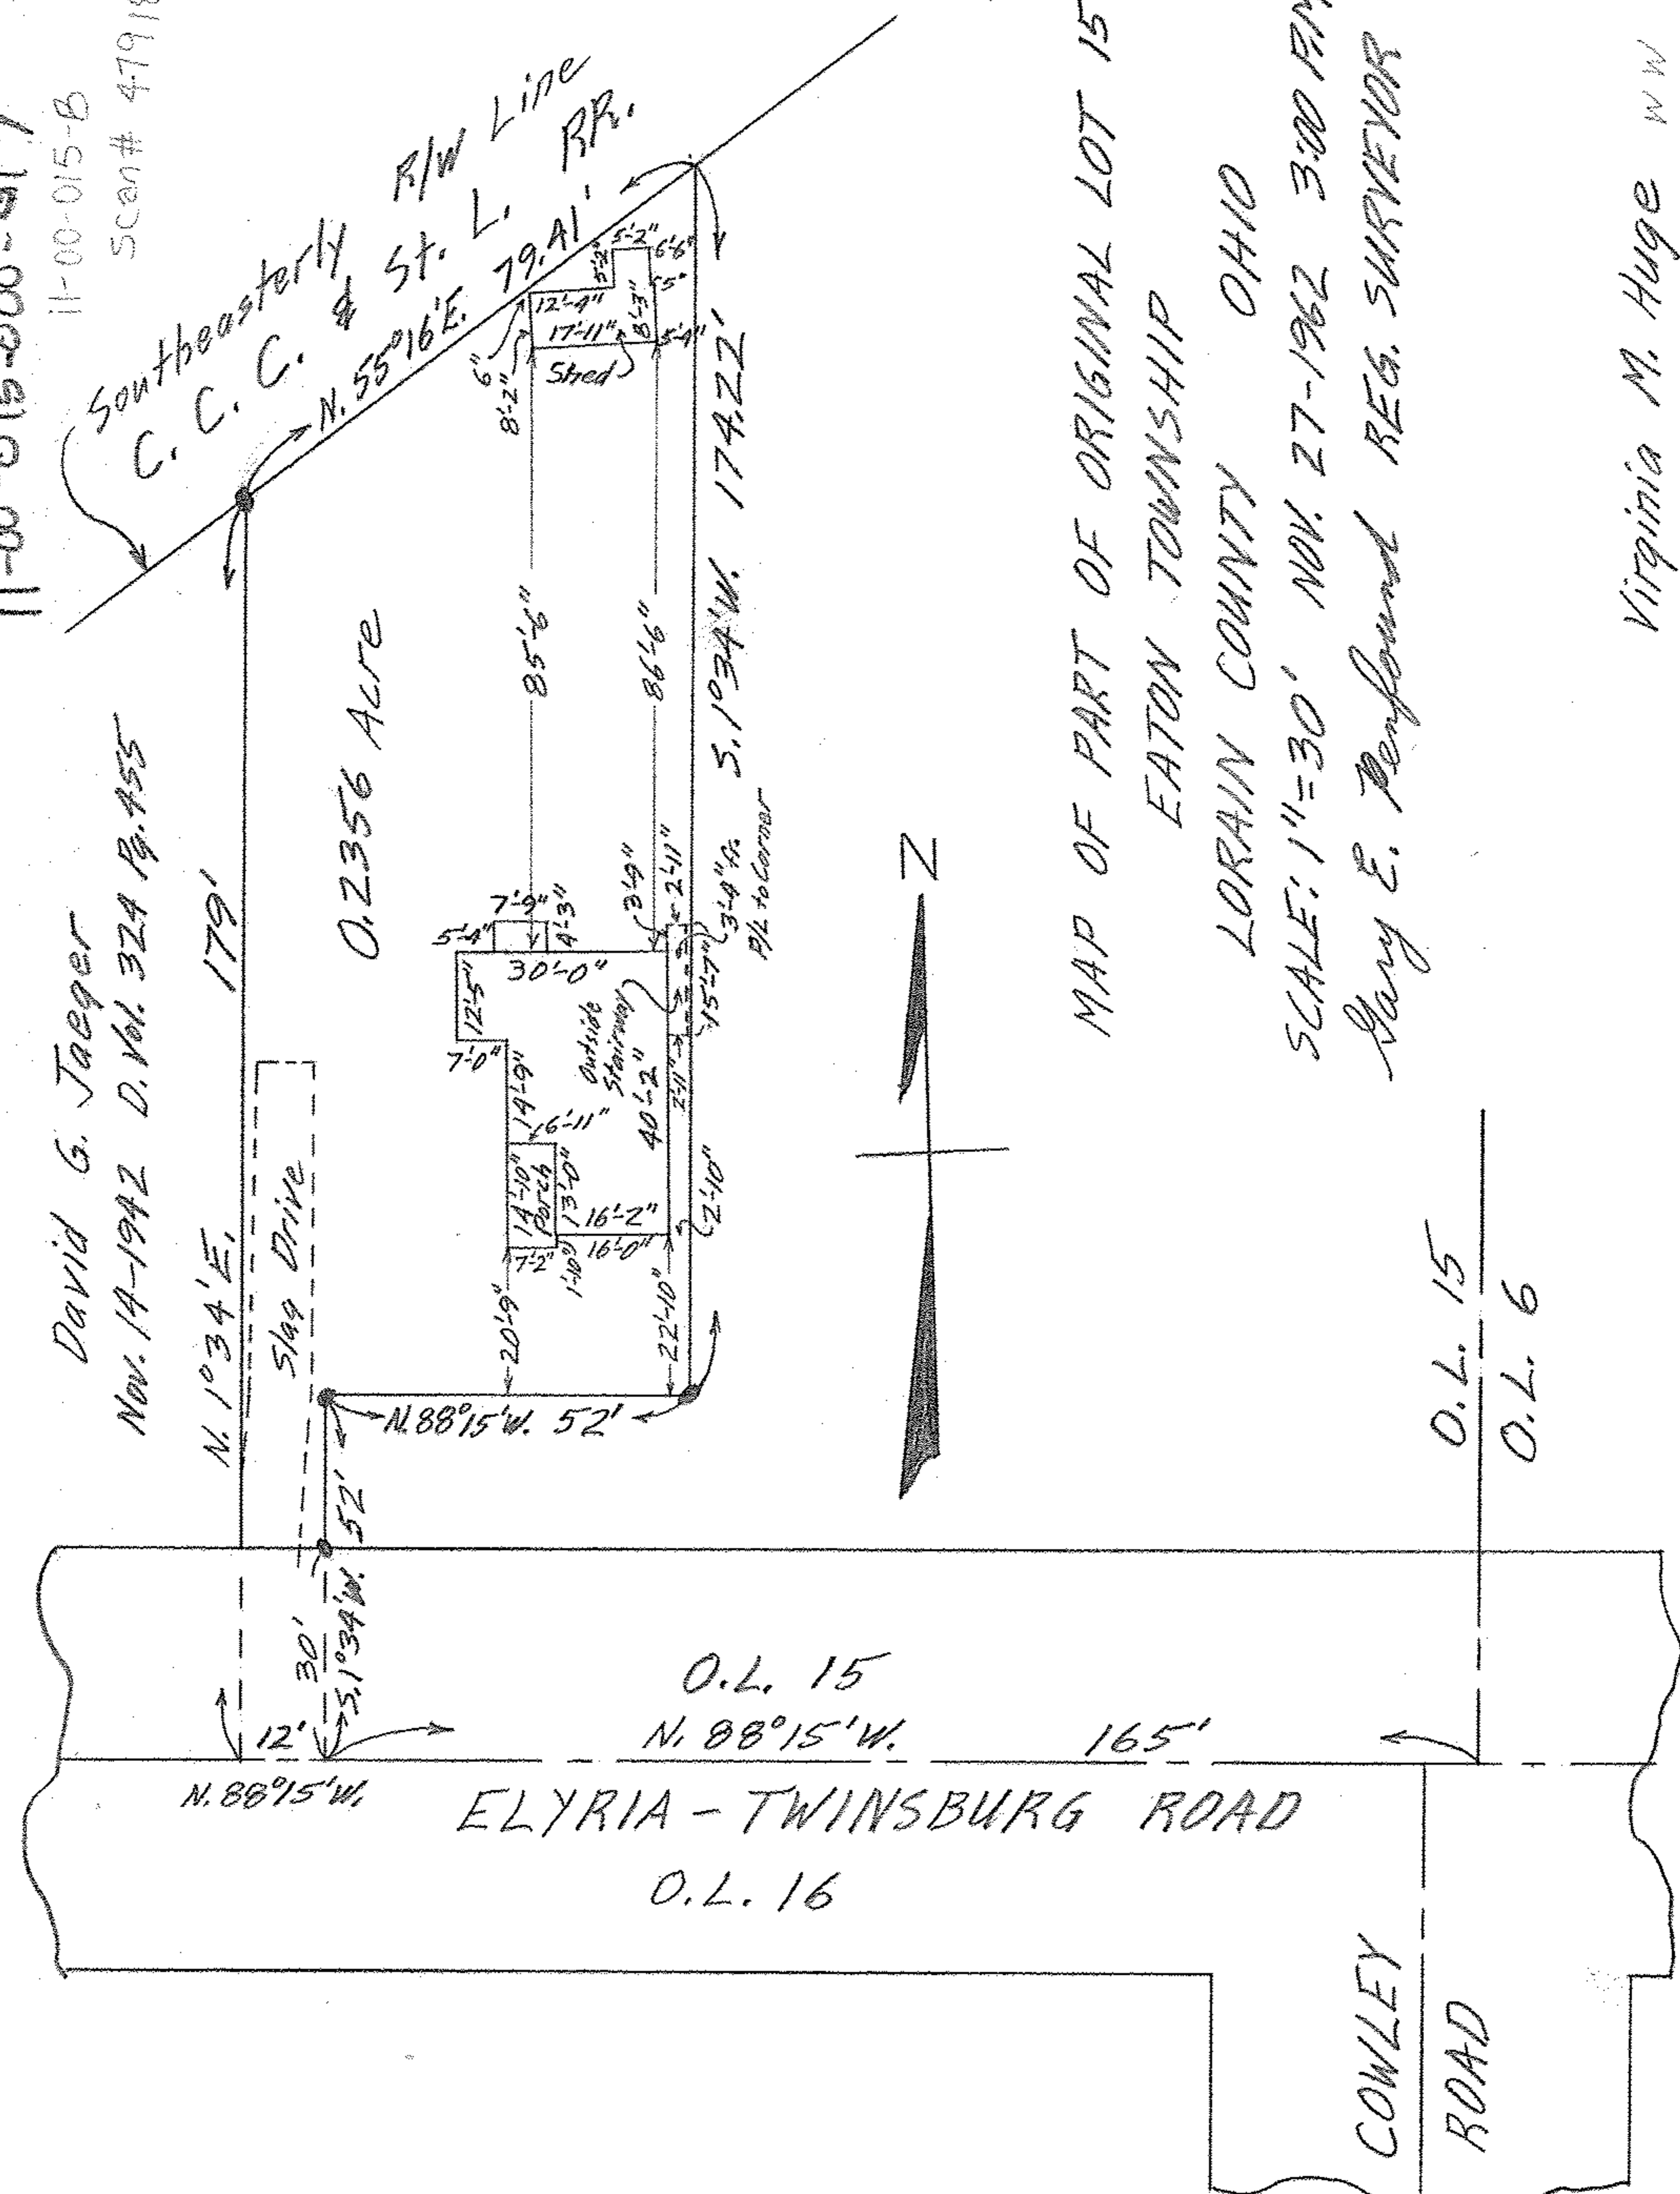

MAP OF PART OF ORIGINAL LOT 15
EATON TOWNSHIP
LORAIN COUNTY OHIO
SCALE: 1"=30' NOV. 27-1962 3:00 P.M.
Gary E. Penfound REG. SURVEYOR

O.L. 15
O.L. 16

Virginia M. Huger W.W.