


11-00-016-000-805

11-00-016-A

SCAN # 47919

Southeasterly Right-of-Way Line
of C.C.C. & St. L. RR. (now
New York Central RR.)

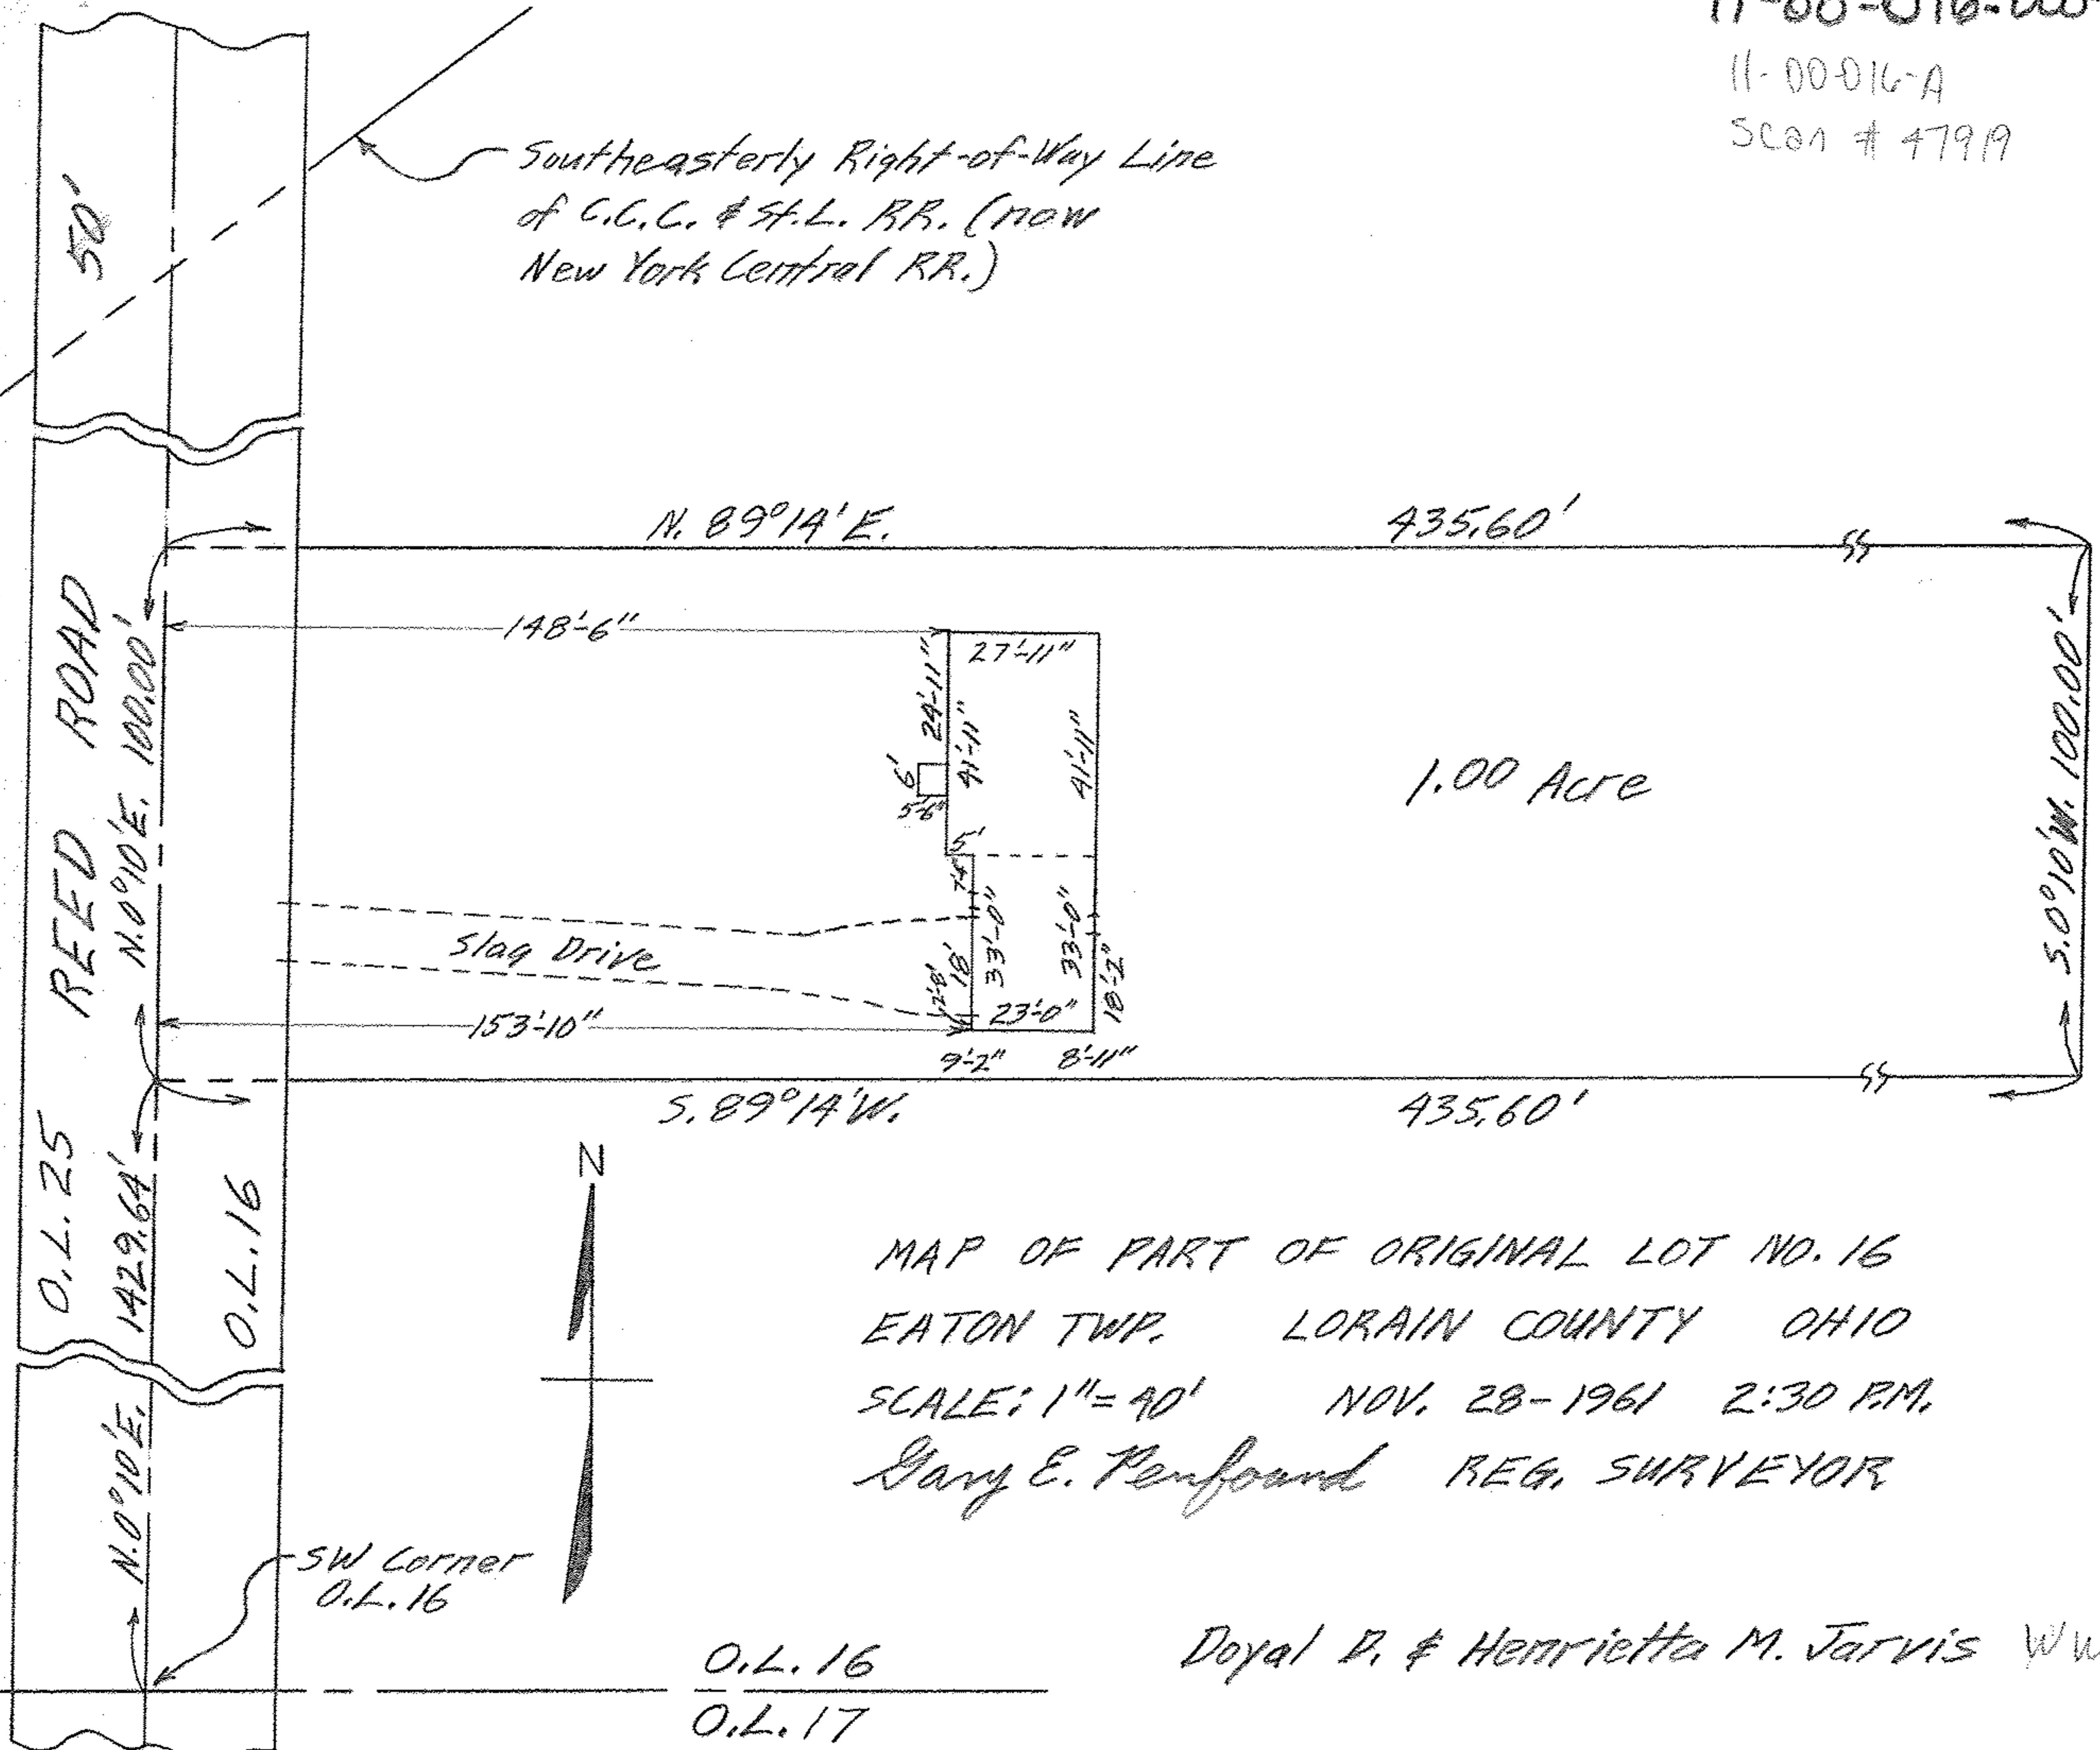

1.00 Acre



MAP OF PART OF ORIGINAL LOT NO. 16
 EATON TWP. LORAIN COUNTY OHIO
 SCALE: 1" = 40' NOV. 28-1961 2:30 P.M.
 Gary E. Penfound REG. SURVEYOR

SW Corner
O.L. 16

O.L. 16
O.L. 17

Doyal D. & Henrietta M. Jarvis WW