


11-B-827.000-002

11-00-027-A

Scan # 47922

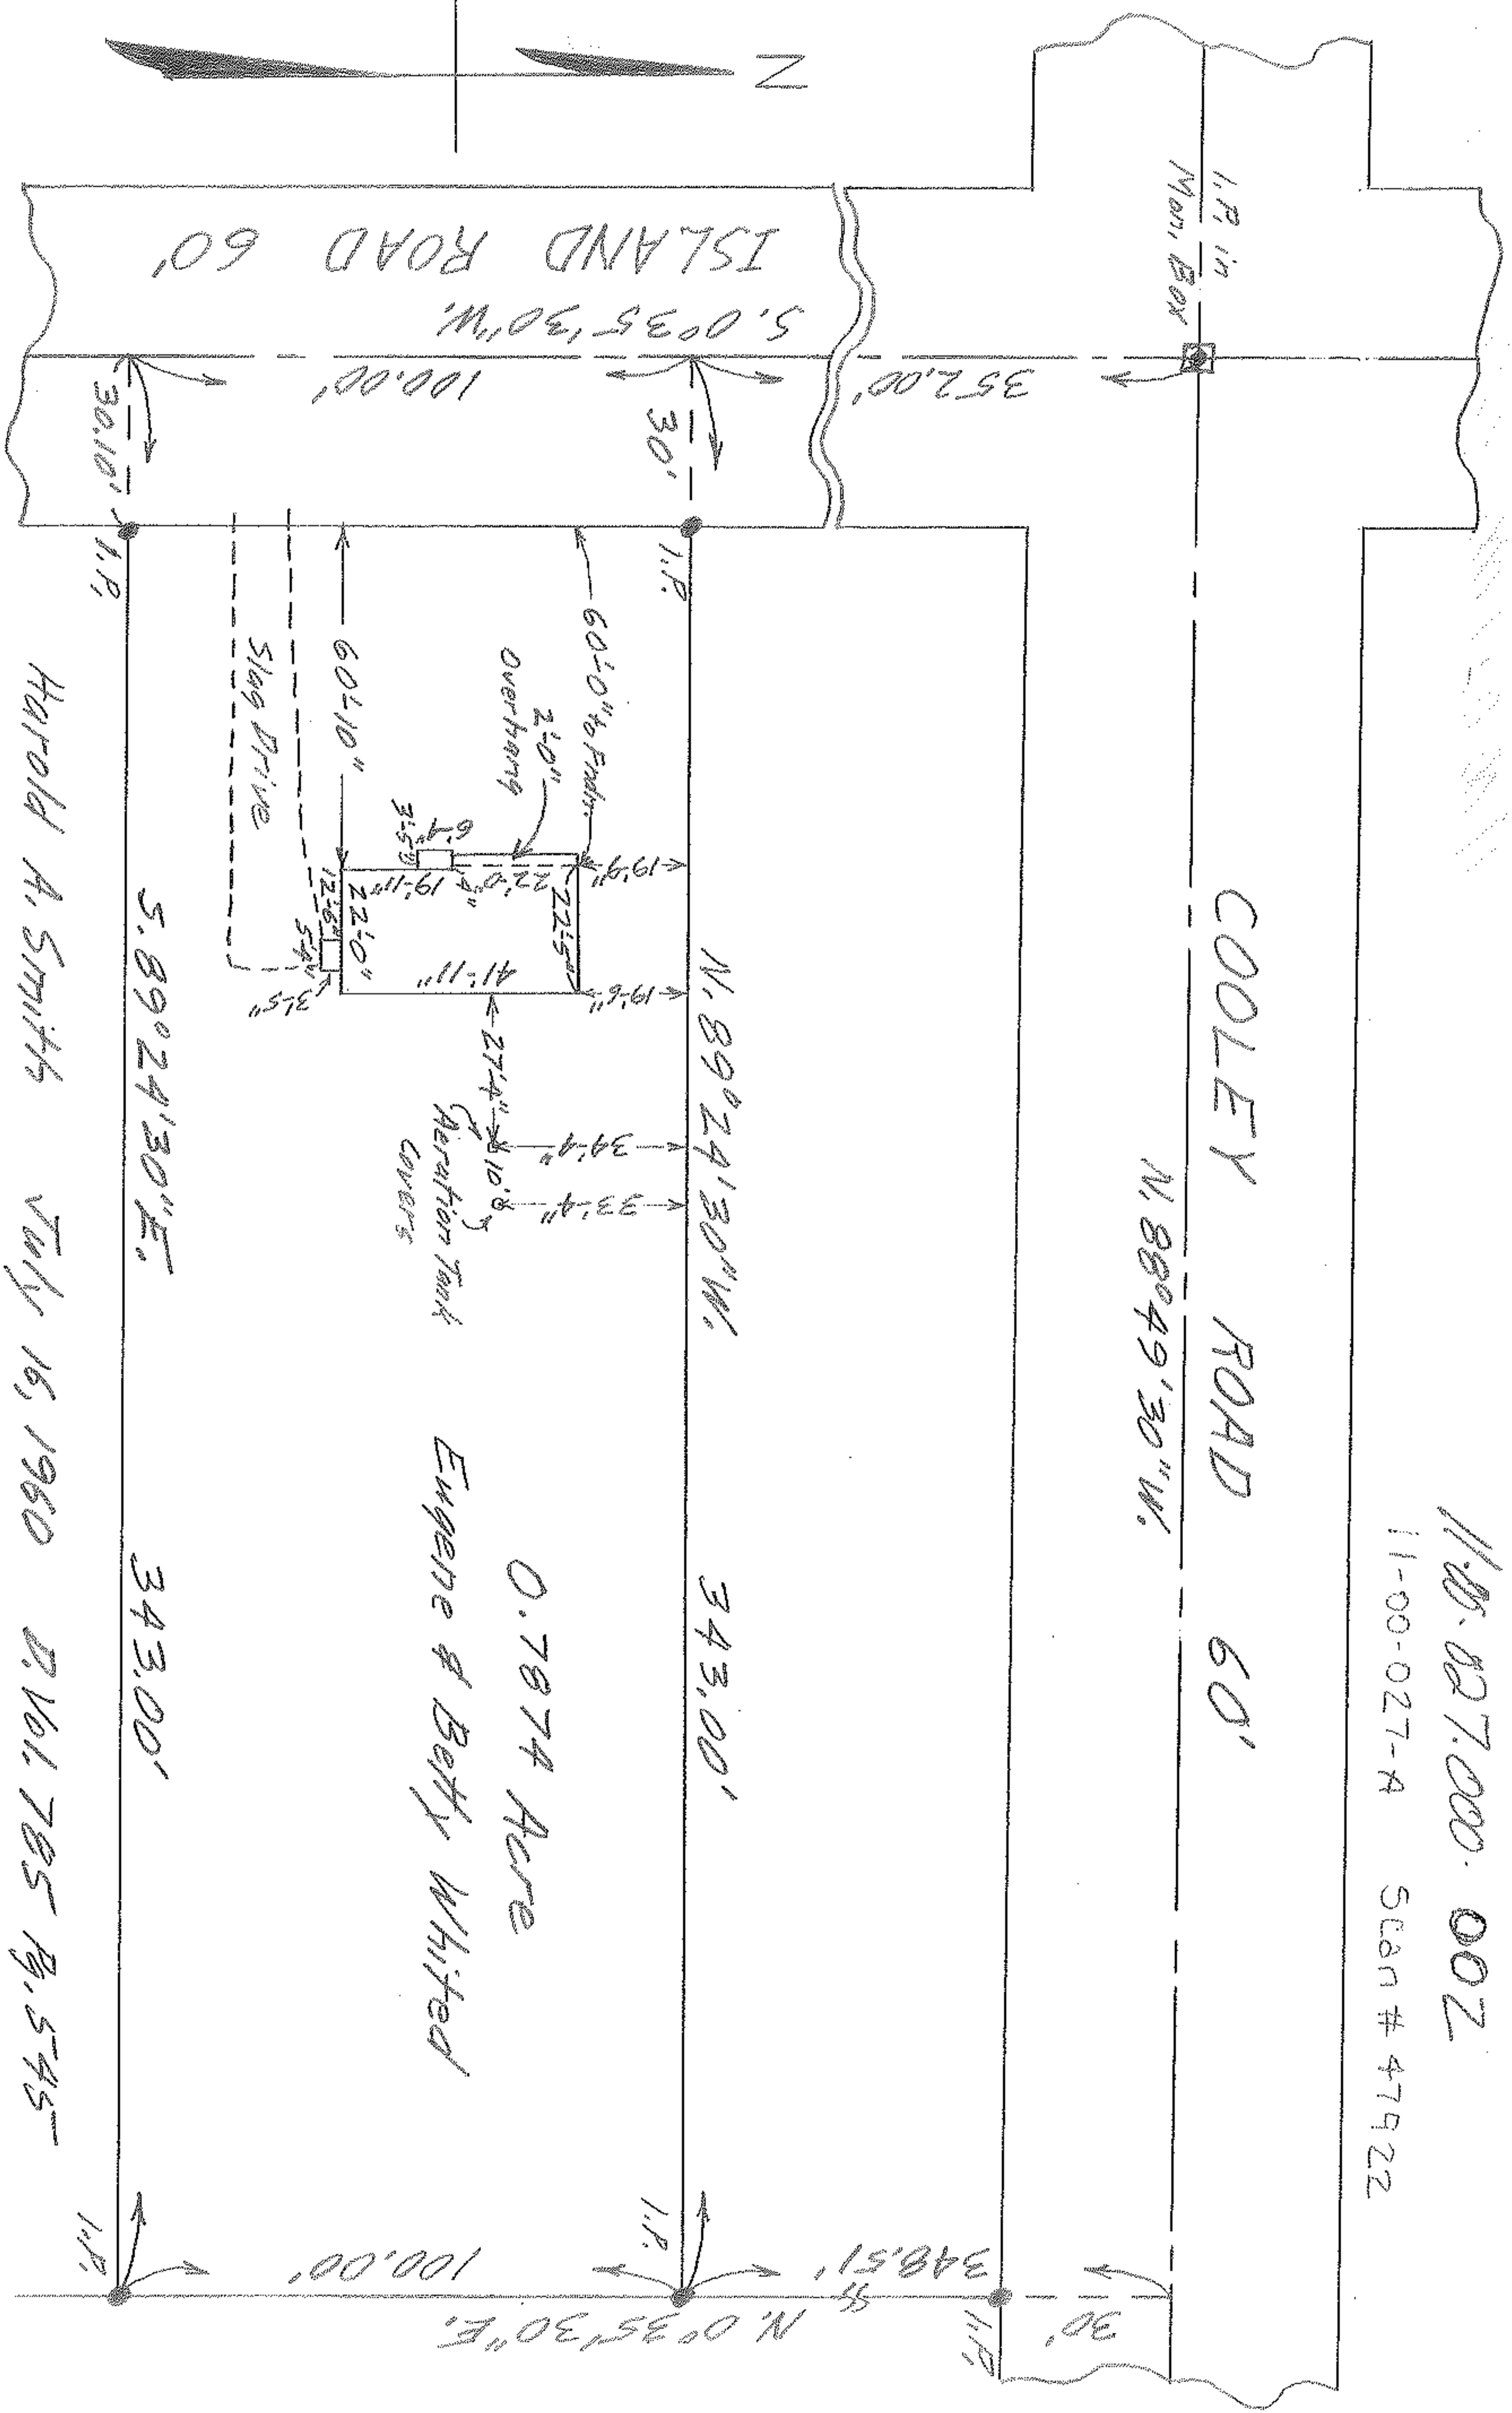

MAP OF SURVEY OF PART OF ORIG. LOT NO. 27  
 EATON TOWNSHIP - LORAIN COUNTY - OHIO  
 SCALE: 1" = 40'  
 APRIL 18-1963 6:00 PM.  
 Guy E. Mansford REG. SURVEYOR NO. 4457

Harold A. Smith July 16, 1960 D. Vol. 785 P. 545

0.7874 Acre  
 Eugene & Betty Whitford