



11-00-036-0

11-00-036-112-010

MAP OF PART OF ORIGINAL LOT NO. 36  
 EATON TWP. - LORAIN COUNTY - OHIO  
 SCALE: 1" = 30' SEPT. 4 - 1964 7:15 P.M.  
 Gary E. Penfound REG. SURVEYOR

Walter & Grace L. Slimbariski

E ELYRIA - TWINSBURG RD.  
 Northeast Corner O.L. 36

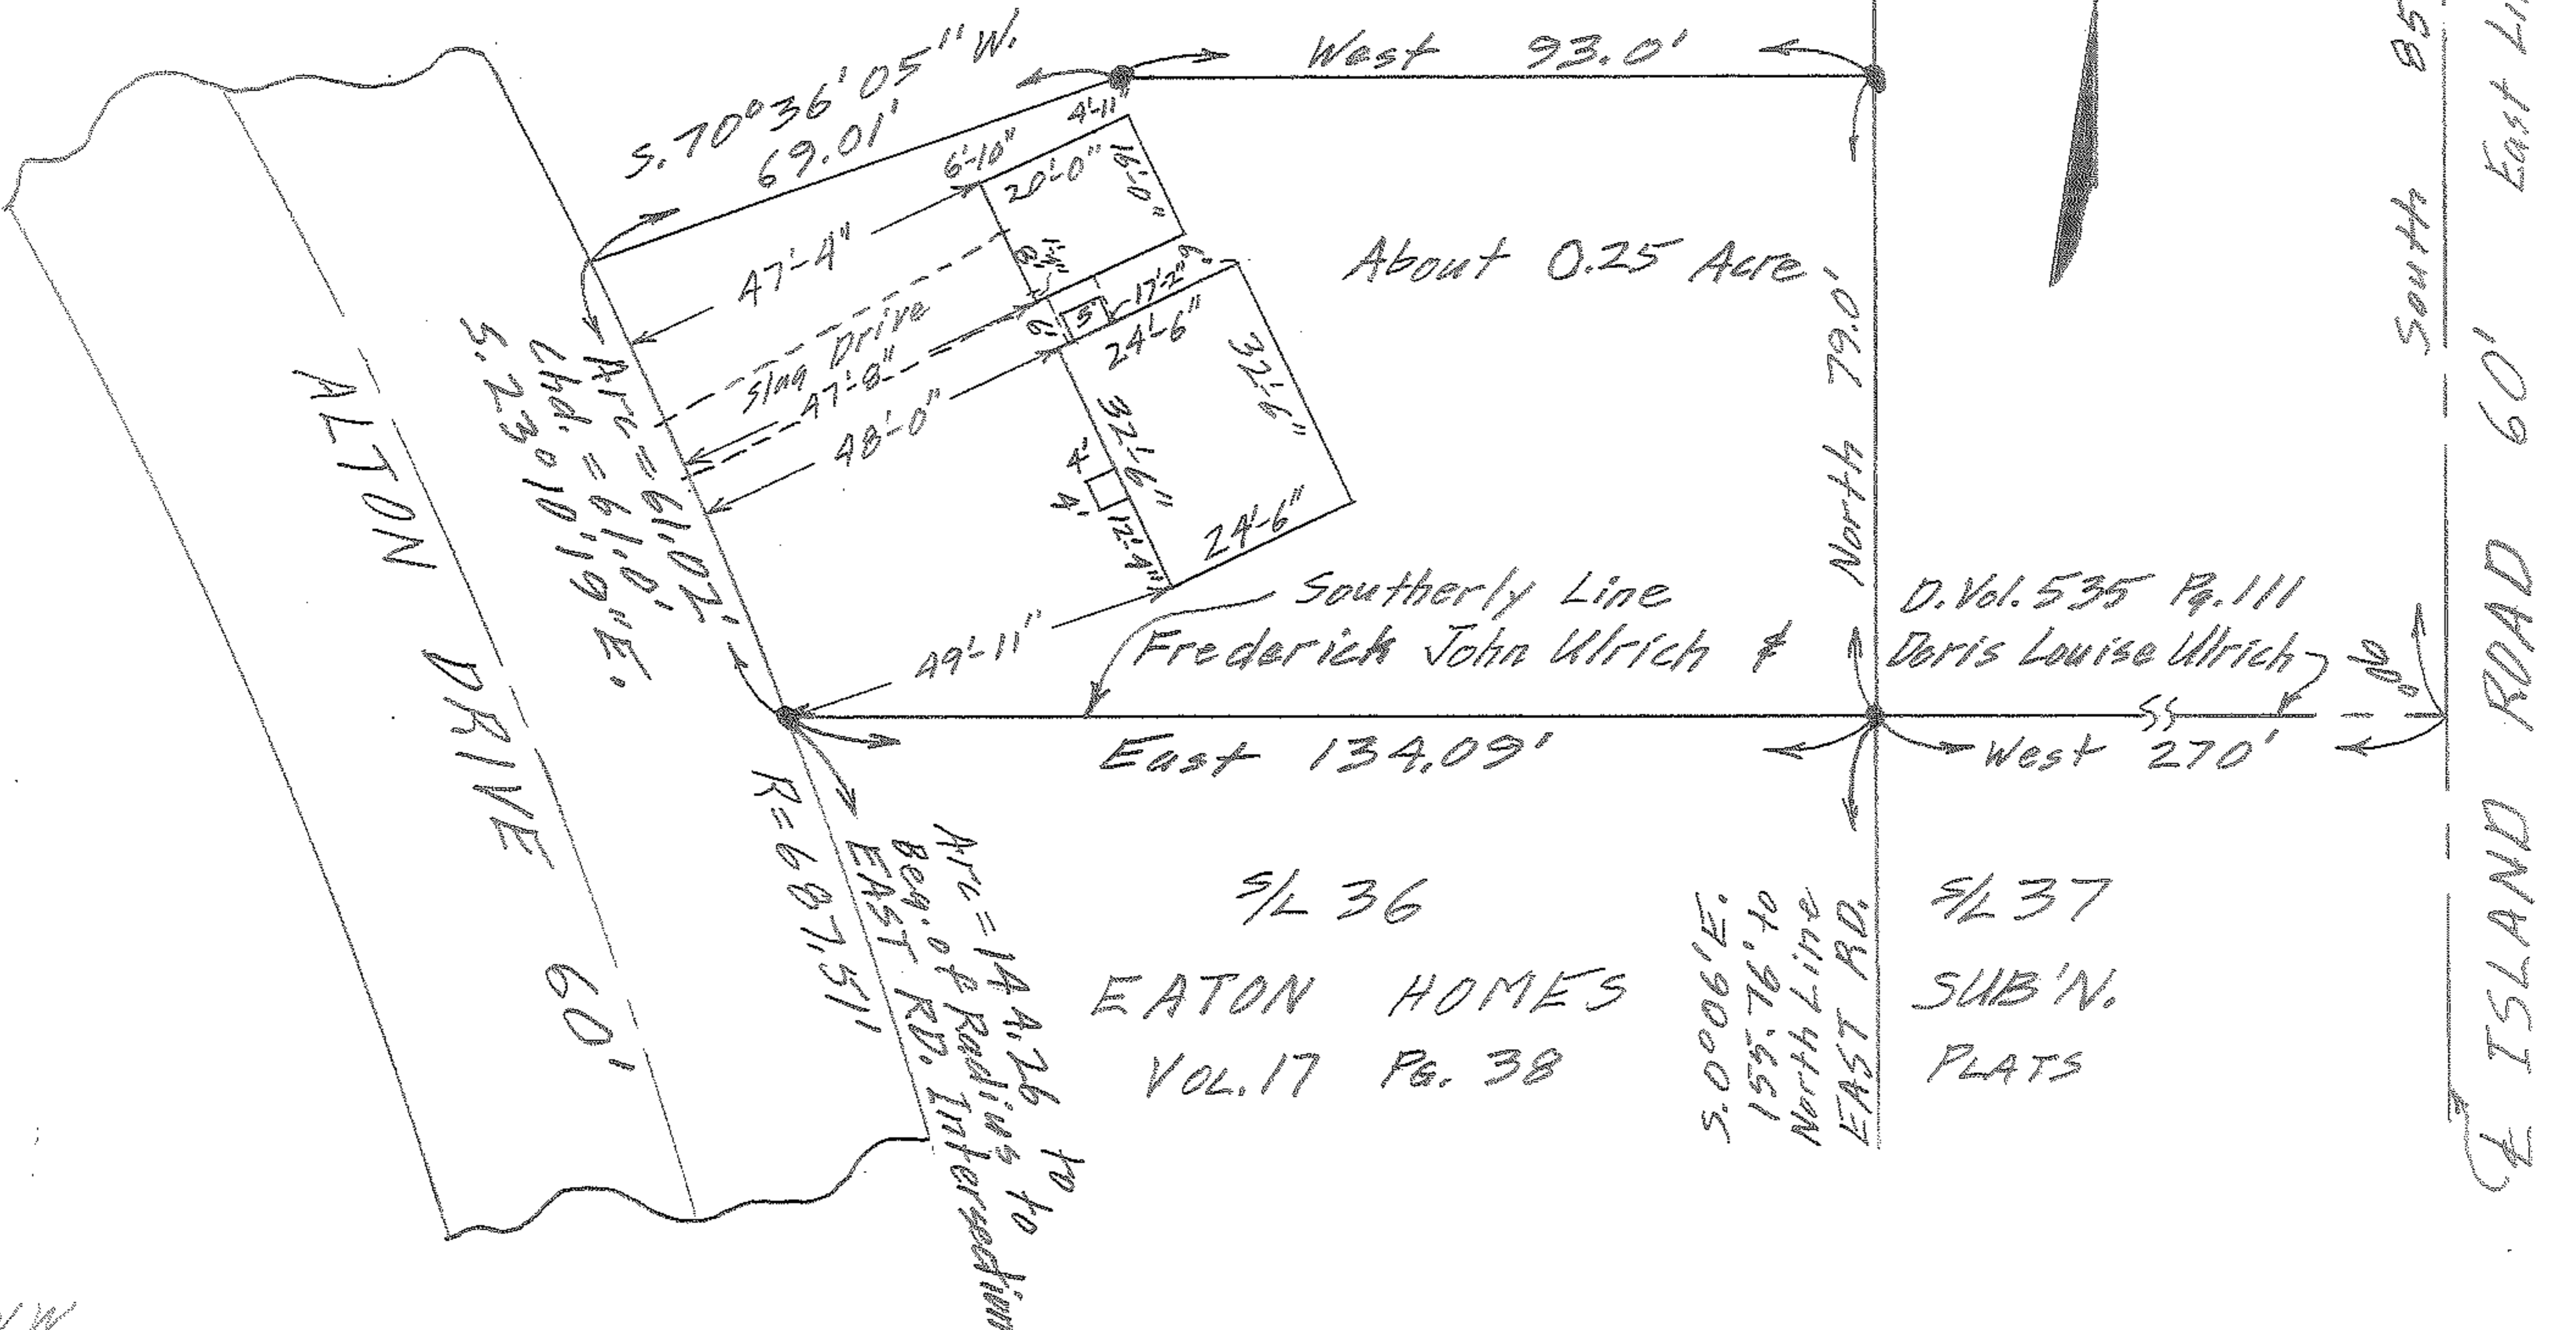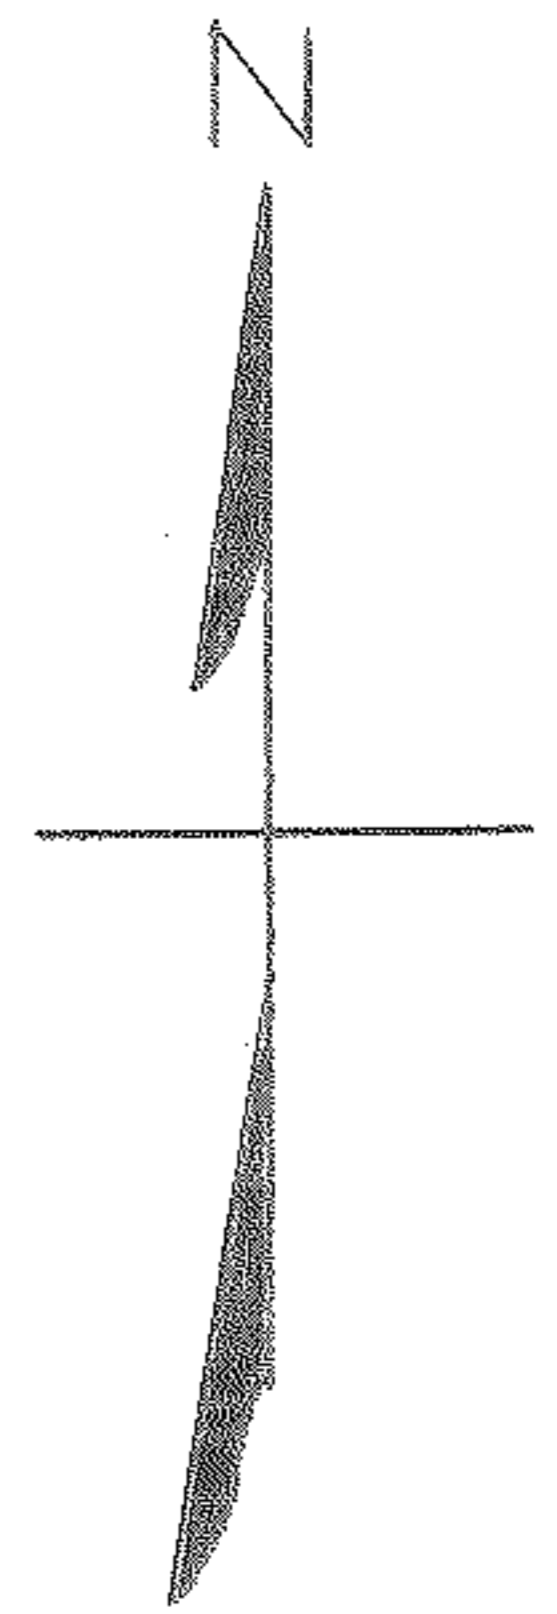

WW