


FENCE ENCROACHMENT DETAIL - SCALE: 1" = 30'

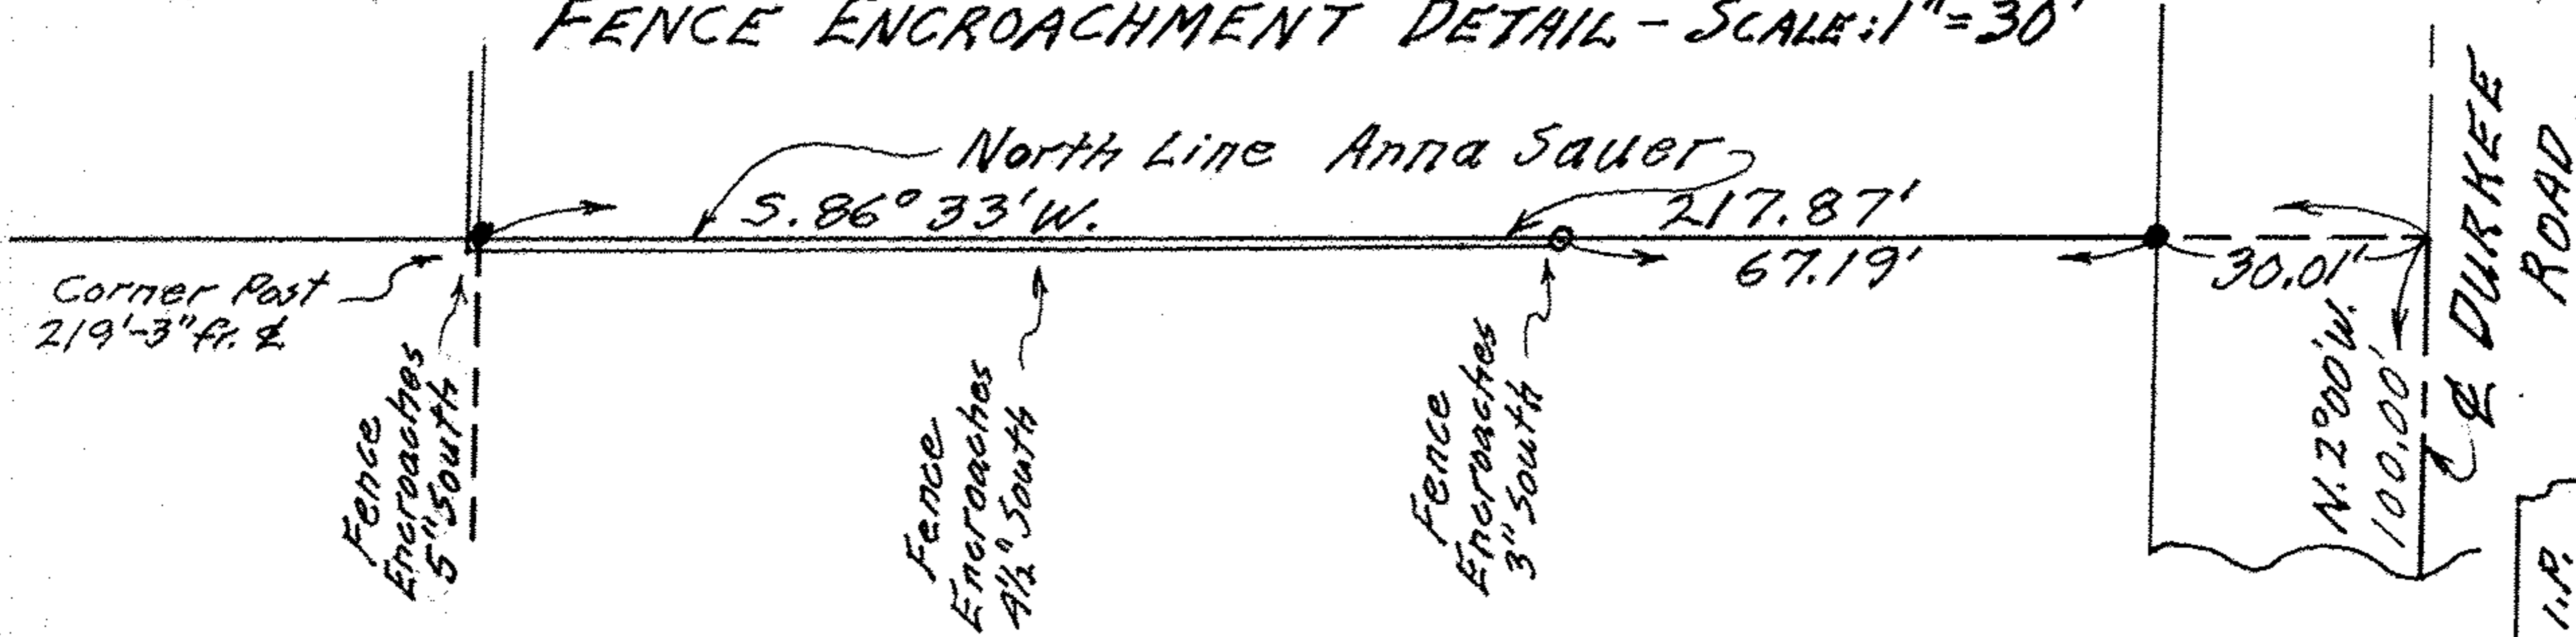

PLAT OF SURVEY AND FENCE LOCATION FOR
MRS. ANNA SAUER

ORIGINAL LOT NO. 85 EATON TOWNSHIP
LORAIN COUNTY OHIO
SCALE: 1" = 100' JULY 19-25, 1980


Gary E. Penfound Reg. Surveyor No. 4457

NOTES: ● indicates iron pin found or replaced.
○ indicates additional iron pin set.

John W. & Helen K. Walton
D. Vol. 919 Pg. 305

Anna Sauer C/T Vol. 1142 Pg. 399

Gary J. & Anna R. Sauer D. Vol. 1061 Pg. 501 Pl. #2 Pch. No. 1

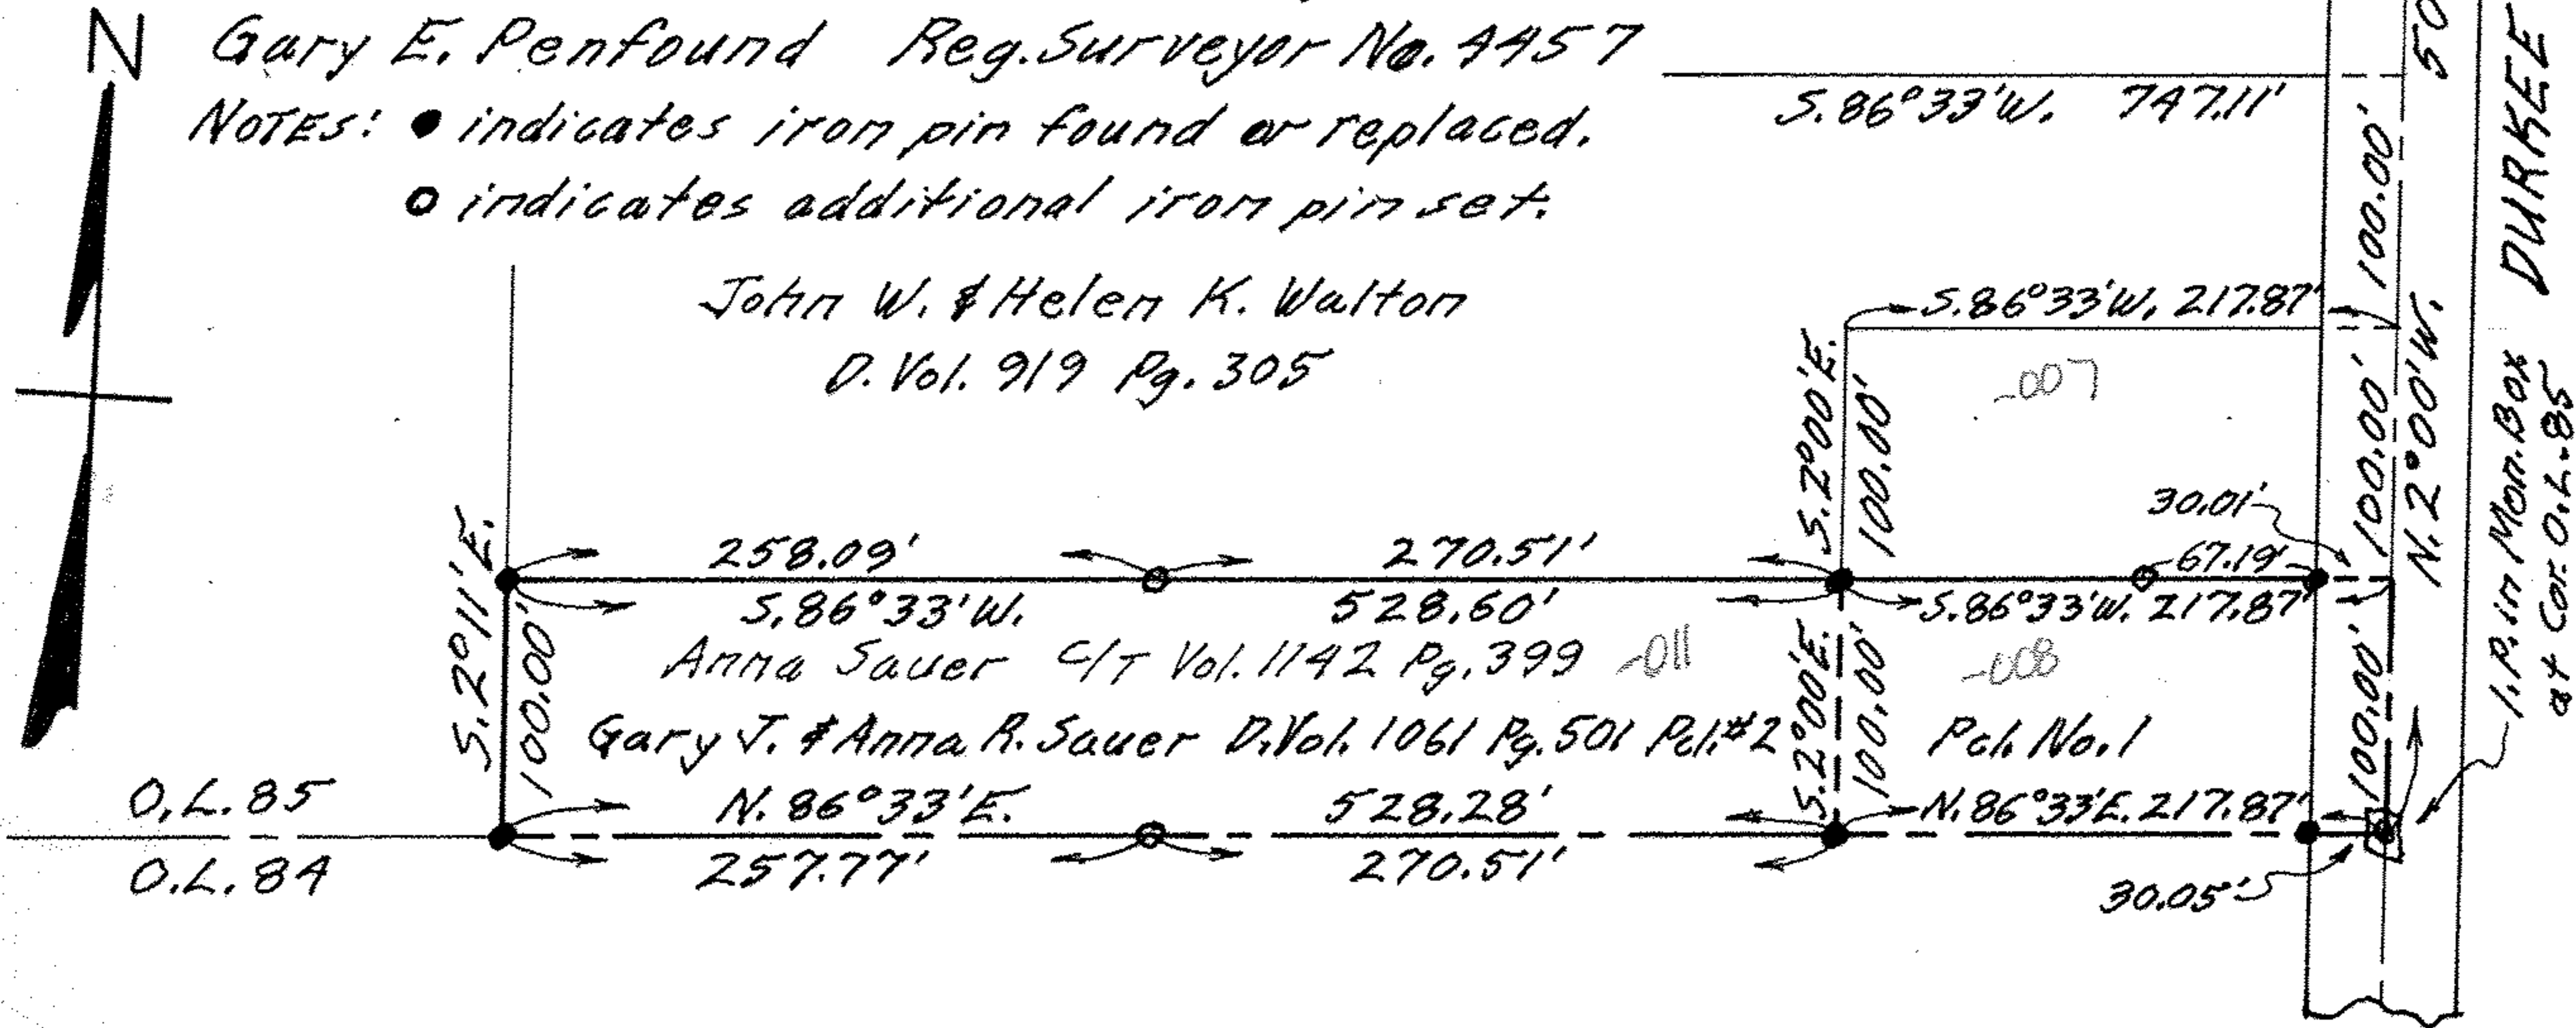

11.00.095.000.007,008,011
11-E North
Scan # 47990