

200.10.010.1

11.00.100.101.008

Scan # 48014


PLAT OF SURVEY FOR ARNOLD BUCHHOLZ AND THE ESTATE OF HUGO BUCHHOLZ

ORIGINAL LOT NO. 100 EATON TWP,
GRAFTON VILLAGE
LORAIN COUNTY OHIO

SCALE: 1" = 100' APRIL - 1976

Gary E. Penfound Reg. Surveyor No. 4457

- NOTES:
- indicates iron pin found.
 - indicates iron pin set unless otherwise designated.

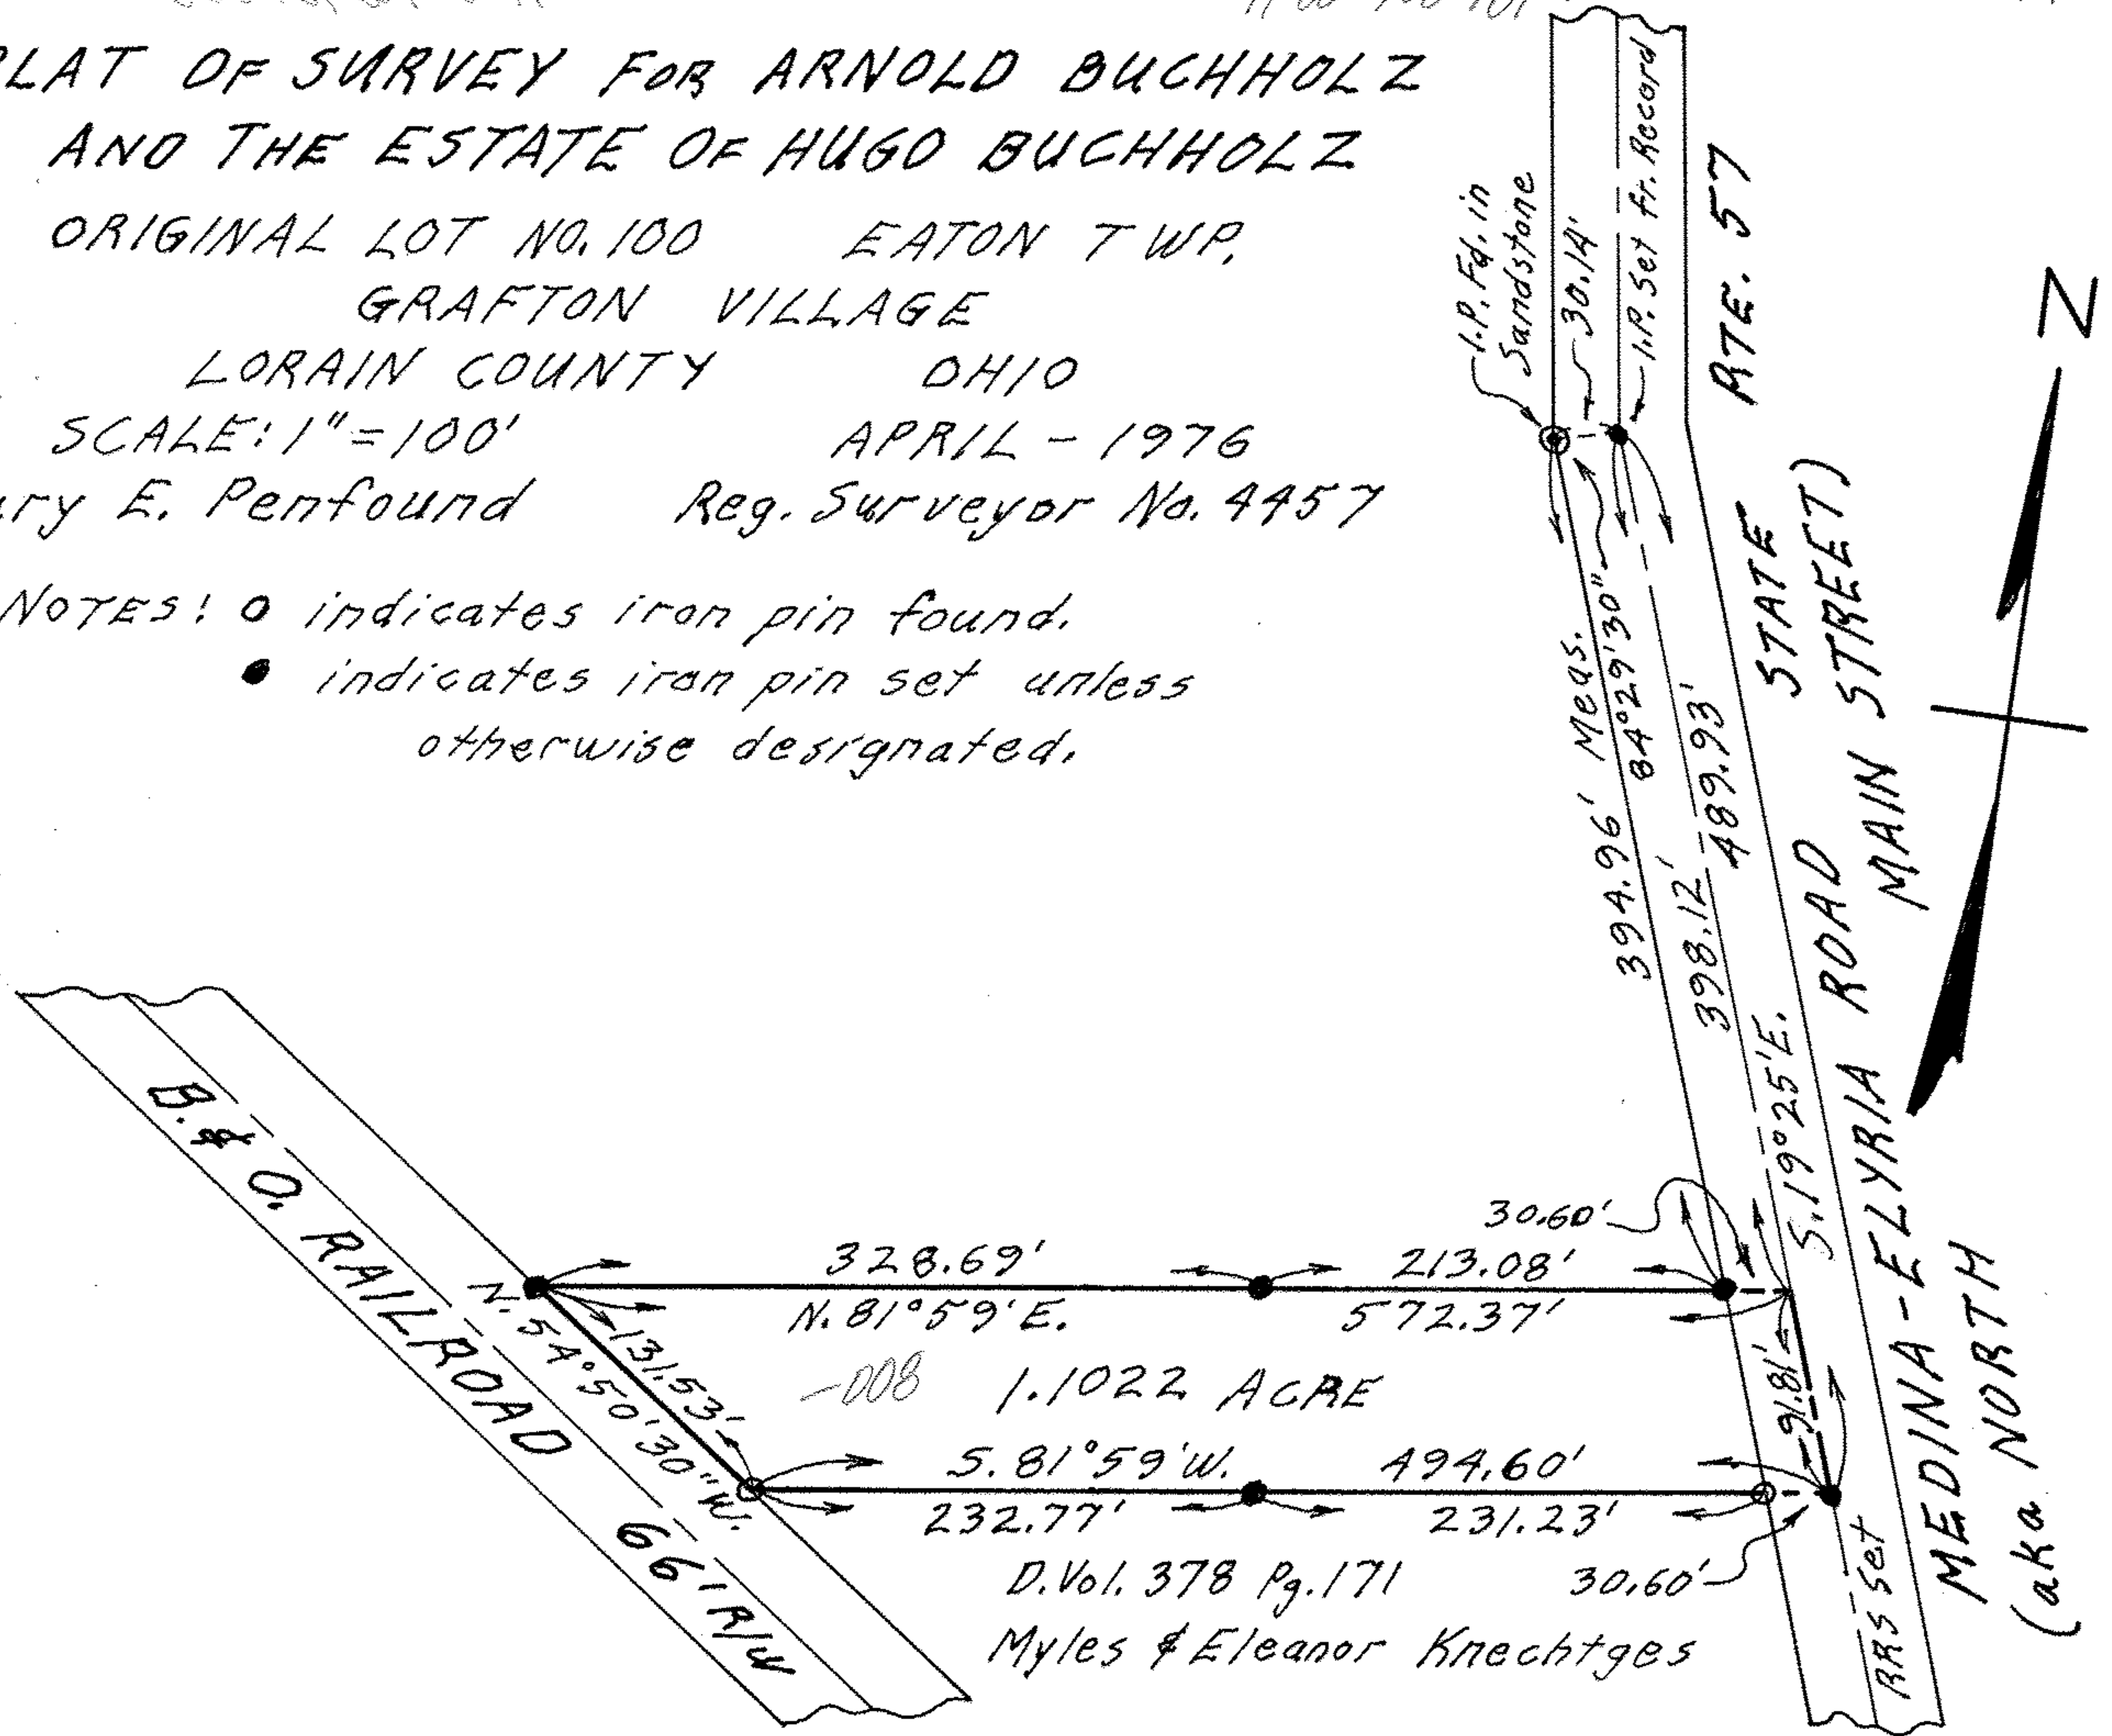

1.1022 ACRE

D. Vol. 378 Pg. 171

Myles & Eleanor Knechtges

ATE. 57

STATE STREET

ELYRIA ROAD MAIN STREET

MEDINA-NORTH (aka NORTH)