


12-00-001-000-

20149

12-00-001-B

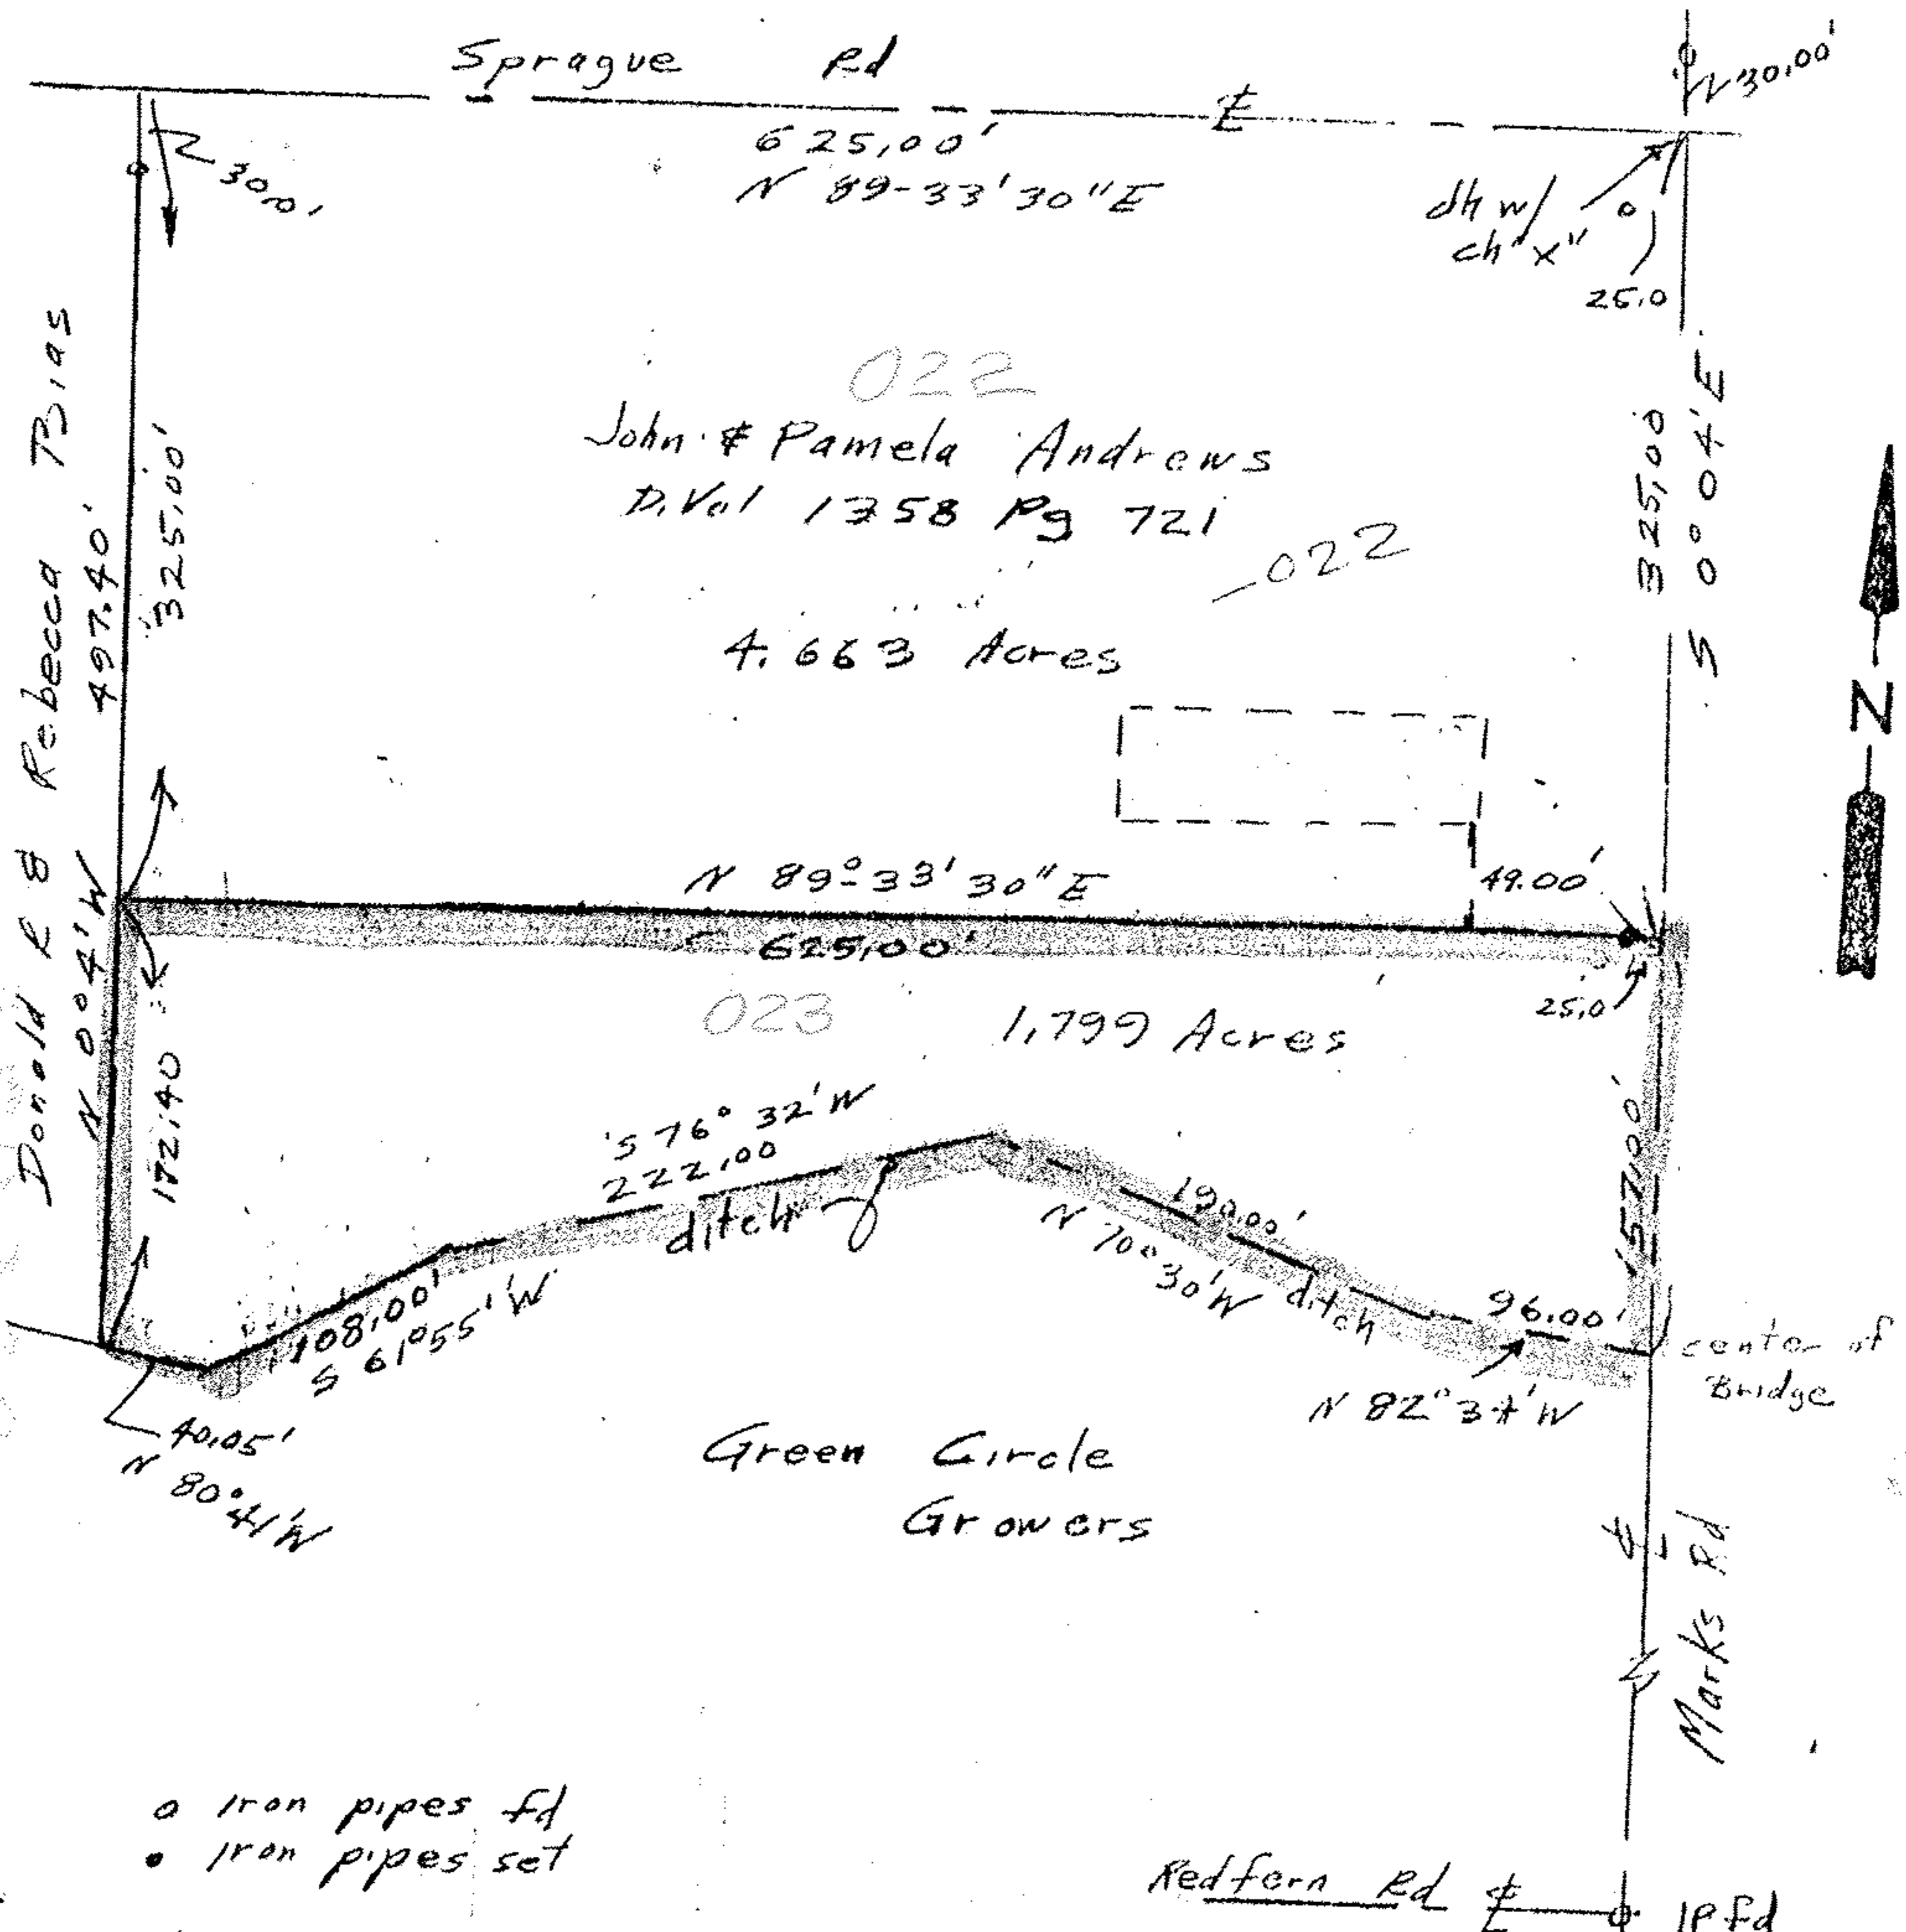

- o iron pipes fd
- iron pipes set

John Pozywak
 Registered Professional Surveyor
 STATE OF OHIO
 JOHN POZYWAK
 5292
 REGISTERED SURVEYOR

Parcel Split Survey
 for John Andrews
 Part of Original Lot 1
 Columbia Township
 Lorain County Ohio
 Scale 1" = 100' Oct 1992
 Revised 10/28/92

20149

APPROVED	
LORAIN CO.	
MAP DEPT.	
DATE	11-17-92
PAGE	12-00-001 B
BY	CAROLYN FRANCIS
VOID AFTER	# 20149