


12-00-020-019 12-00-020-B scan # 48024

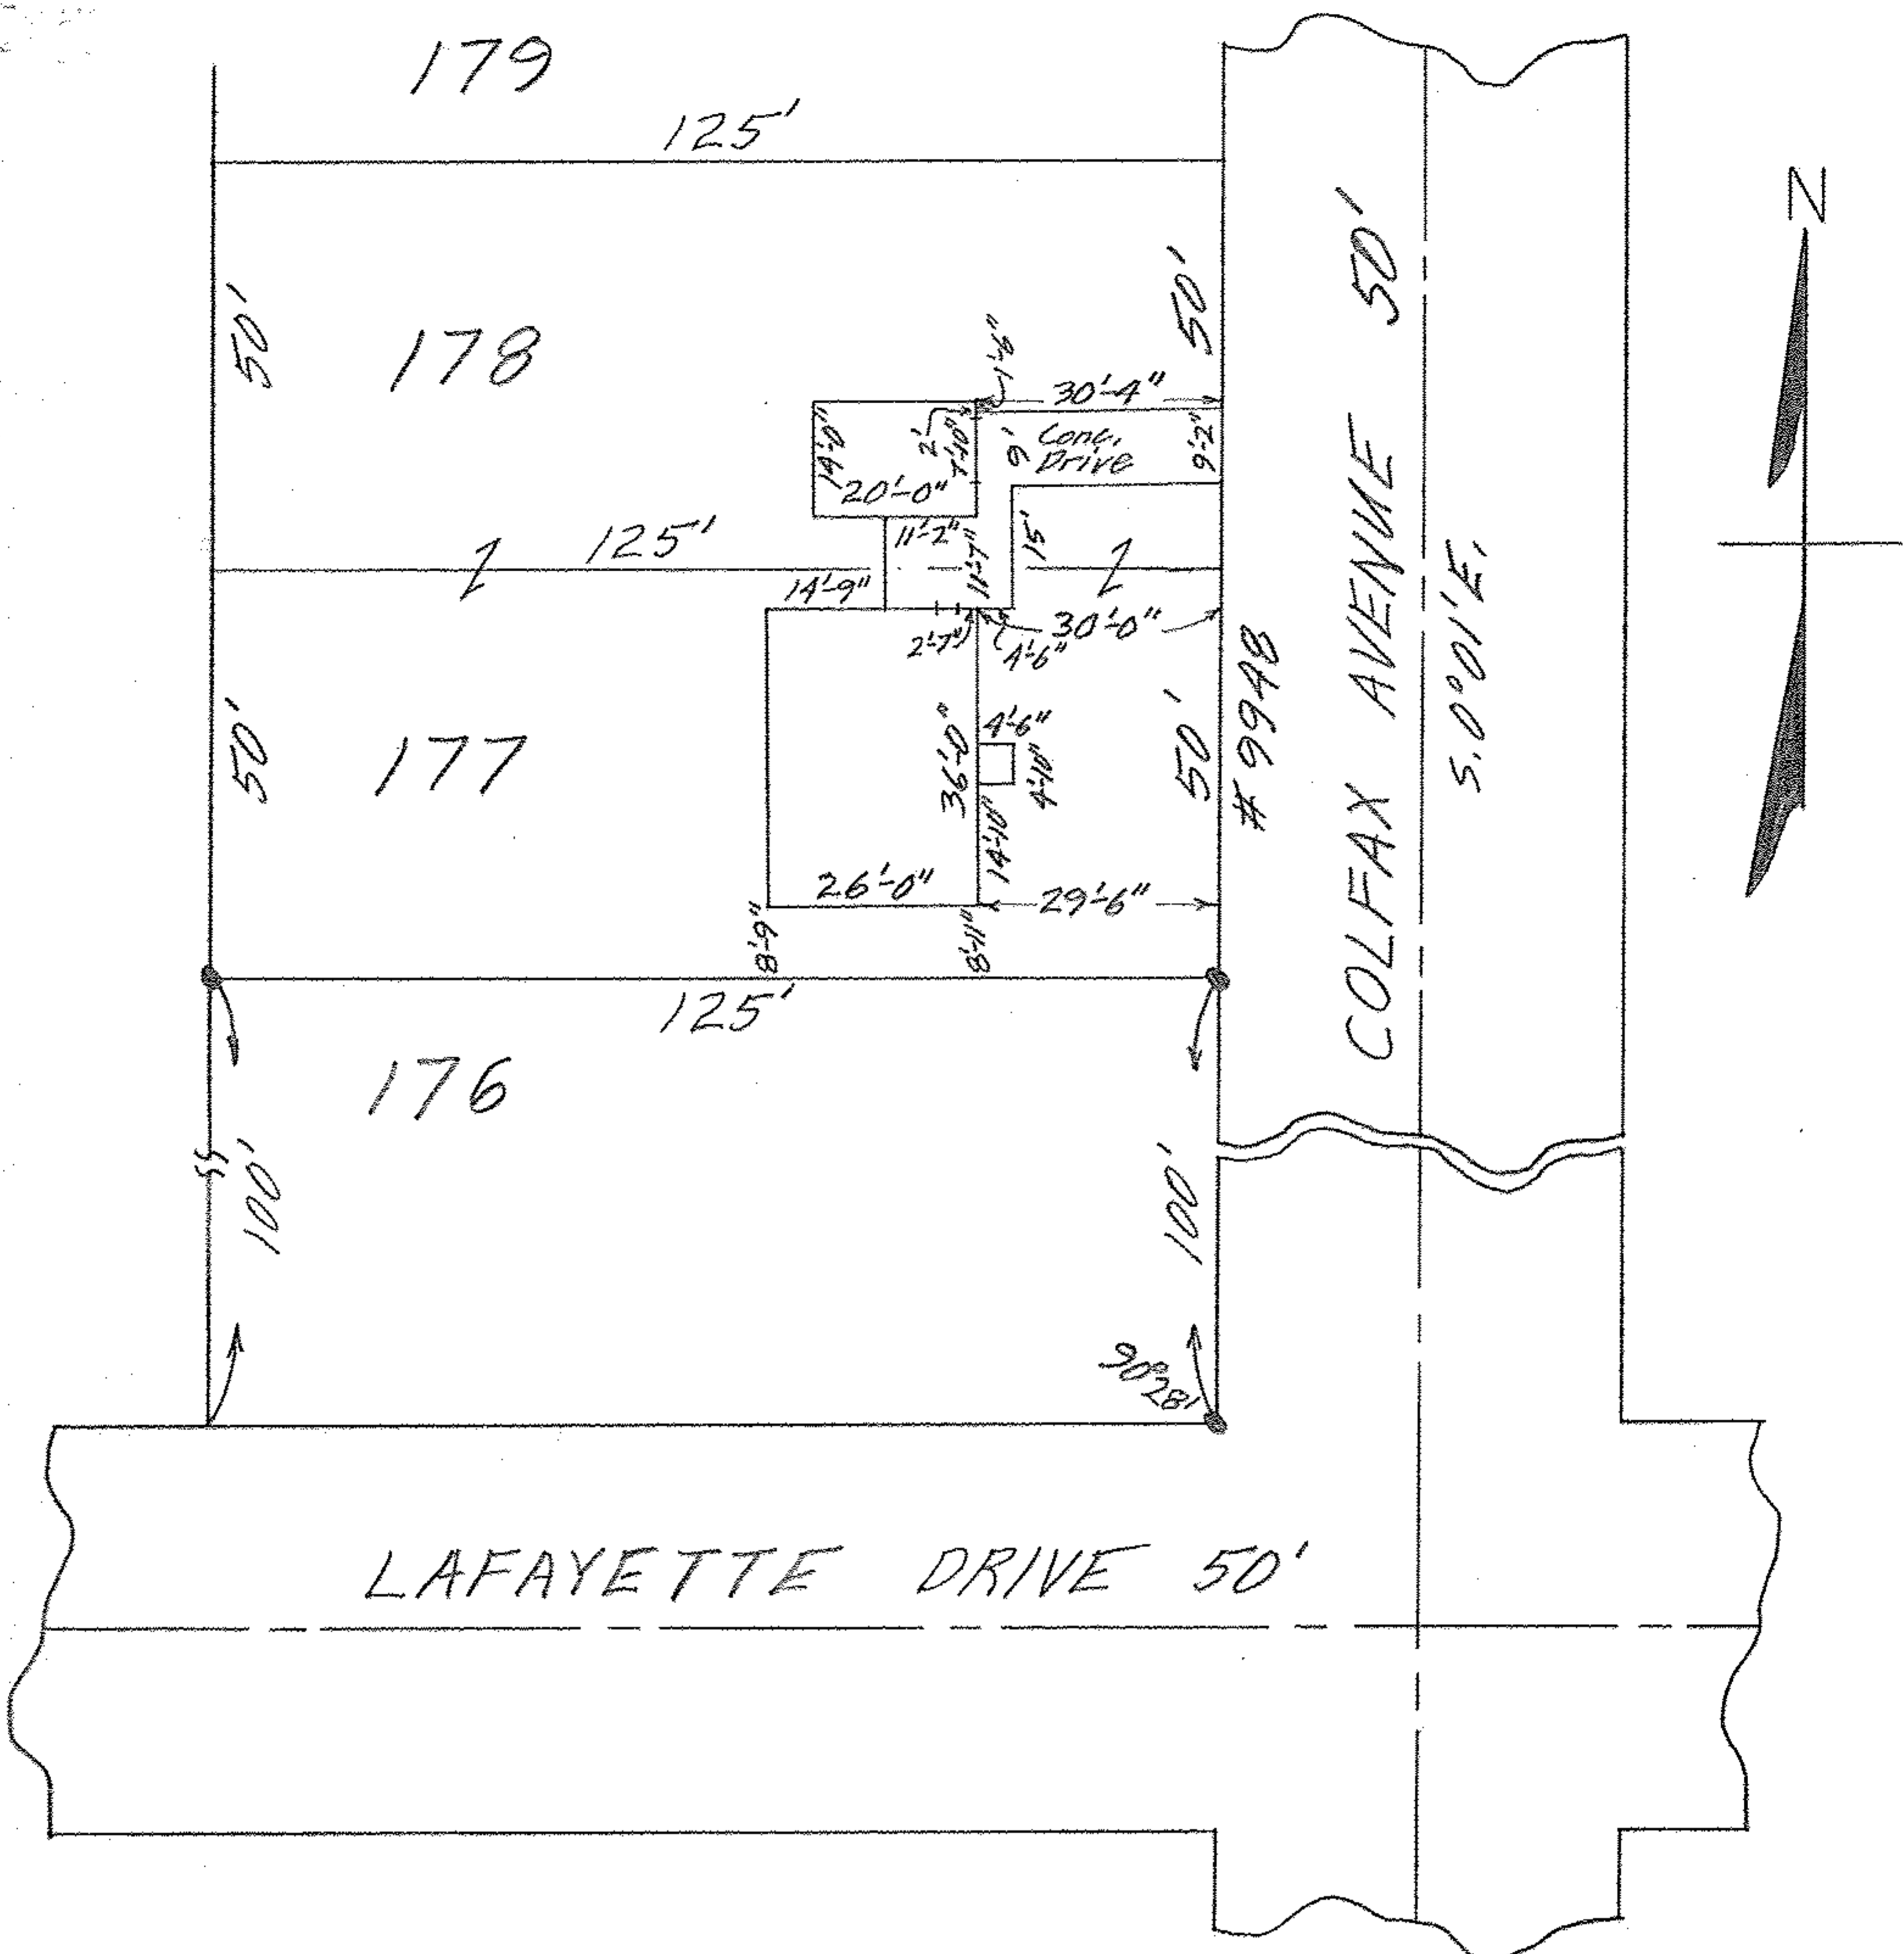

MAP OF SUB-LOTS 177 & 178
 WEST VIEW PARK VOL. 13 PG. 1 PLATS
 ORIG. LOT 20 COLUMBIA TWP.
 LORAIN COUNTY OHIO
 SCALE: 1" = 30' NOV. 16-1962 10:00 A.M.
 Gary E. Perfound REG. SURVEYOR

Robert E. Kilgore, Jr. WW