


12-00-034-000
SCAN# 40036 -052

#12279
APPROVED
LORAIN CO.
SHP DEPT.
12-6-78
12-6
T. McVain

MAP OF SURVEY FOR
FRANK J. & BETTY S. GRICAR
PART OF O.L. 33 COLUMBIA TWP,
LORAIN COUNTY, OHIO
NO SCALE SEPT. 1978

JOB NO. 1044
N

● INDICATES IRON PINS FOUND OR SET

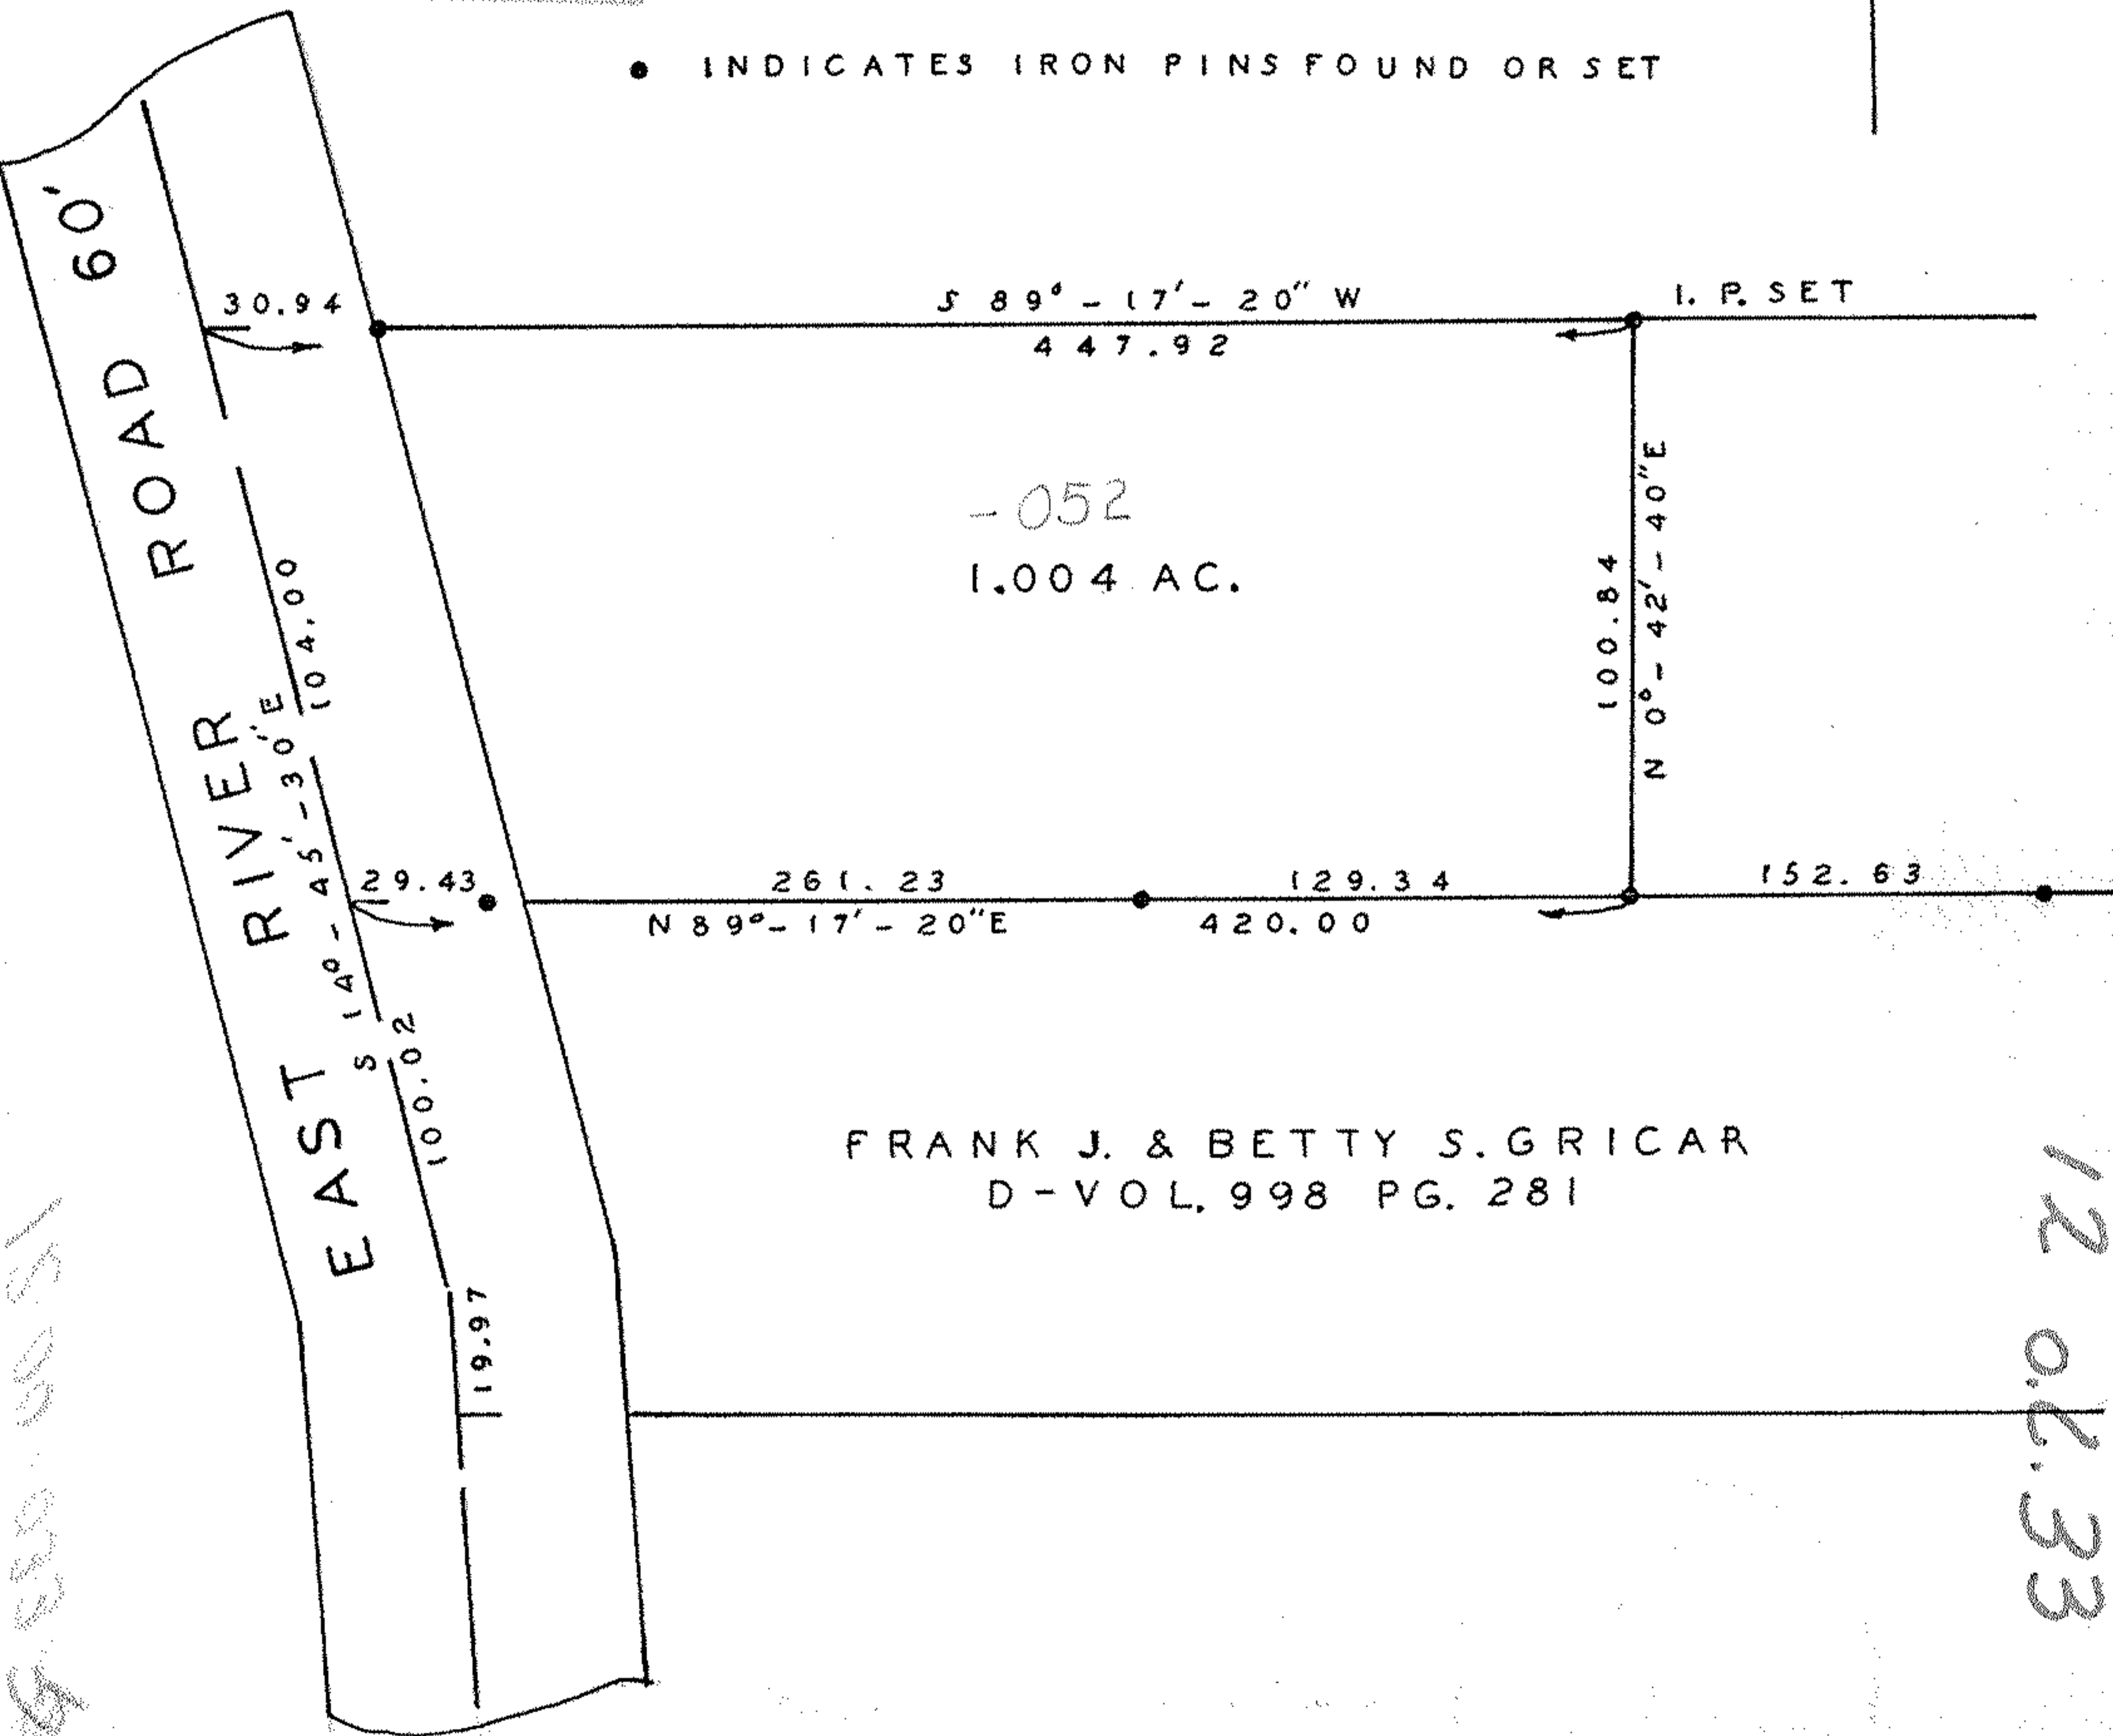

12-00-034-000

12 02.33