



Newton D. & Helen T. Reehorst
Plat Vol. 560, Page 27
N 89° 59' E

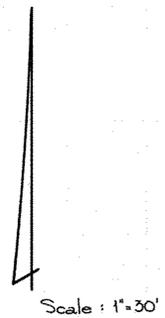

Scale: 1"=30'

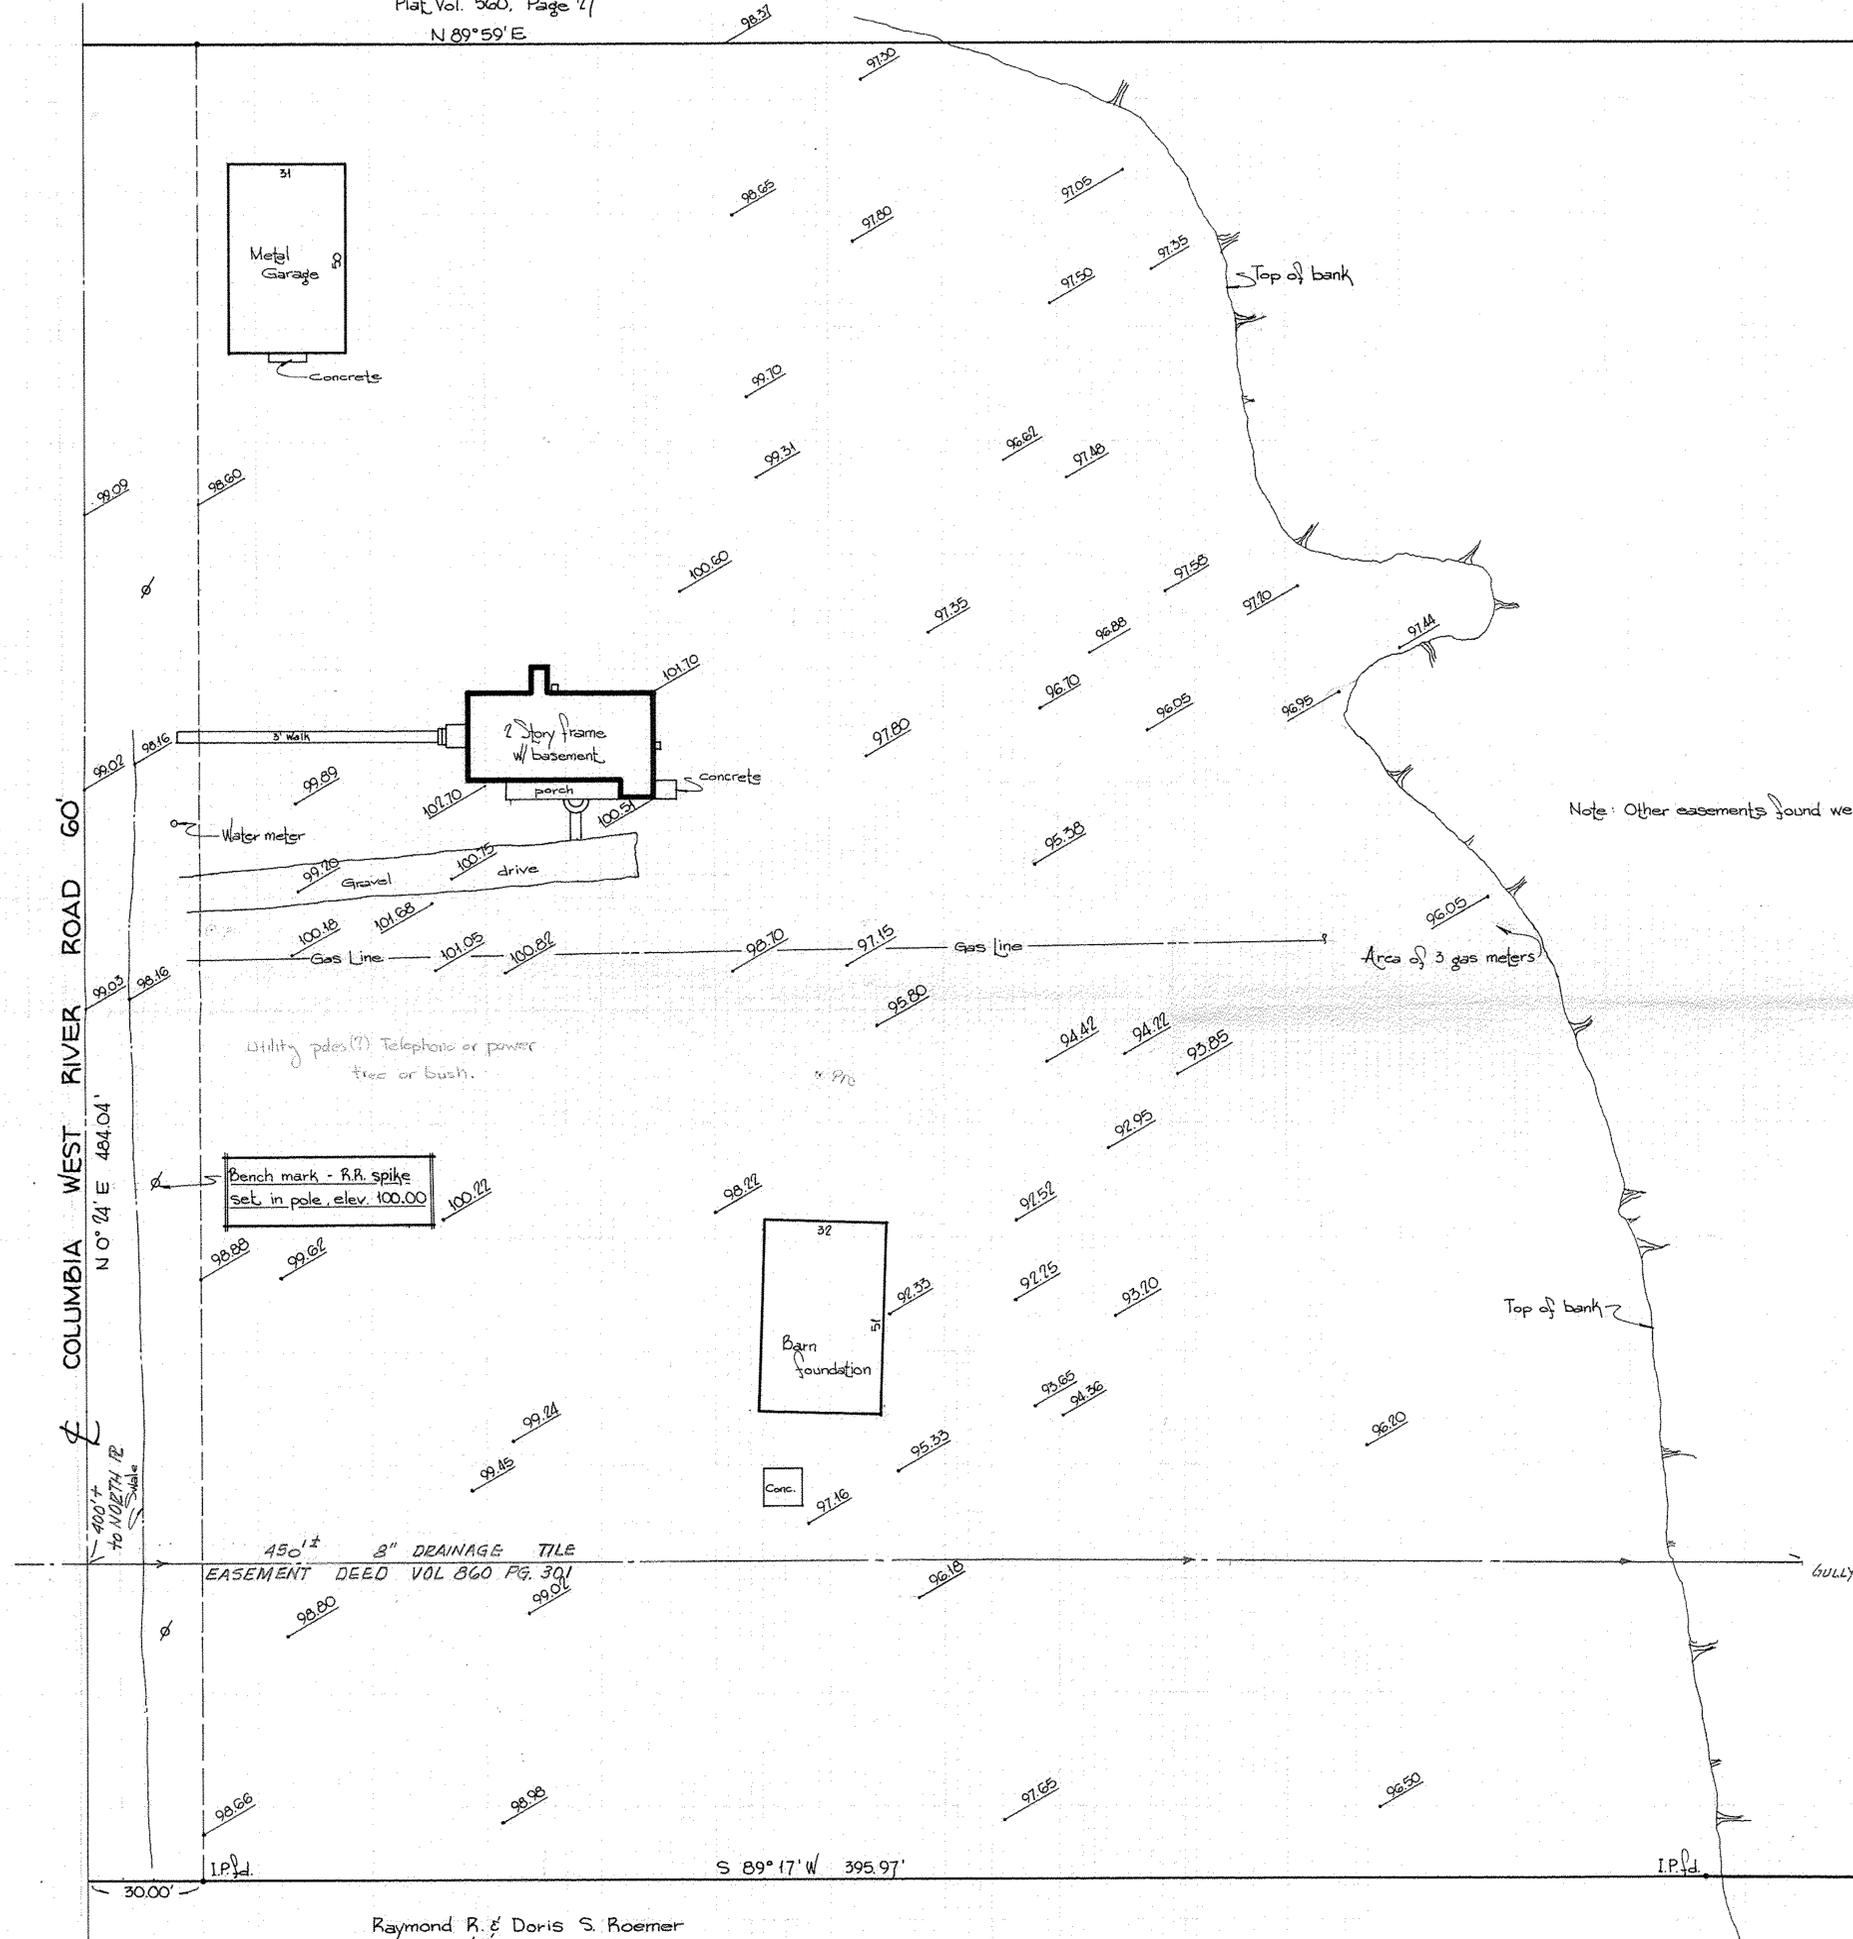

Note: Other easements found were not specific to location.

12-00-045-000-036,037,007-10
12-00-045-A Scan # 48087

TOPOGRAPHICAL and BUILDING LOCATION SURVEY
for
HOSANNA LUTHERAN CHURCH
2678 FREDERICK DRIVE
COLUMBIA STATION, OHIO
PART of ORIGINAL COLUMBIA TWP LOT N#45
P.P. # 12-00-045-000-006 LORAIN COUNTY, OH.

Raymond R. & Doris S. Roemer
Plat Vol. 690, Page 54

McGLINCHY and ASSOCIATES
PROFESSIONAL ENGINEERS AND SURVEYORS
538 WEST BROAD STREET ELYRIA, OHIO
JULY 1977 JOB # 772229

MP