



2.372
.661
1.711

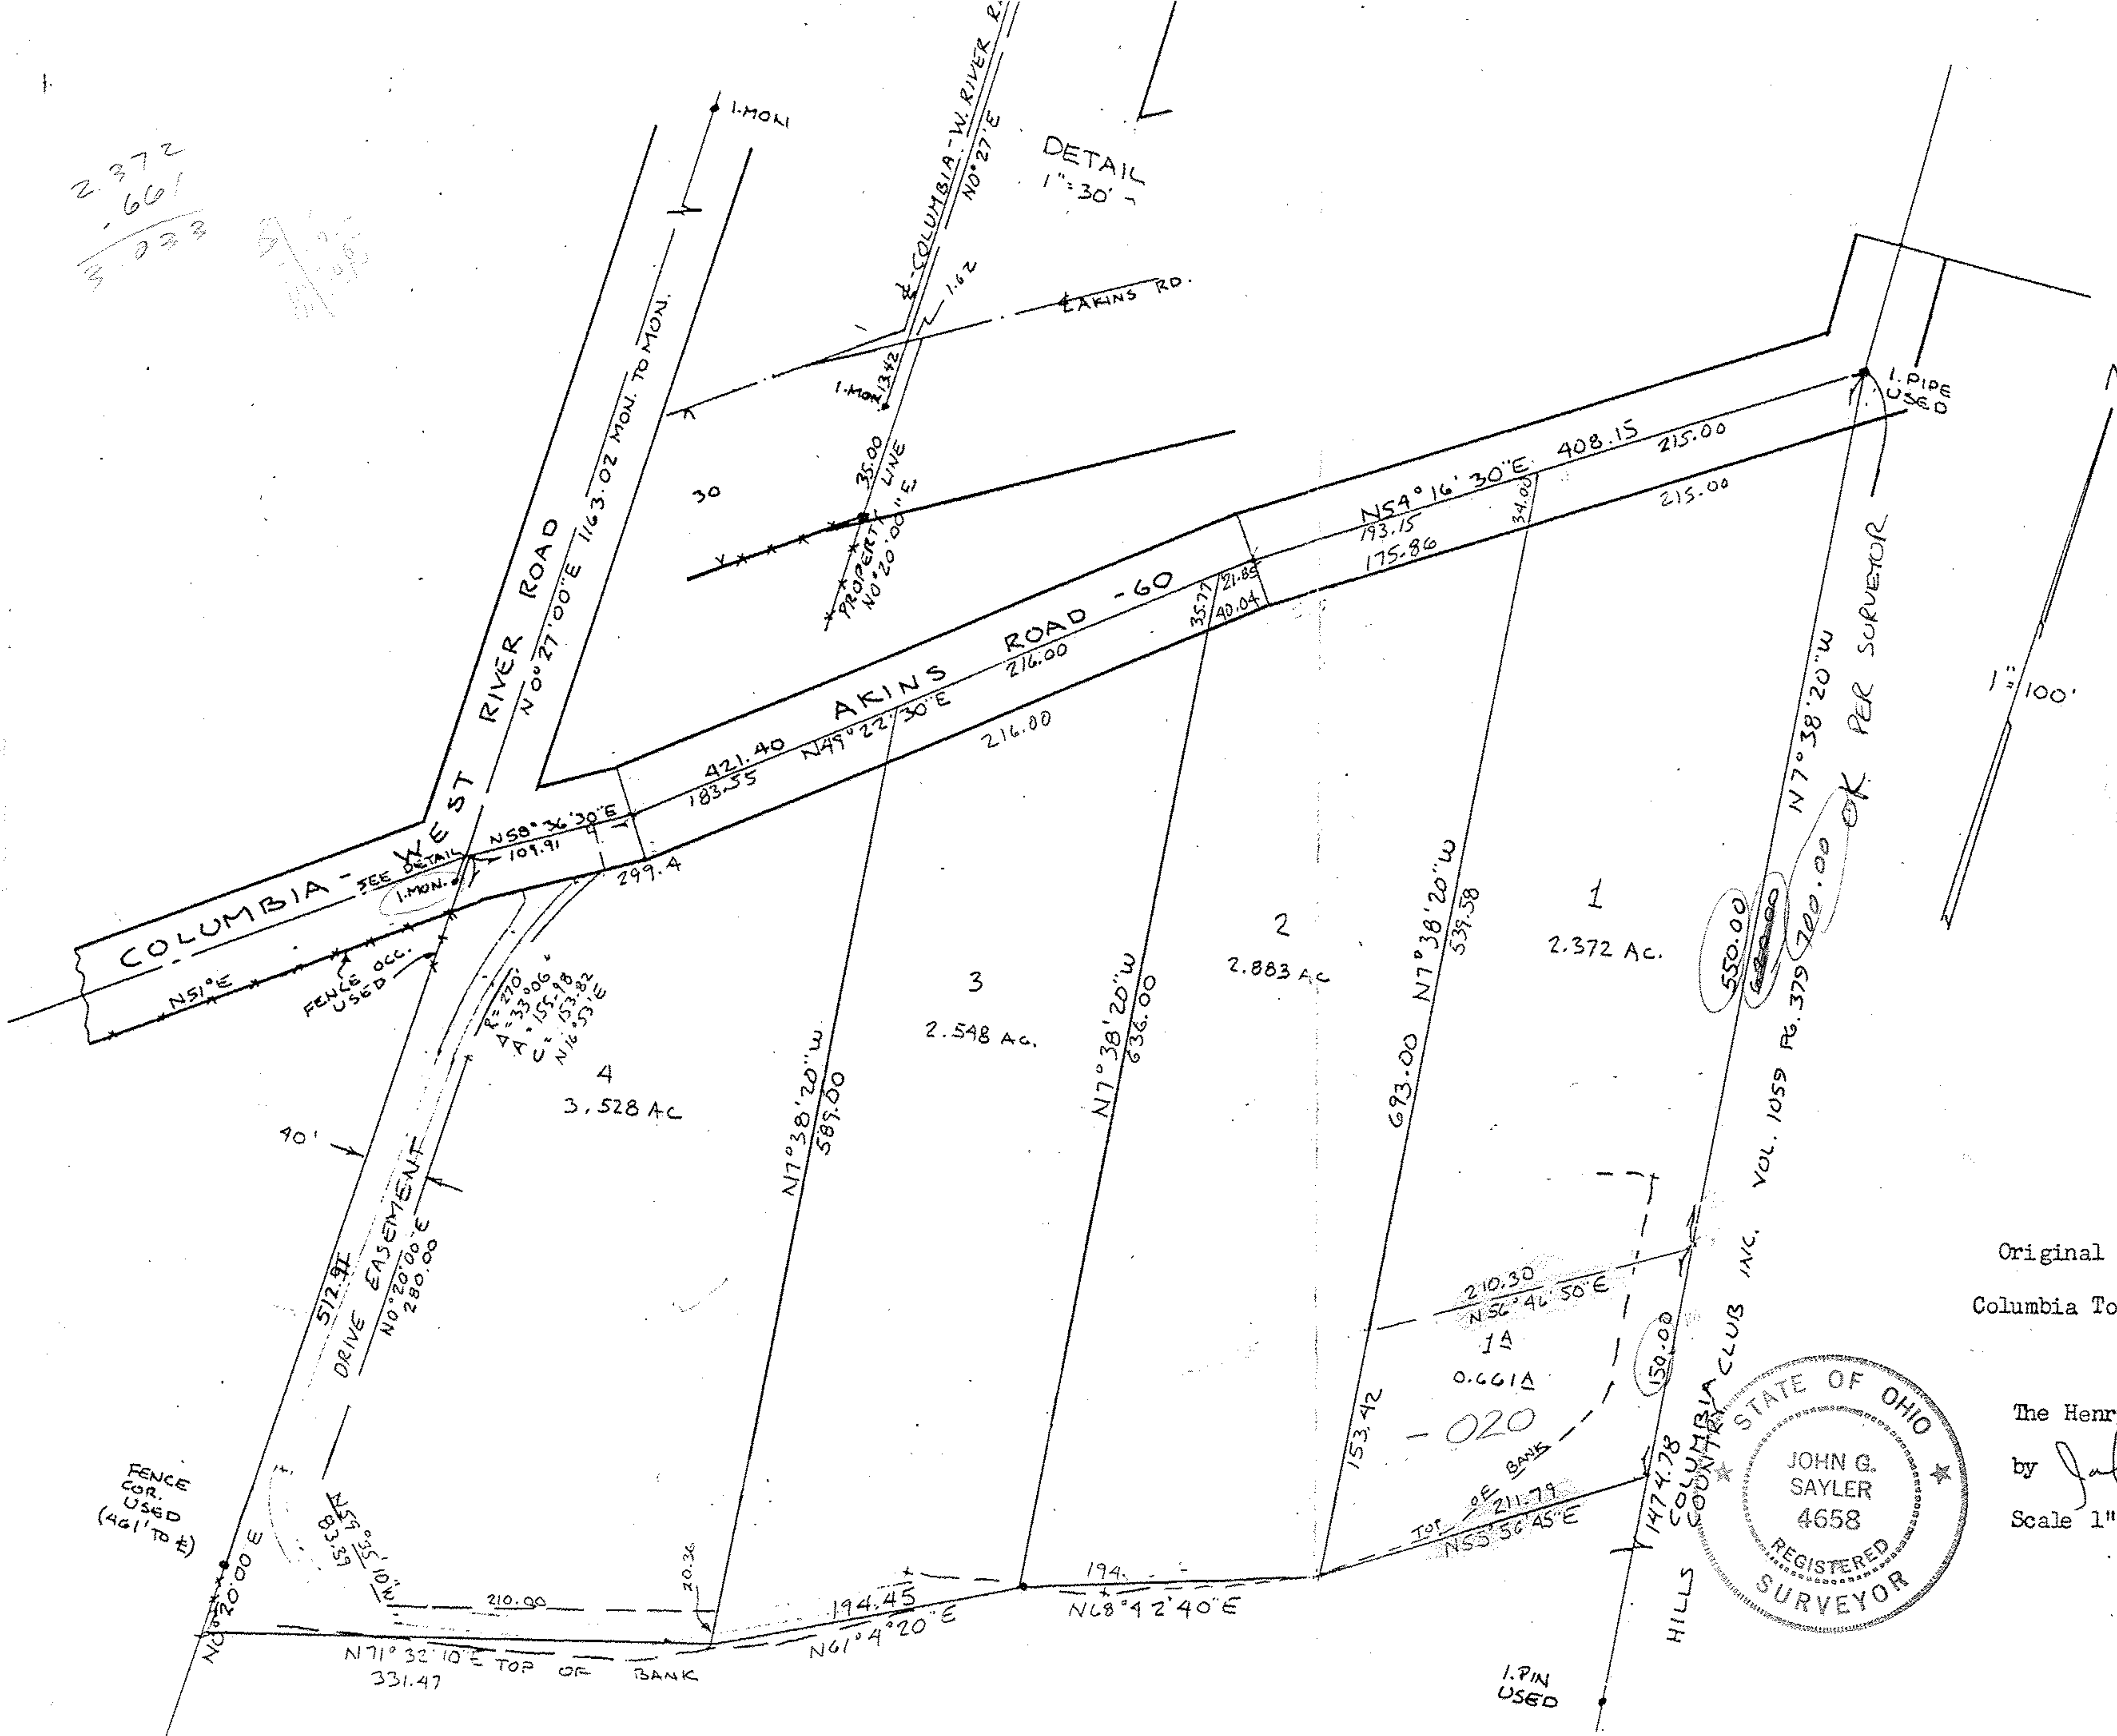

#19162

APPROVED
LORAIN CO.
MAP DEPT.
DATE 10-9-90
PAGE 12-G
BY CAROLYN FRANCIS
VOID AFTER # 19162

SURVEY
of
4 Parcels
on
Akins Road
Original Columbia Township Lot No. 48
in
Columbia Township, Lorain County, Ohio
for
JERRY STEADMAN
by
The Henry G. Reitz Engineering Company

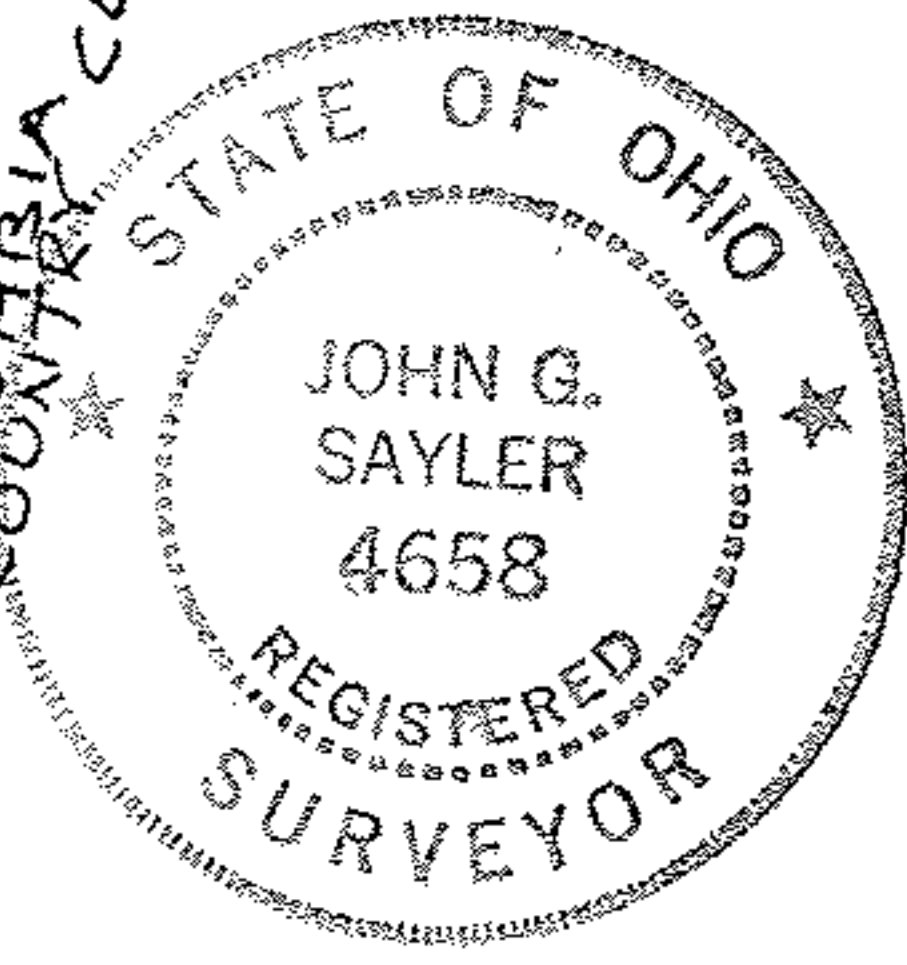

by *John D. Saylor* Pres.
Scale 1" = 100'
January, 1990
REV. 9-18-90