


HOUSE STAKEOUTS FOR 29603 LORAIN ROAD, INC. Scan # 48101
 O.L. 51 COLUMBIA TWP. - LORAIN COUNTY - OHIO
 SCALE: 1" = 40' SEPT. 1-1978 Gary E. Penfound Reg. Surveyor No. 4957

NOTES: ● indicates iron pin found, ▢ indicates stake set.
 ○ indicates railroad spike found.

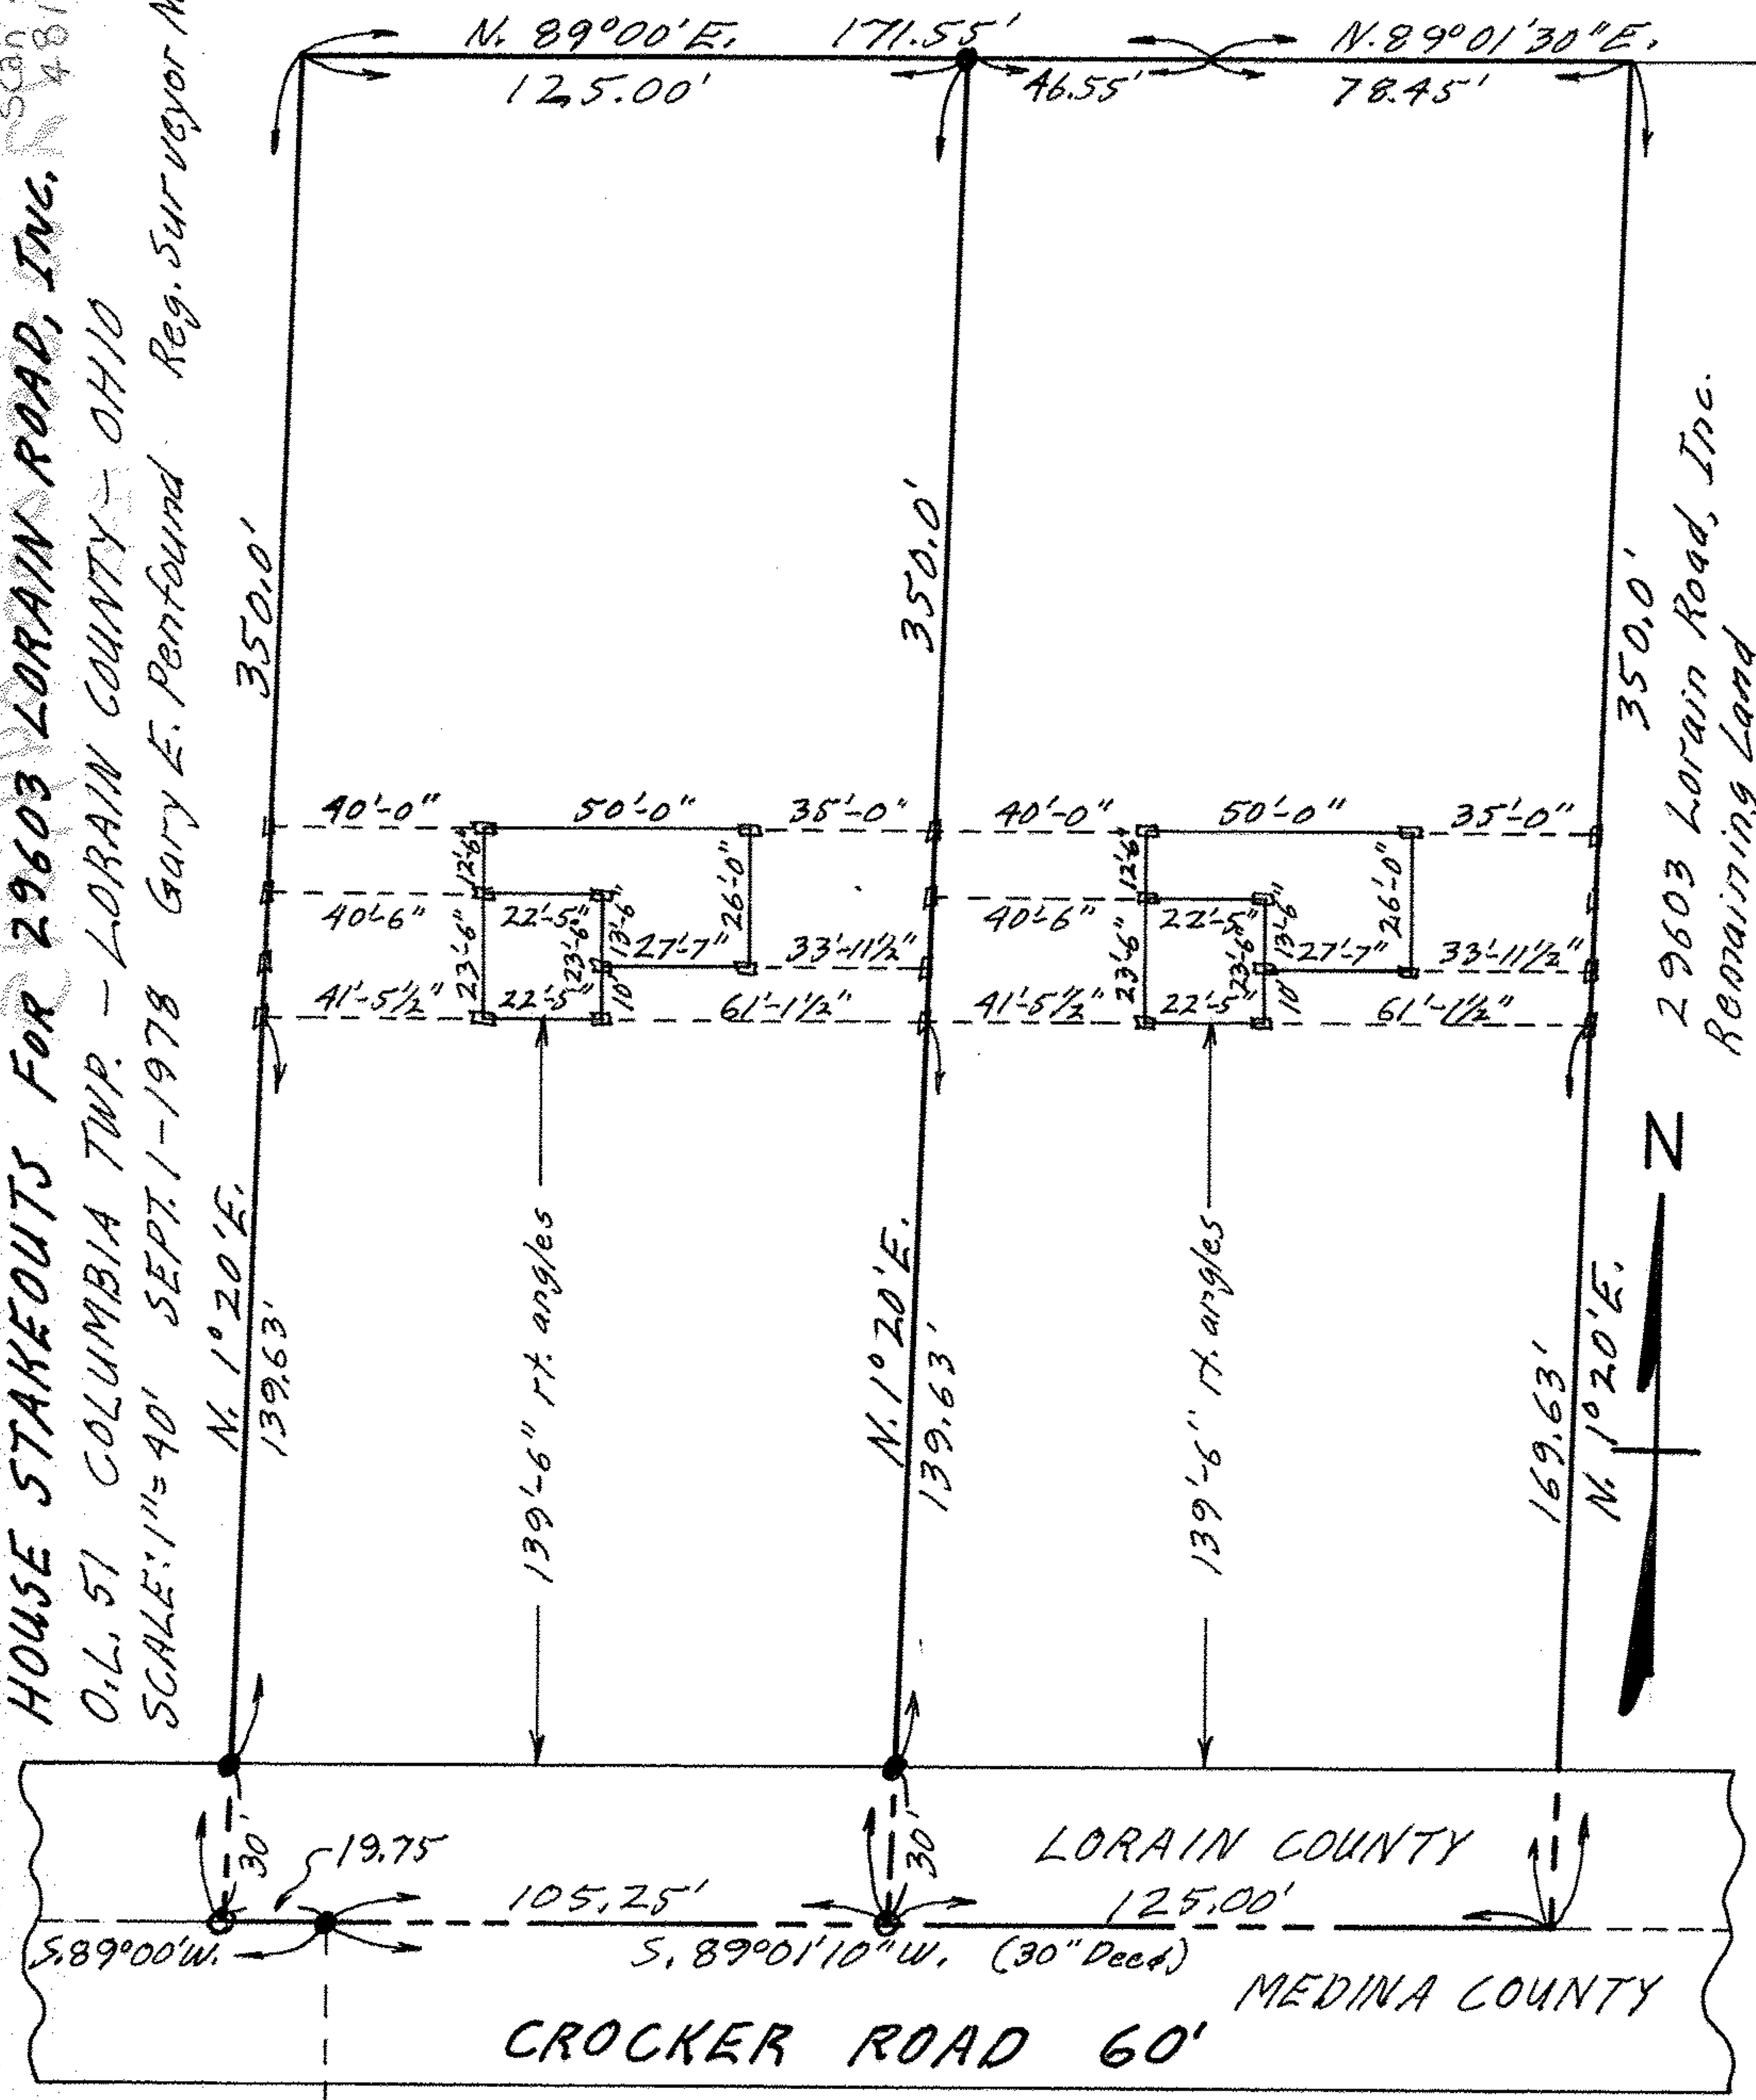

29603 Lorain Road, Inc.
 Remaining Land

LORAIN COUNTY
 125.00'
 MEDINA COUNTY
 CROCKER ROAD 60'