


12-00-052

SEARCHED INDEXED
SERIALIZED FILED
MAY 11 1969
FBI - COLUMBIA

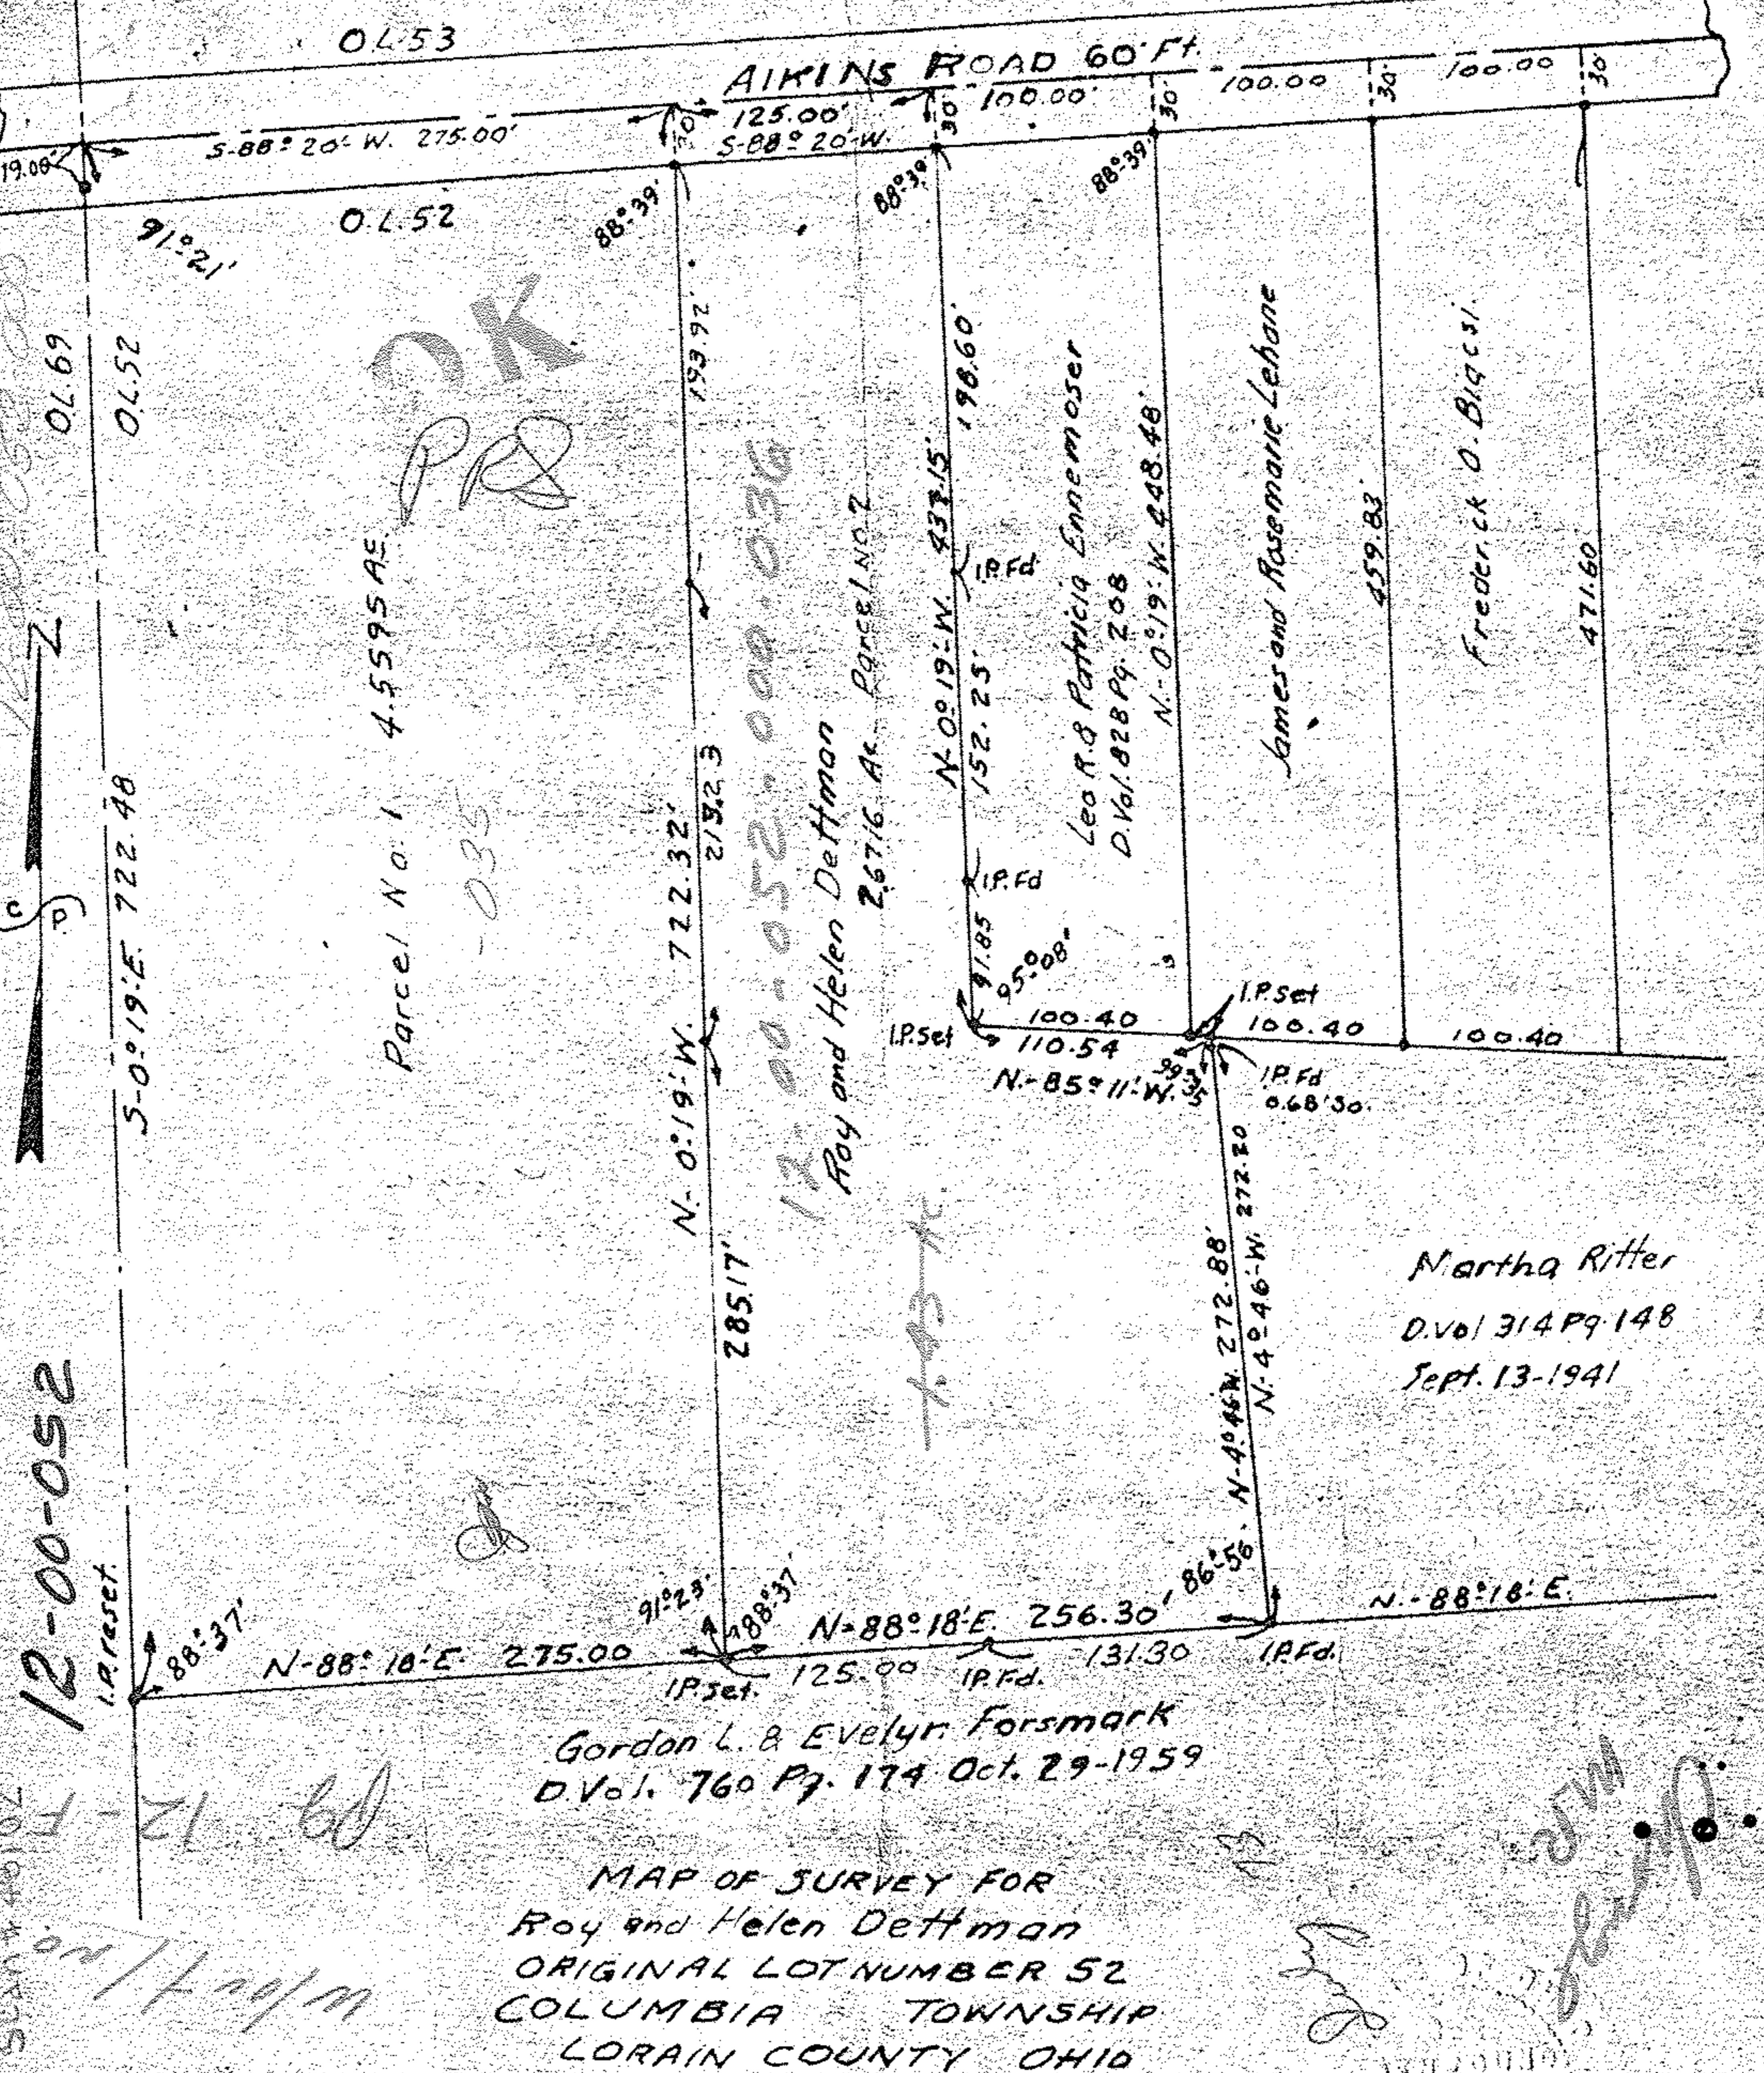

0453

AIKINS ROAD 60 FT.

5-88° 20' W. 275.00'

125.00' 5-88° 20' W.

100.00' 30' 100.00' 30'

91° 21' 257.0'

88° 39'

88° 39'

88° 39'

69.70

06.52

Parcel No. 1 4.5595 AC.

-035

N-0° 19' W. 722.32'

213.23

285.17'

Roy and Helen Dettman

Parcel No. 2

12-00-052-000-036

N-0° 19' W. 433.15'

152.25'

198.60'

Leo R. & Patricia Ennemoser

D. Vol. 828 Pg. 208

N-0° 19' W. 448.48'

James and Rosemarie Lehane

459.83'

Frederick O. Biggs

471.60'

I.P. Set

I.P. Fd.

I.P. Fd.

I.P. Set

I.P. Fd.

I.P. Fd.

Martha Ritter
D. Vol 314 Pg. 148
Sept. 13-1941

Gordon L. & Evelyn Forsmark
D. Vol. 760 Pg. 174 Oct. 29-1959

MAP OF SURVEY FOR
Roy and Helen Dettman
ORIGINAL LOT NUMBER 52
COLUMBIA TOWNSHIP
LORAIN COUNTY OHIO
Scale 1" = 100' MAY-6-1969

Handwritten signatures and notes in the bottom right corner.