



LAUNDON • SIMON • CAHL & ASSOC., INC.
 CONSULTING ENGINEERS & SURVEYORS
 110 MIDDLE AVE. ELYRIA, O. 44035

SURVEY FOR:

PHILLIP W. BETTS

Orig. Lot 53	City of	Date 3-3-93	Scale 1"=100'
Orig. Sec	Village of	Dwn. by R.G.S.	Chkd. by
Tract	County of LORAIN	Job No. 93-2288	F.B. 229/7
Township of COLUMBIA	State of OHIO	Printed	


20489

APPROVED
 LORAIN CO.
 MAP DEPT.
 DATE 8-16-93
 PAGE 12-F
 BY CAROLYN FRANCIS
 VOID # 20489



O.L. 54


O.L. 53

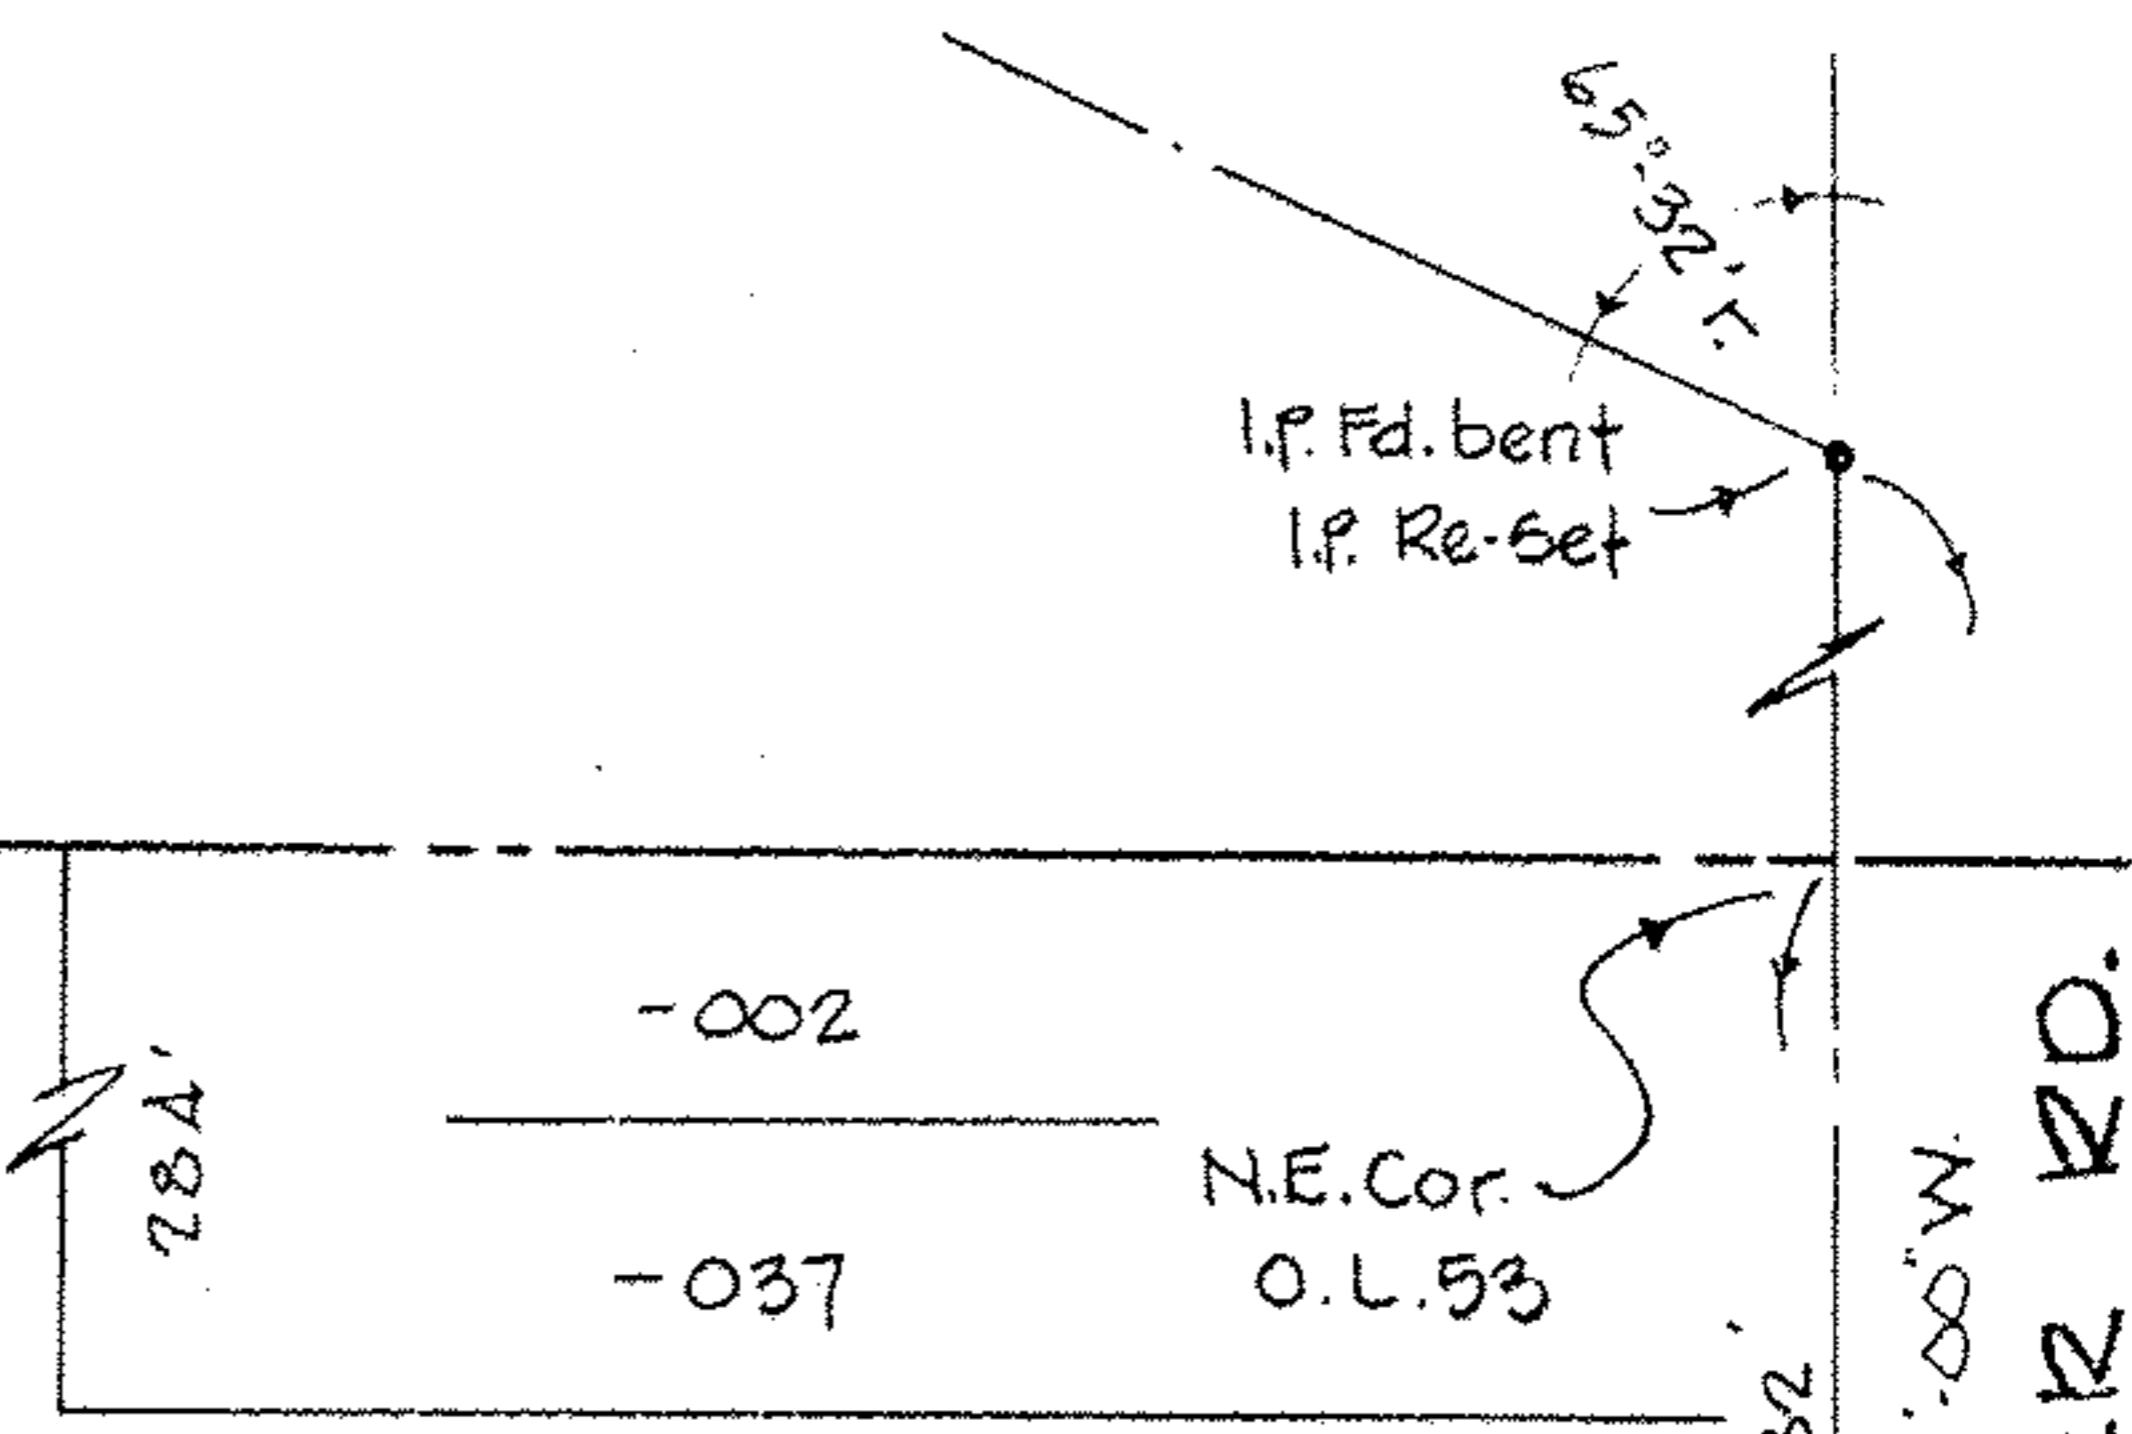

PHILLIP W. BETTS

RMOR. -036 45.83 Calc.

-039

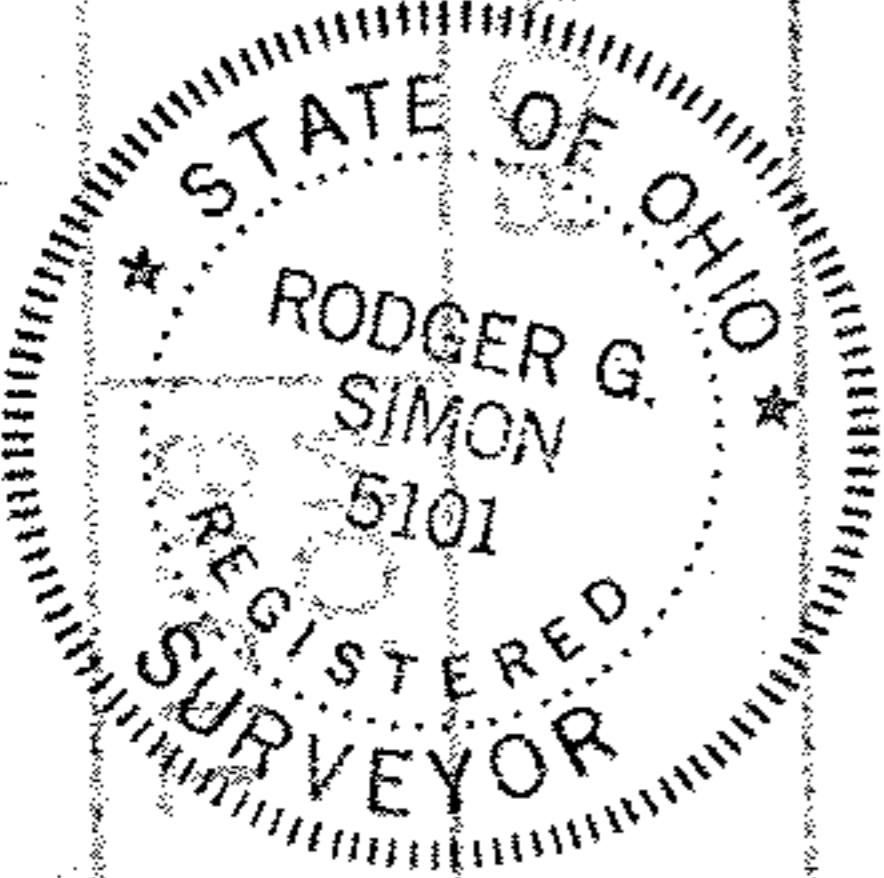

6.83°06'-40"E
 440.00' E

-038
 2.0201 Ac.

440.00' E
 N. 83°06'-40" W.

350.00' E

ANTON & ANNA LOVKO
 V. 781 P. 765

JOHN A. & PAMELA D. ANDREWS
 V. 1358 P. 723

COLUMBIA WEST RIVER RD.
 1473.40' Co. Rec. 5.7°33'-00" W.

M.B./I.P. Fd.

D.M.

FROM

SURVEY

N. 71°32'-00" E.

200.00'

660.82'

200.00'

30'

30'

284'