


CUYAHOGA COUNTY

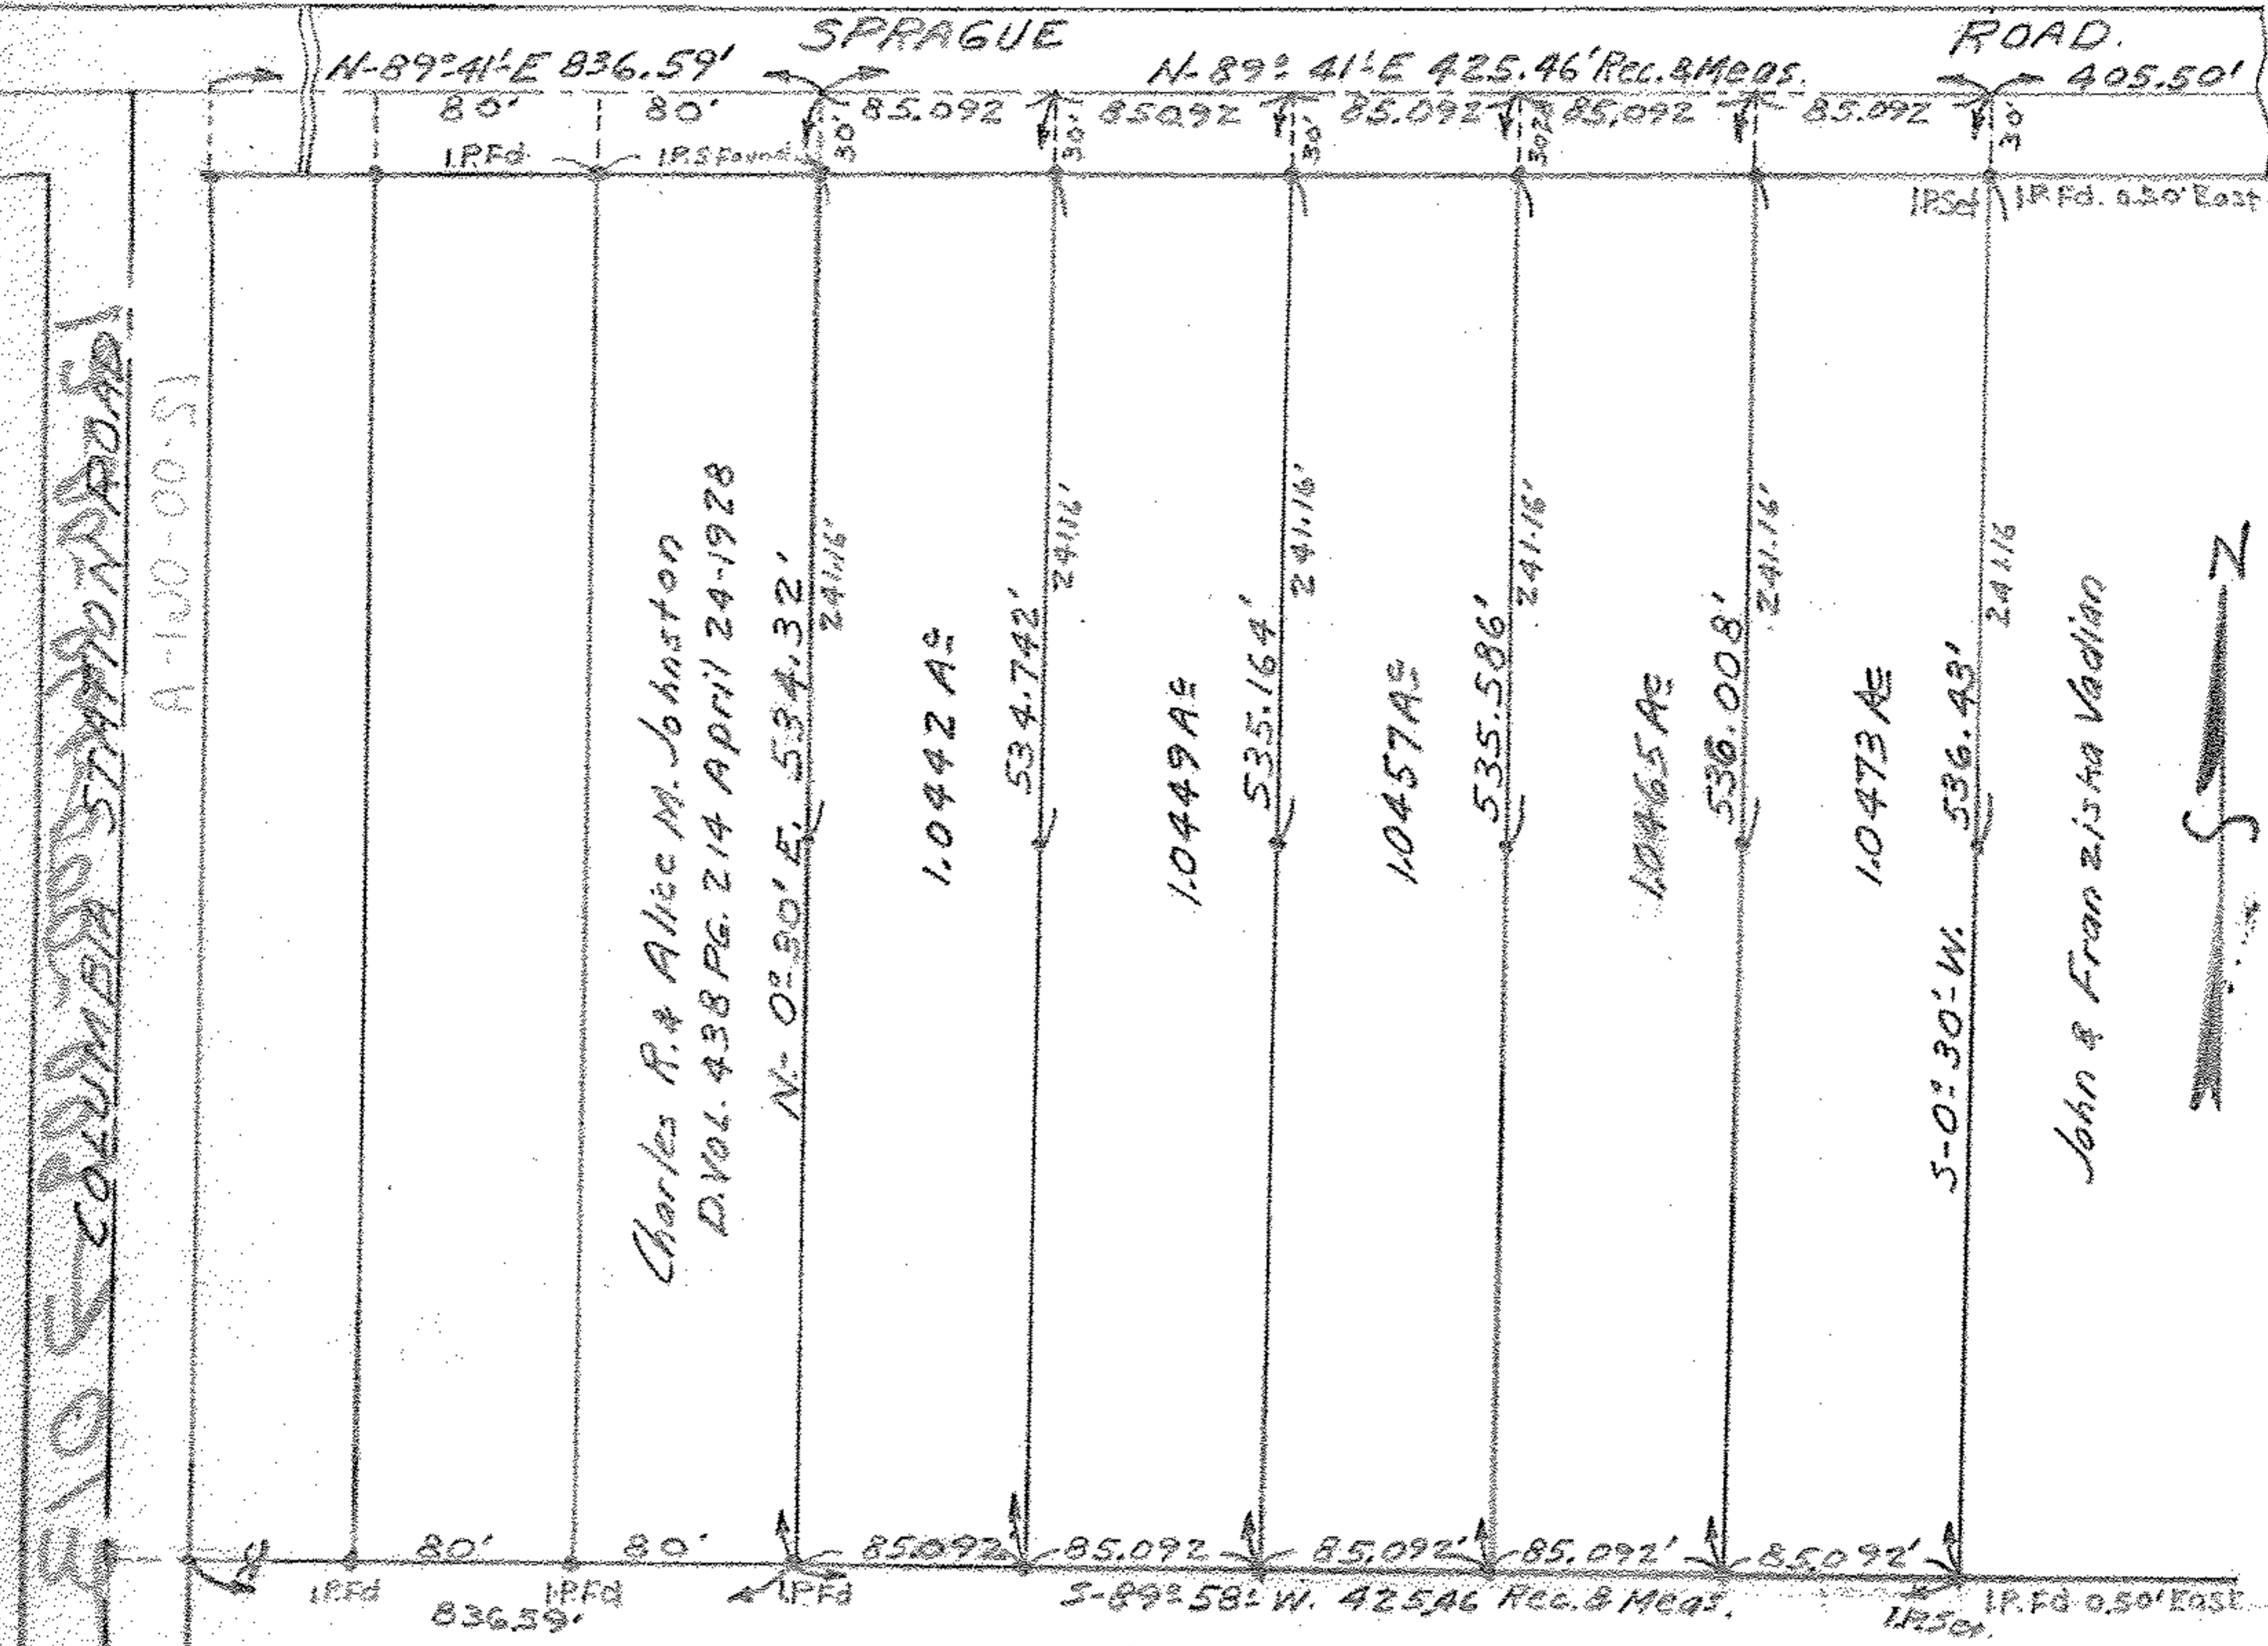

Charles R. & Alice M. Johnston
 D.VOL. 438 PG. 214 April 24-1928

John & Francis A. Vadian

Rose C. Baker
 D.VOL. 98 PG. 574 June 27 1905

MAP OF SURVEY FOR
 Mary Malatinka
 O.L. 61 COLUMBIA TOWNSHIP
 LORAIN COUNTY OHIO
 Scale 1" = 30' MAY-8-1954
 C.E. Perfaund Registered Surveyor.

