


12-00-062-000

#17420

12-00-062-AB

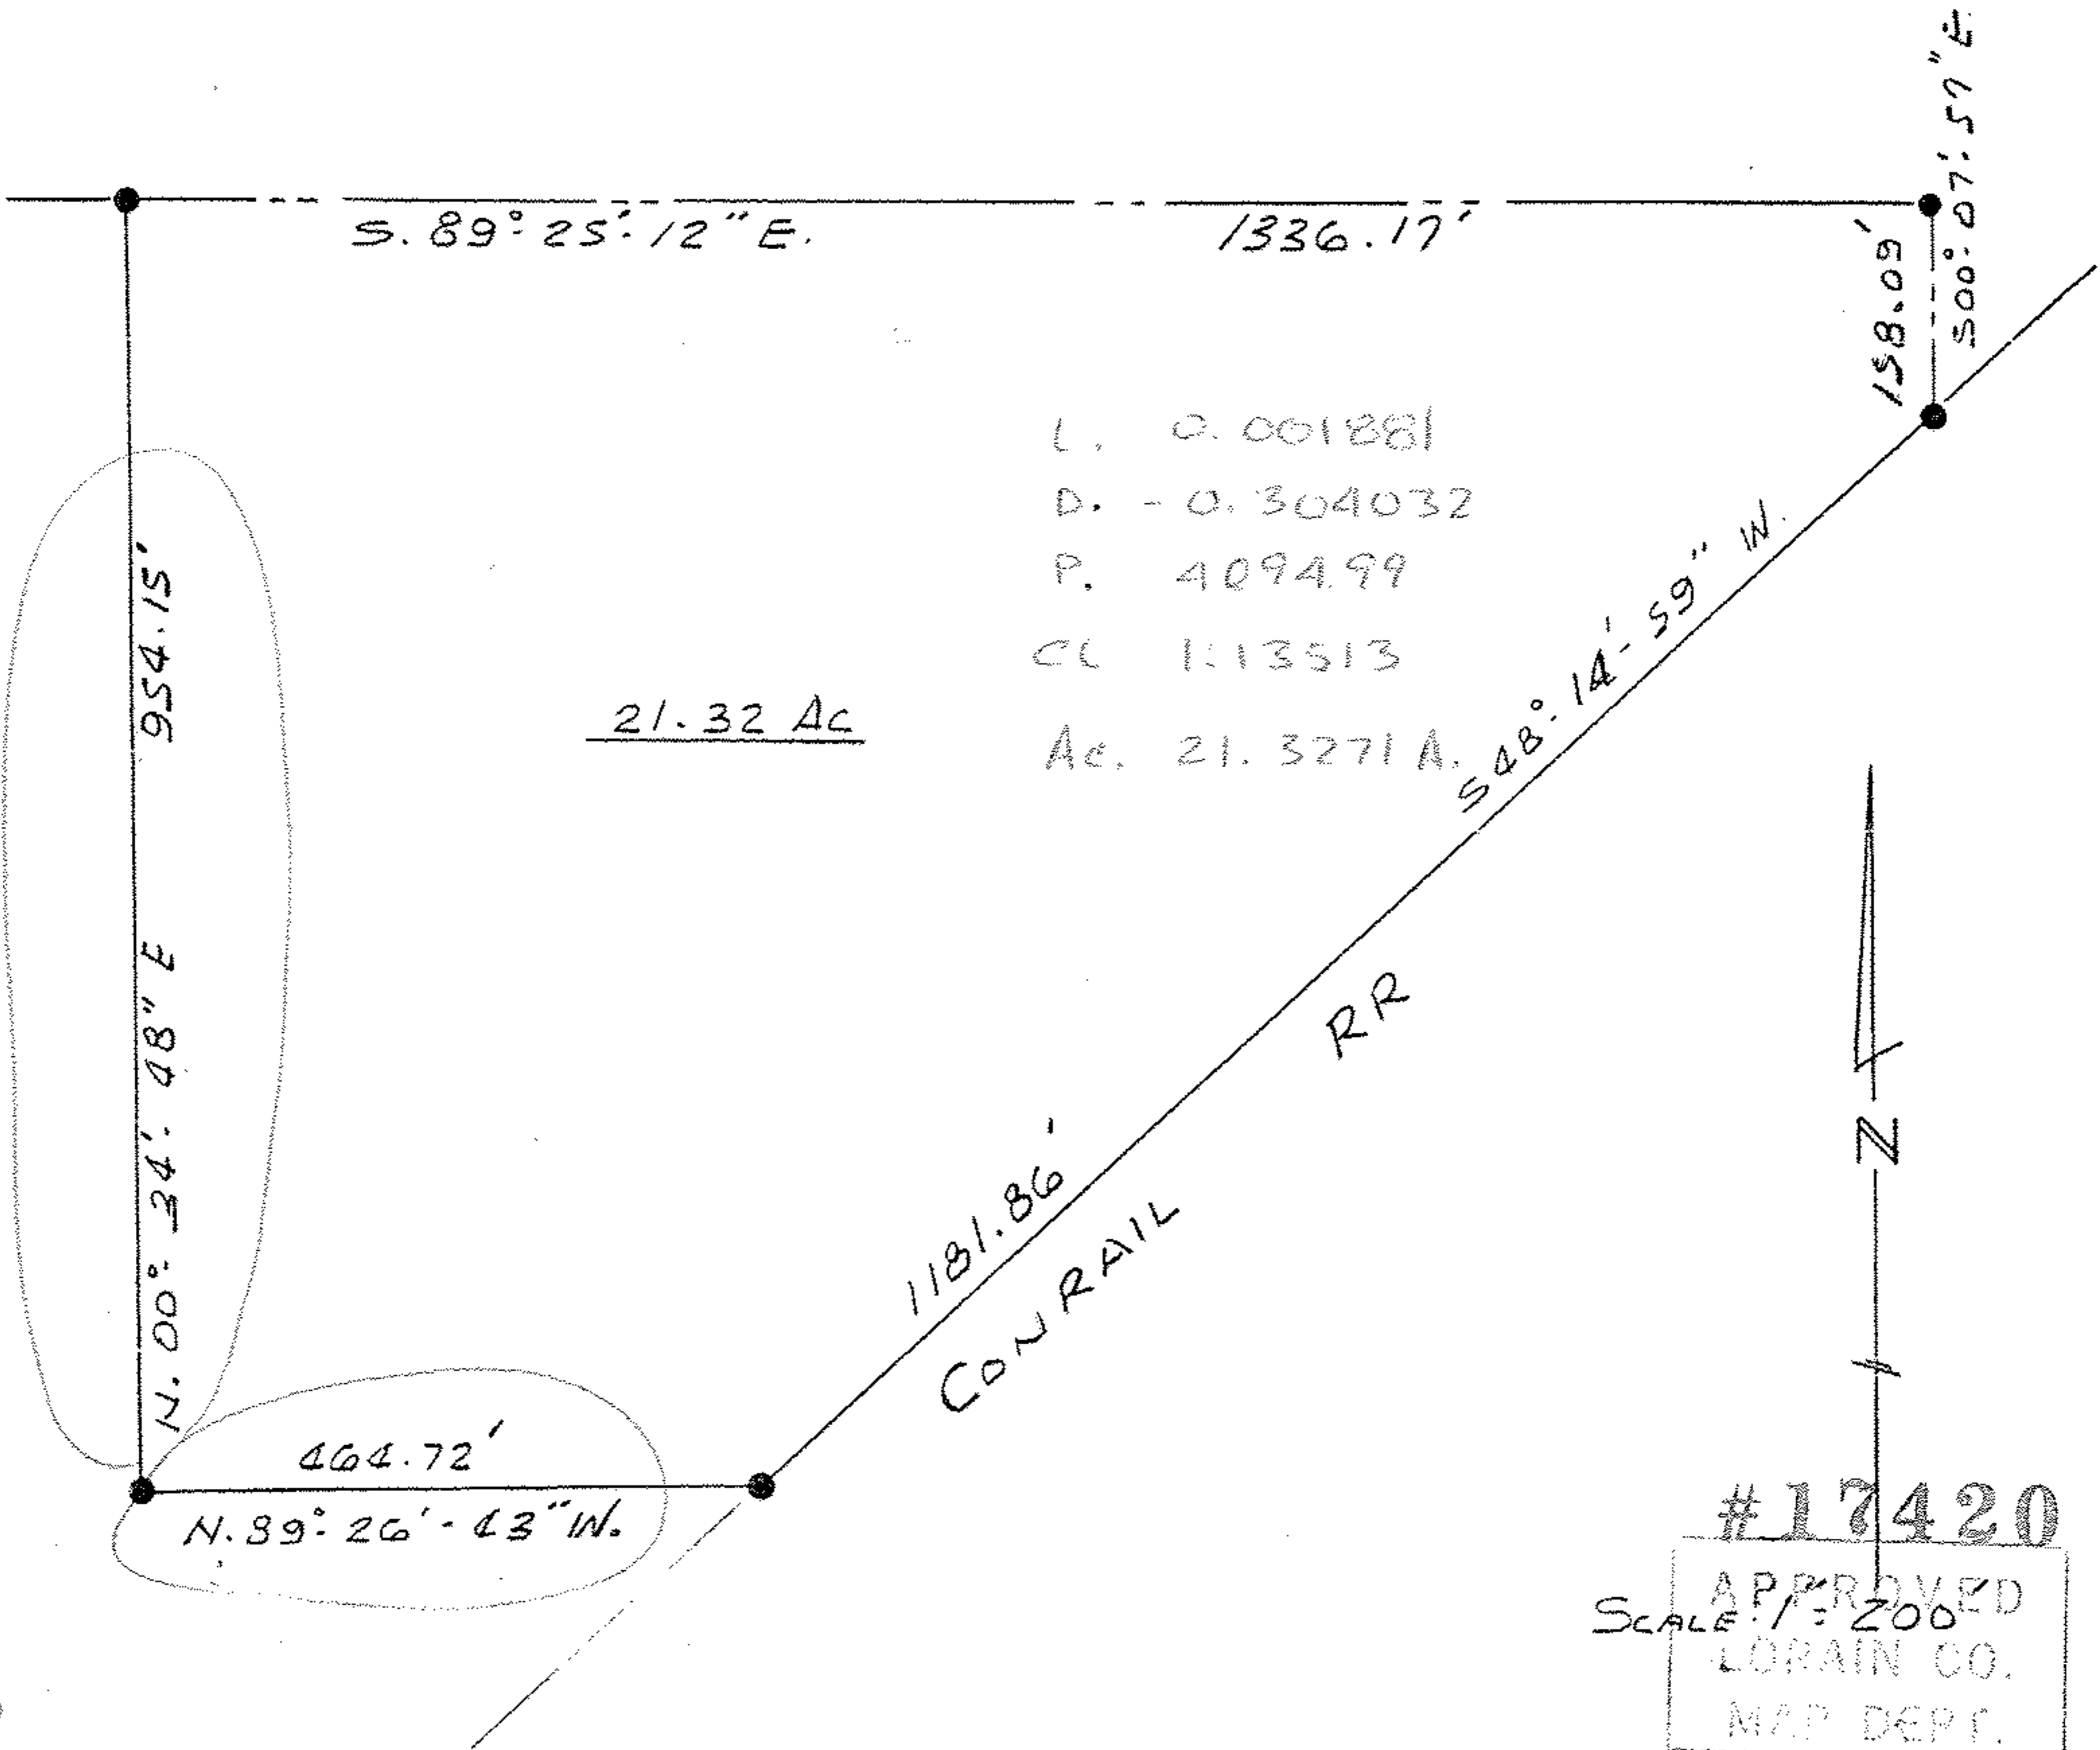

L. 0.001881
 D. - 0.304032
 P. 4094.99
 CL 1:13513
 Ac. 21.3271 A.

21.32 Ac



#17420
 APPROVED
 SCALE: 1" = 200'
 LORAIN CO.
 MAP DEPT.
 DATE 5-8-84
 PAGE 12-00-062 AB
 BY C. FRANCIS
 VOID AFTER 17420