


o indicates railroad spike found.

HOUSE STAKEOUTS FOR 29603 LORAIN ROAD, INC.  
O.L. 51 COLUMBIA TWP. - LORAIN COUNTY - OHIO  
SCALE: 1"=40' SEPT. 1-1978 Gary E. Penfound Reg. Surveyor No. 44

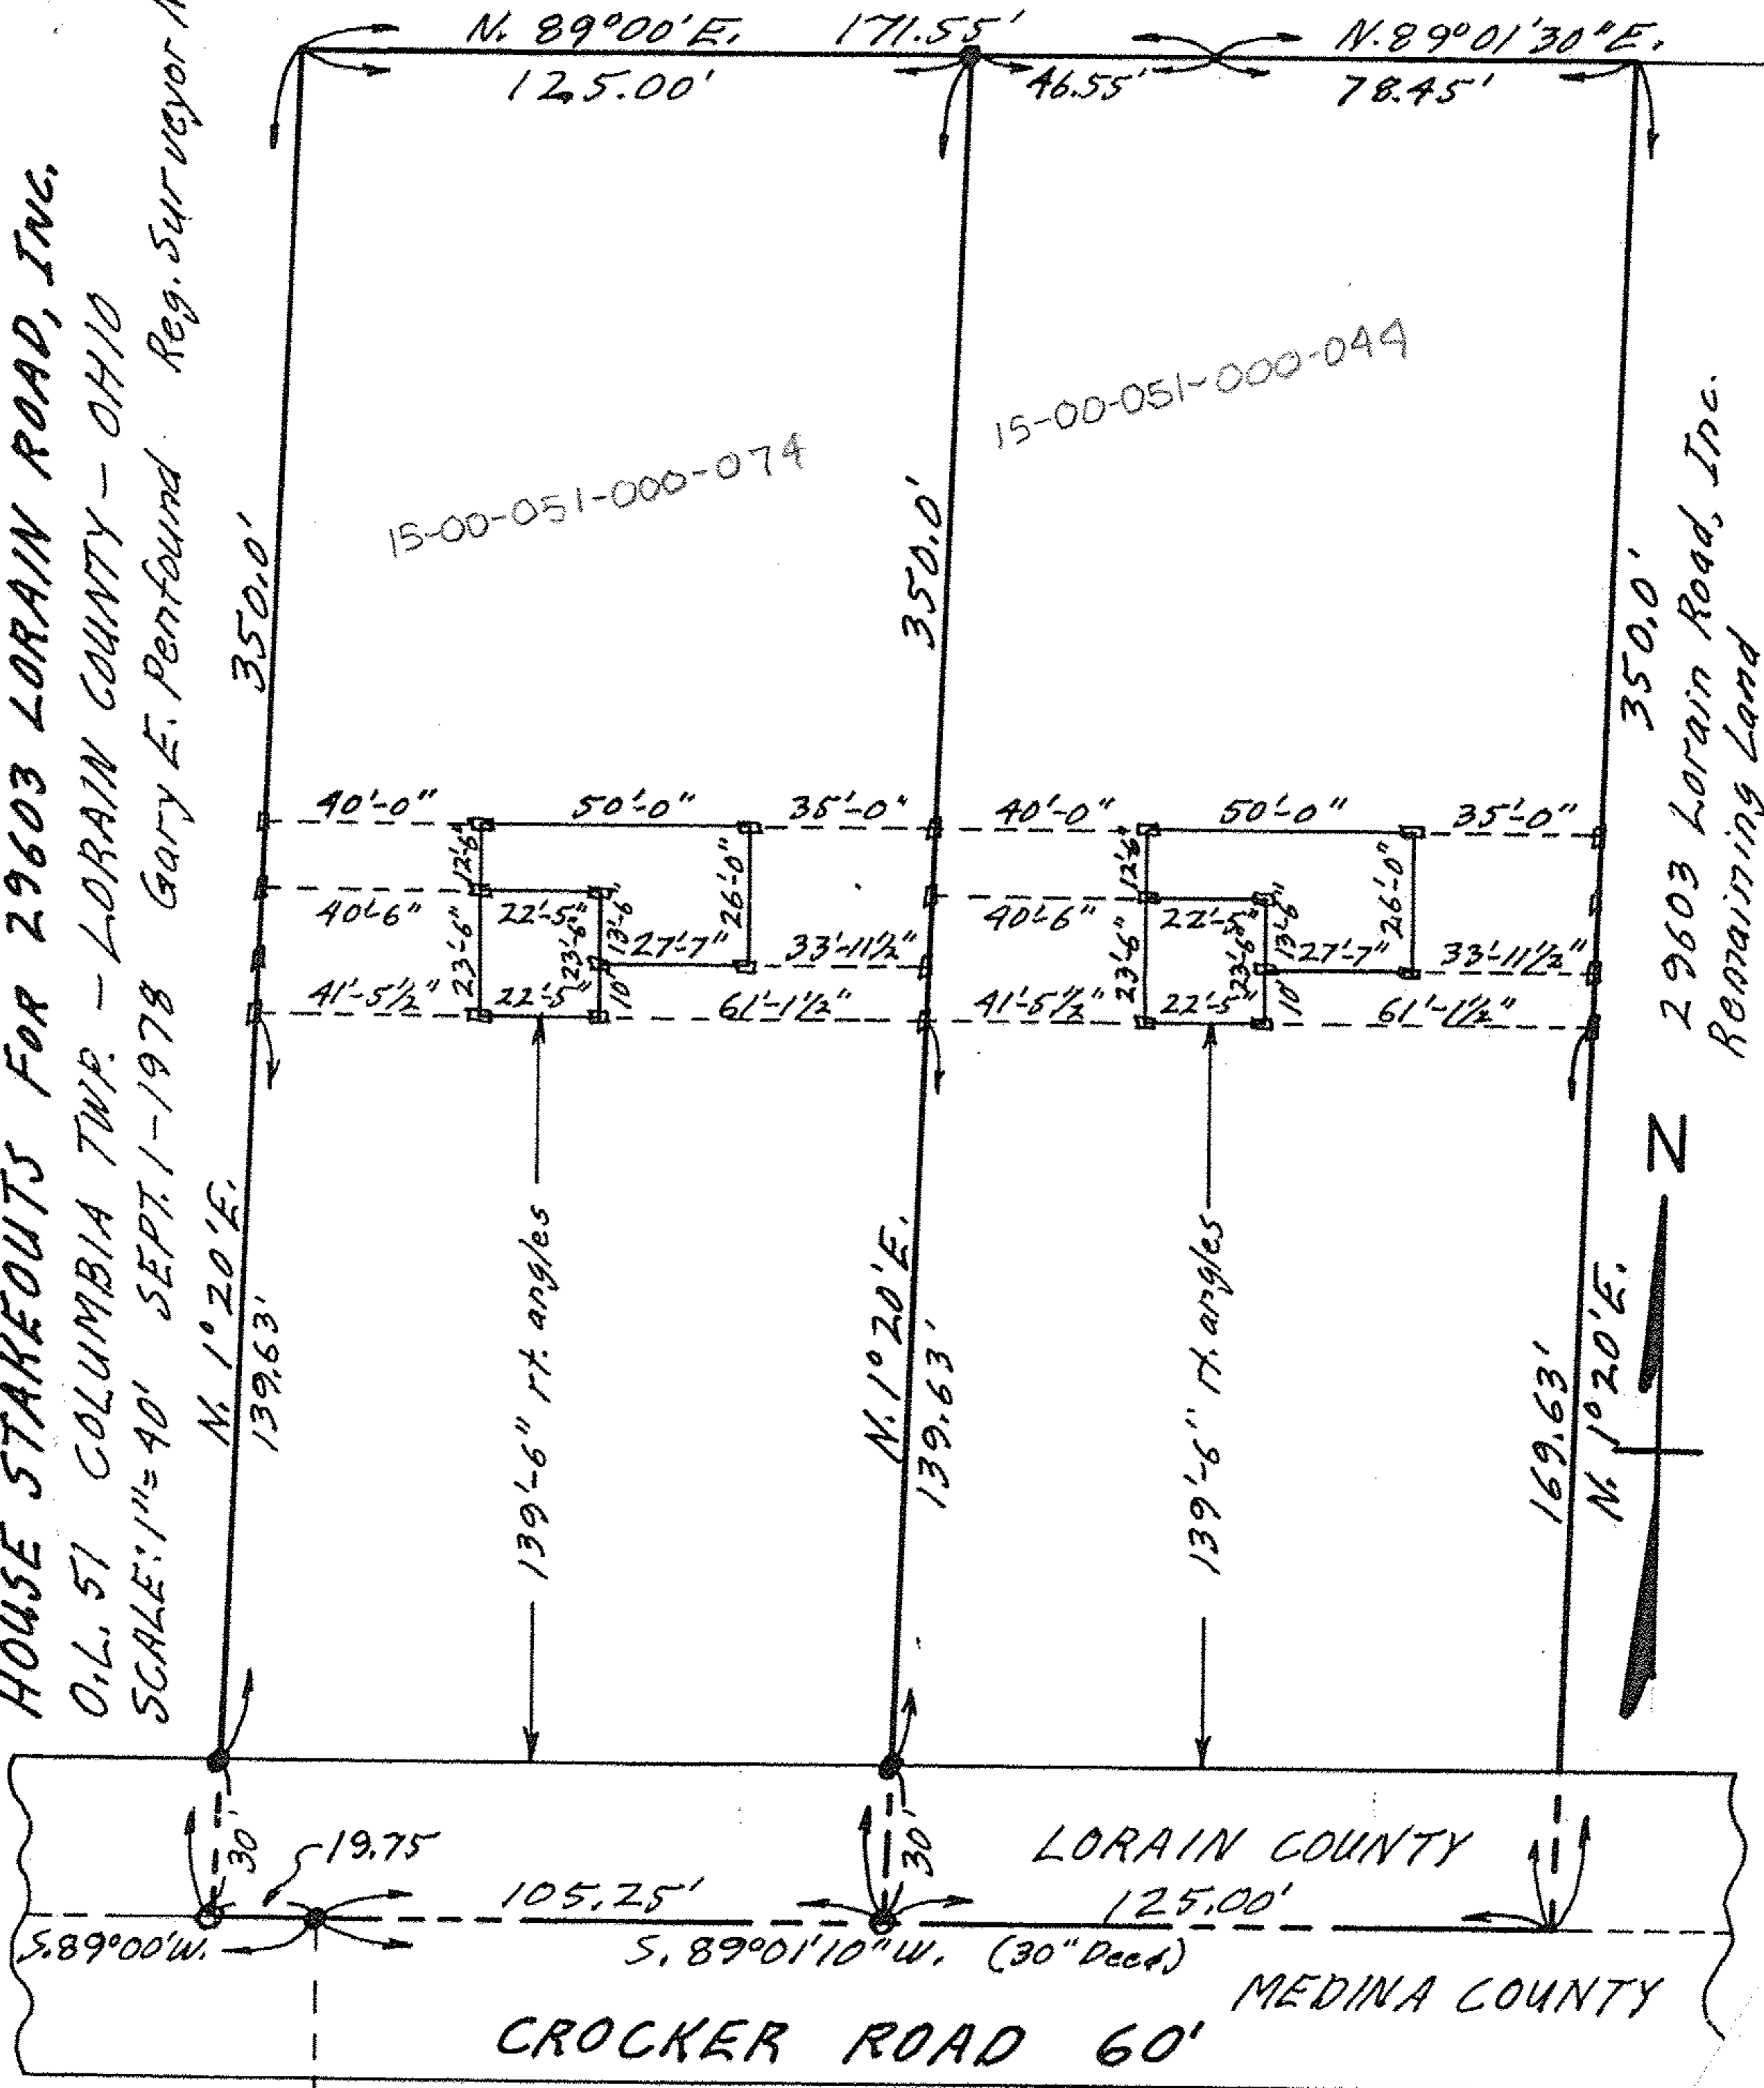

15-00-051-000-074

15-00-051-000-044

29603 Lorain Road, Inc.  
Remaining Land