


158.000-158.000-158.000  
 Leon J. & Mary B. Galinsky D. Vol. 722 Pg. 418 June 9, 1958  
 141.00-021-000-001  
 Scan # 48147

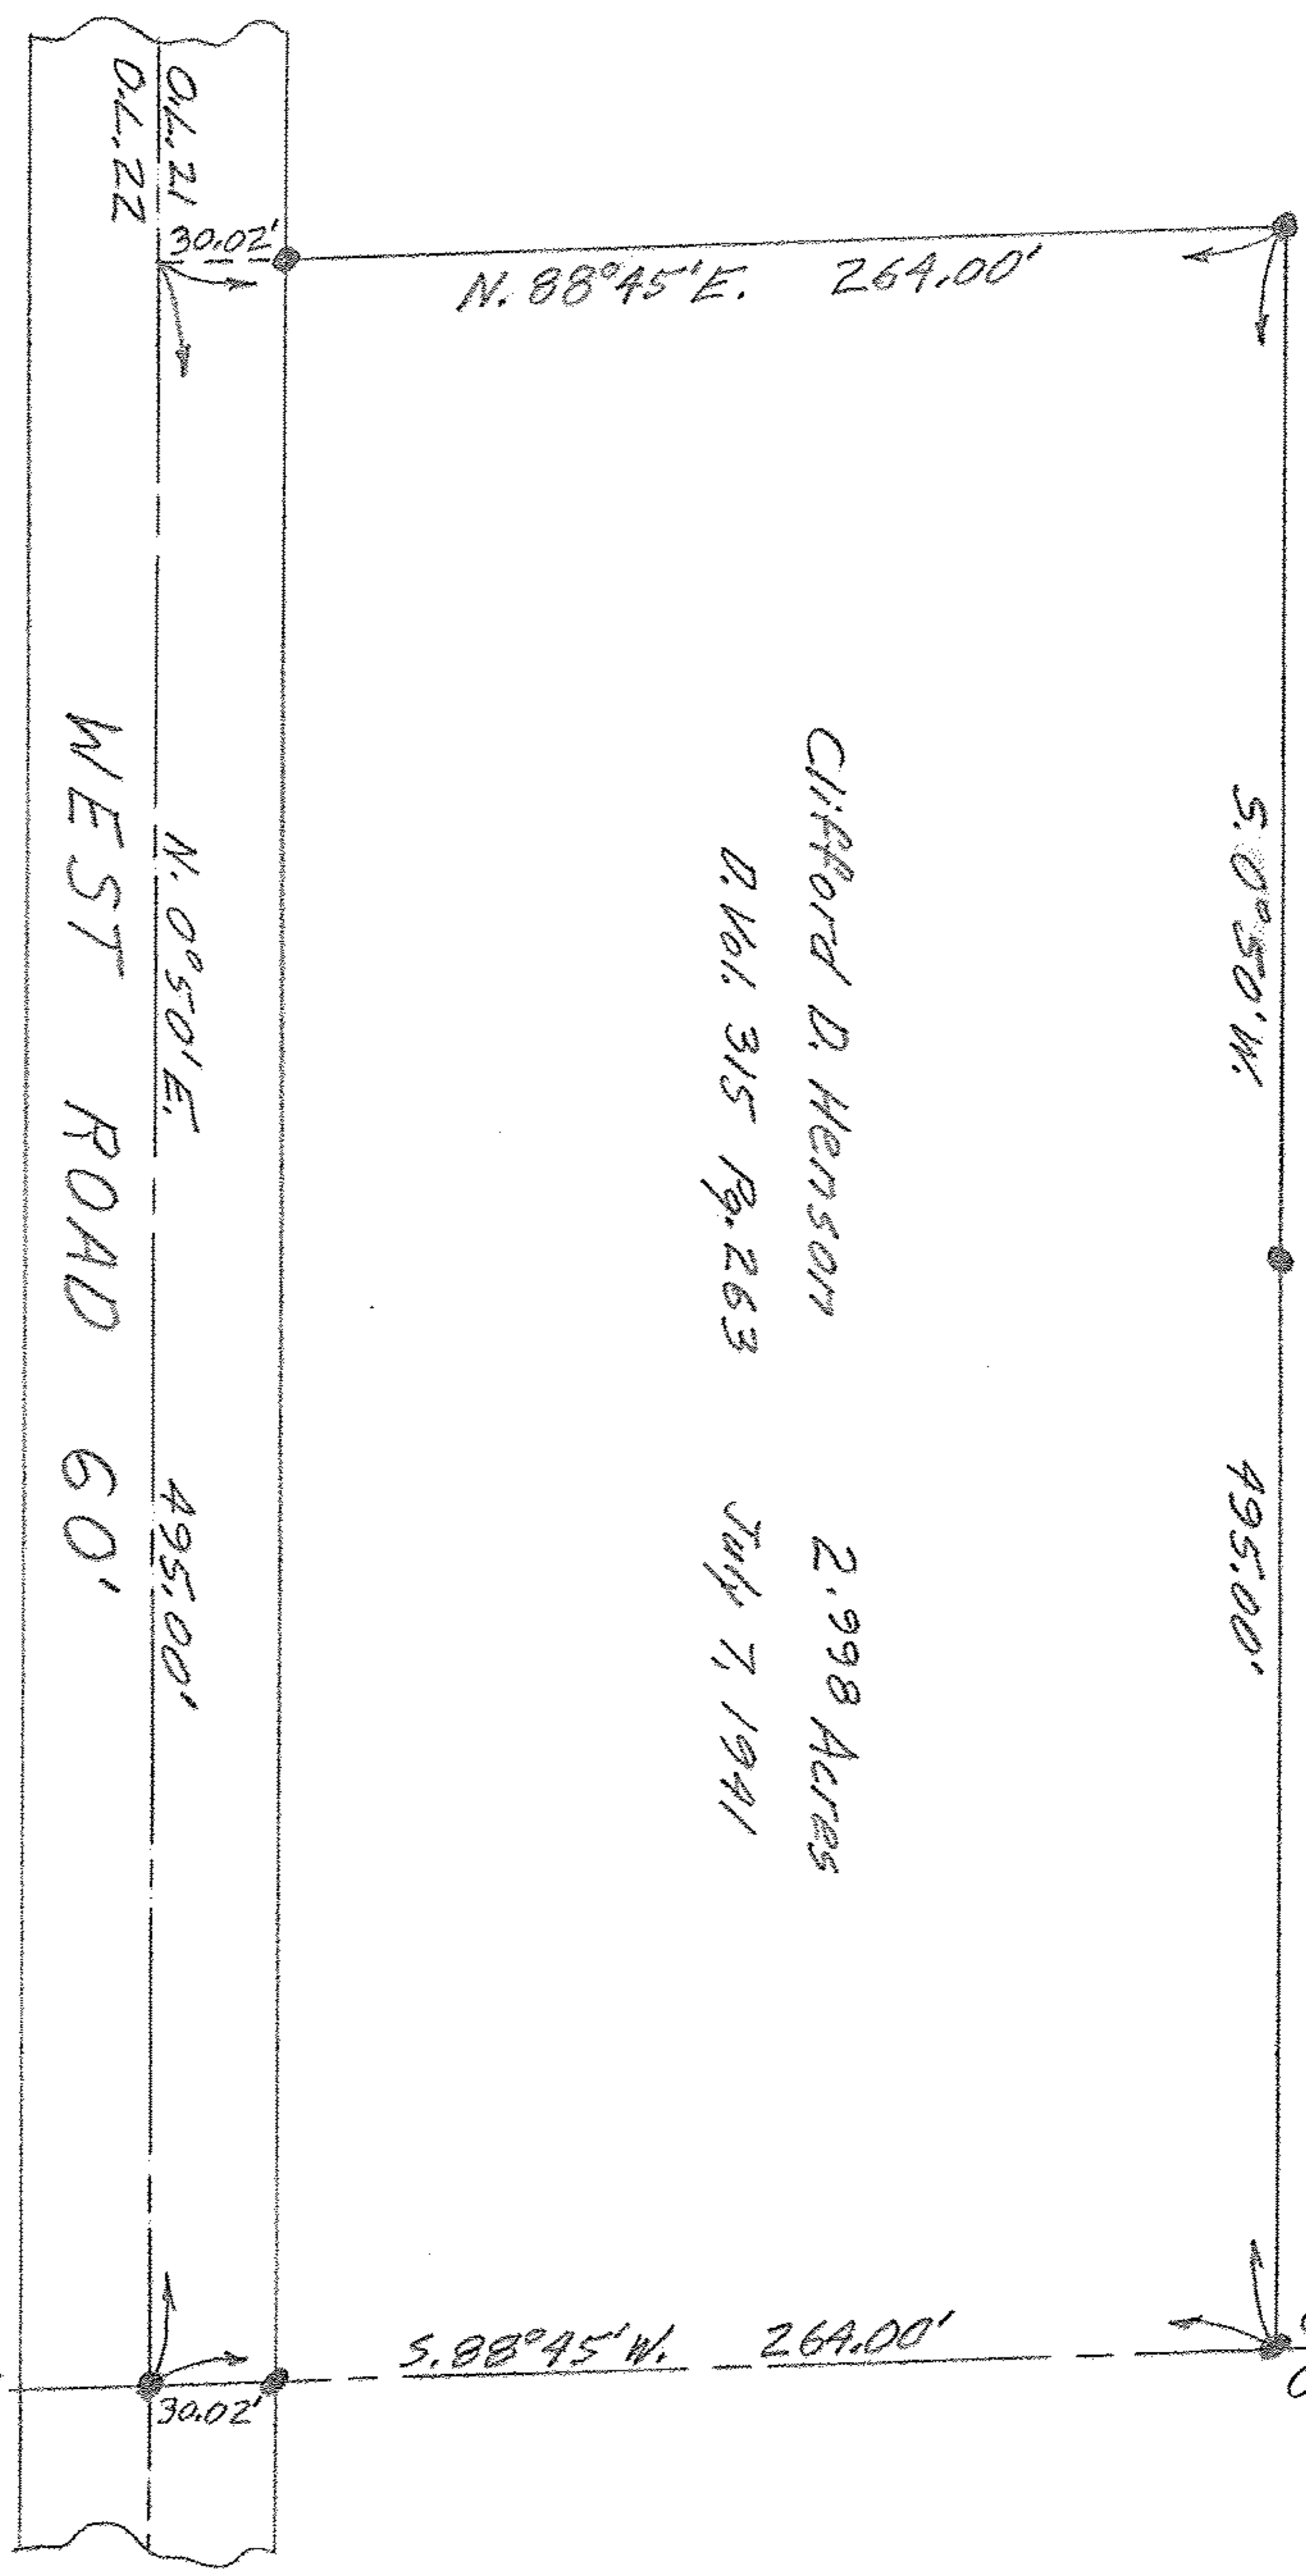

CLIFFORD D. HENSON  
 D. Vol. 315 Pg. 263 July 7, 1941  
 2.998 Acres

PLAT OF SURVEY FOR CLIFFORD D. HENSON

ORIGINAL LOT 21 PITTSFIELD TOWNSHIP  
 LORAIN COUNTY OHIO

SCALE: 1" = 60'  
 MARCH 25, 1959  
 GARY E. PENFOUND REG. SURVEYOR NO. 4457

NOTE: ● designates iron pin set.