


Joseph A. Brassai Feb. 10, 1950 D. Vol. 484 Pg. 242

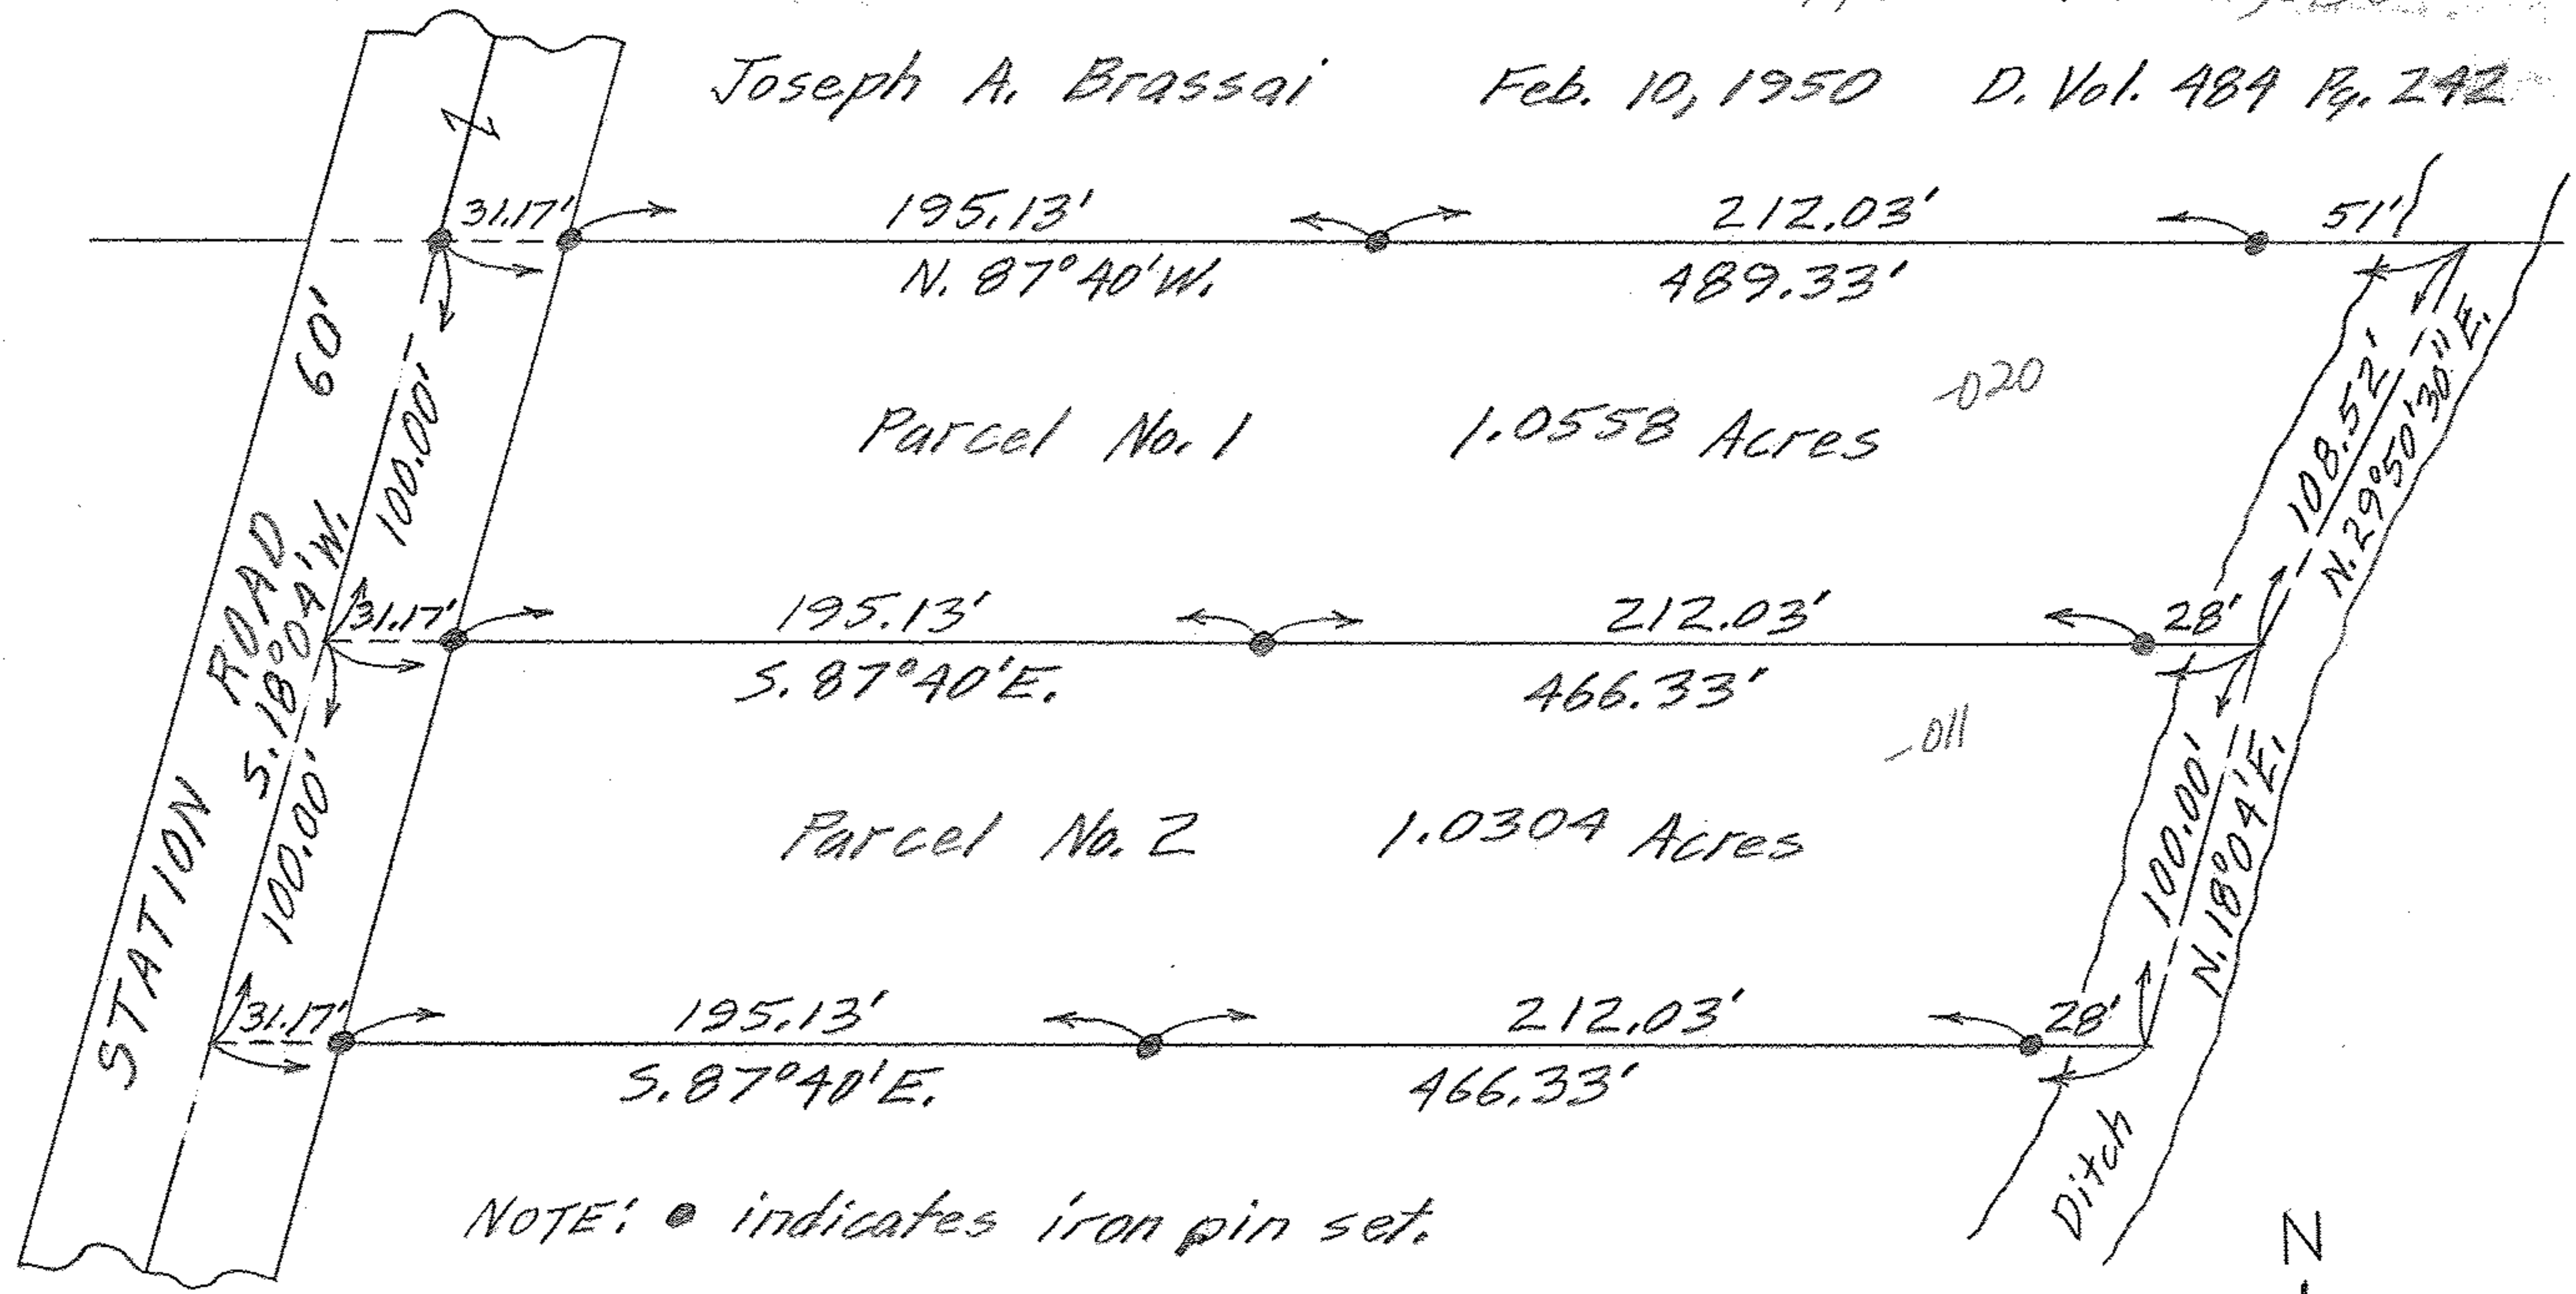

NOTE: • indicates iron pin set.

PLAT OF REVISED SURVEY FOR
RICHARD J. & ADELAIDE RUTH HAENDIGES
ORIGINAL LOT 75 COLUMBIA TOWNSHIP
LORAIN COUNTY OHIO

SCALE: 1" = 60' MAY 31-1963

Gary E. Penfound Reg. Surveyor No. 4457

REVISION OF PARCELS NOS. 1 & 2 SURVEYED AUGUST 16-1960

