
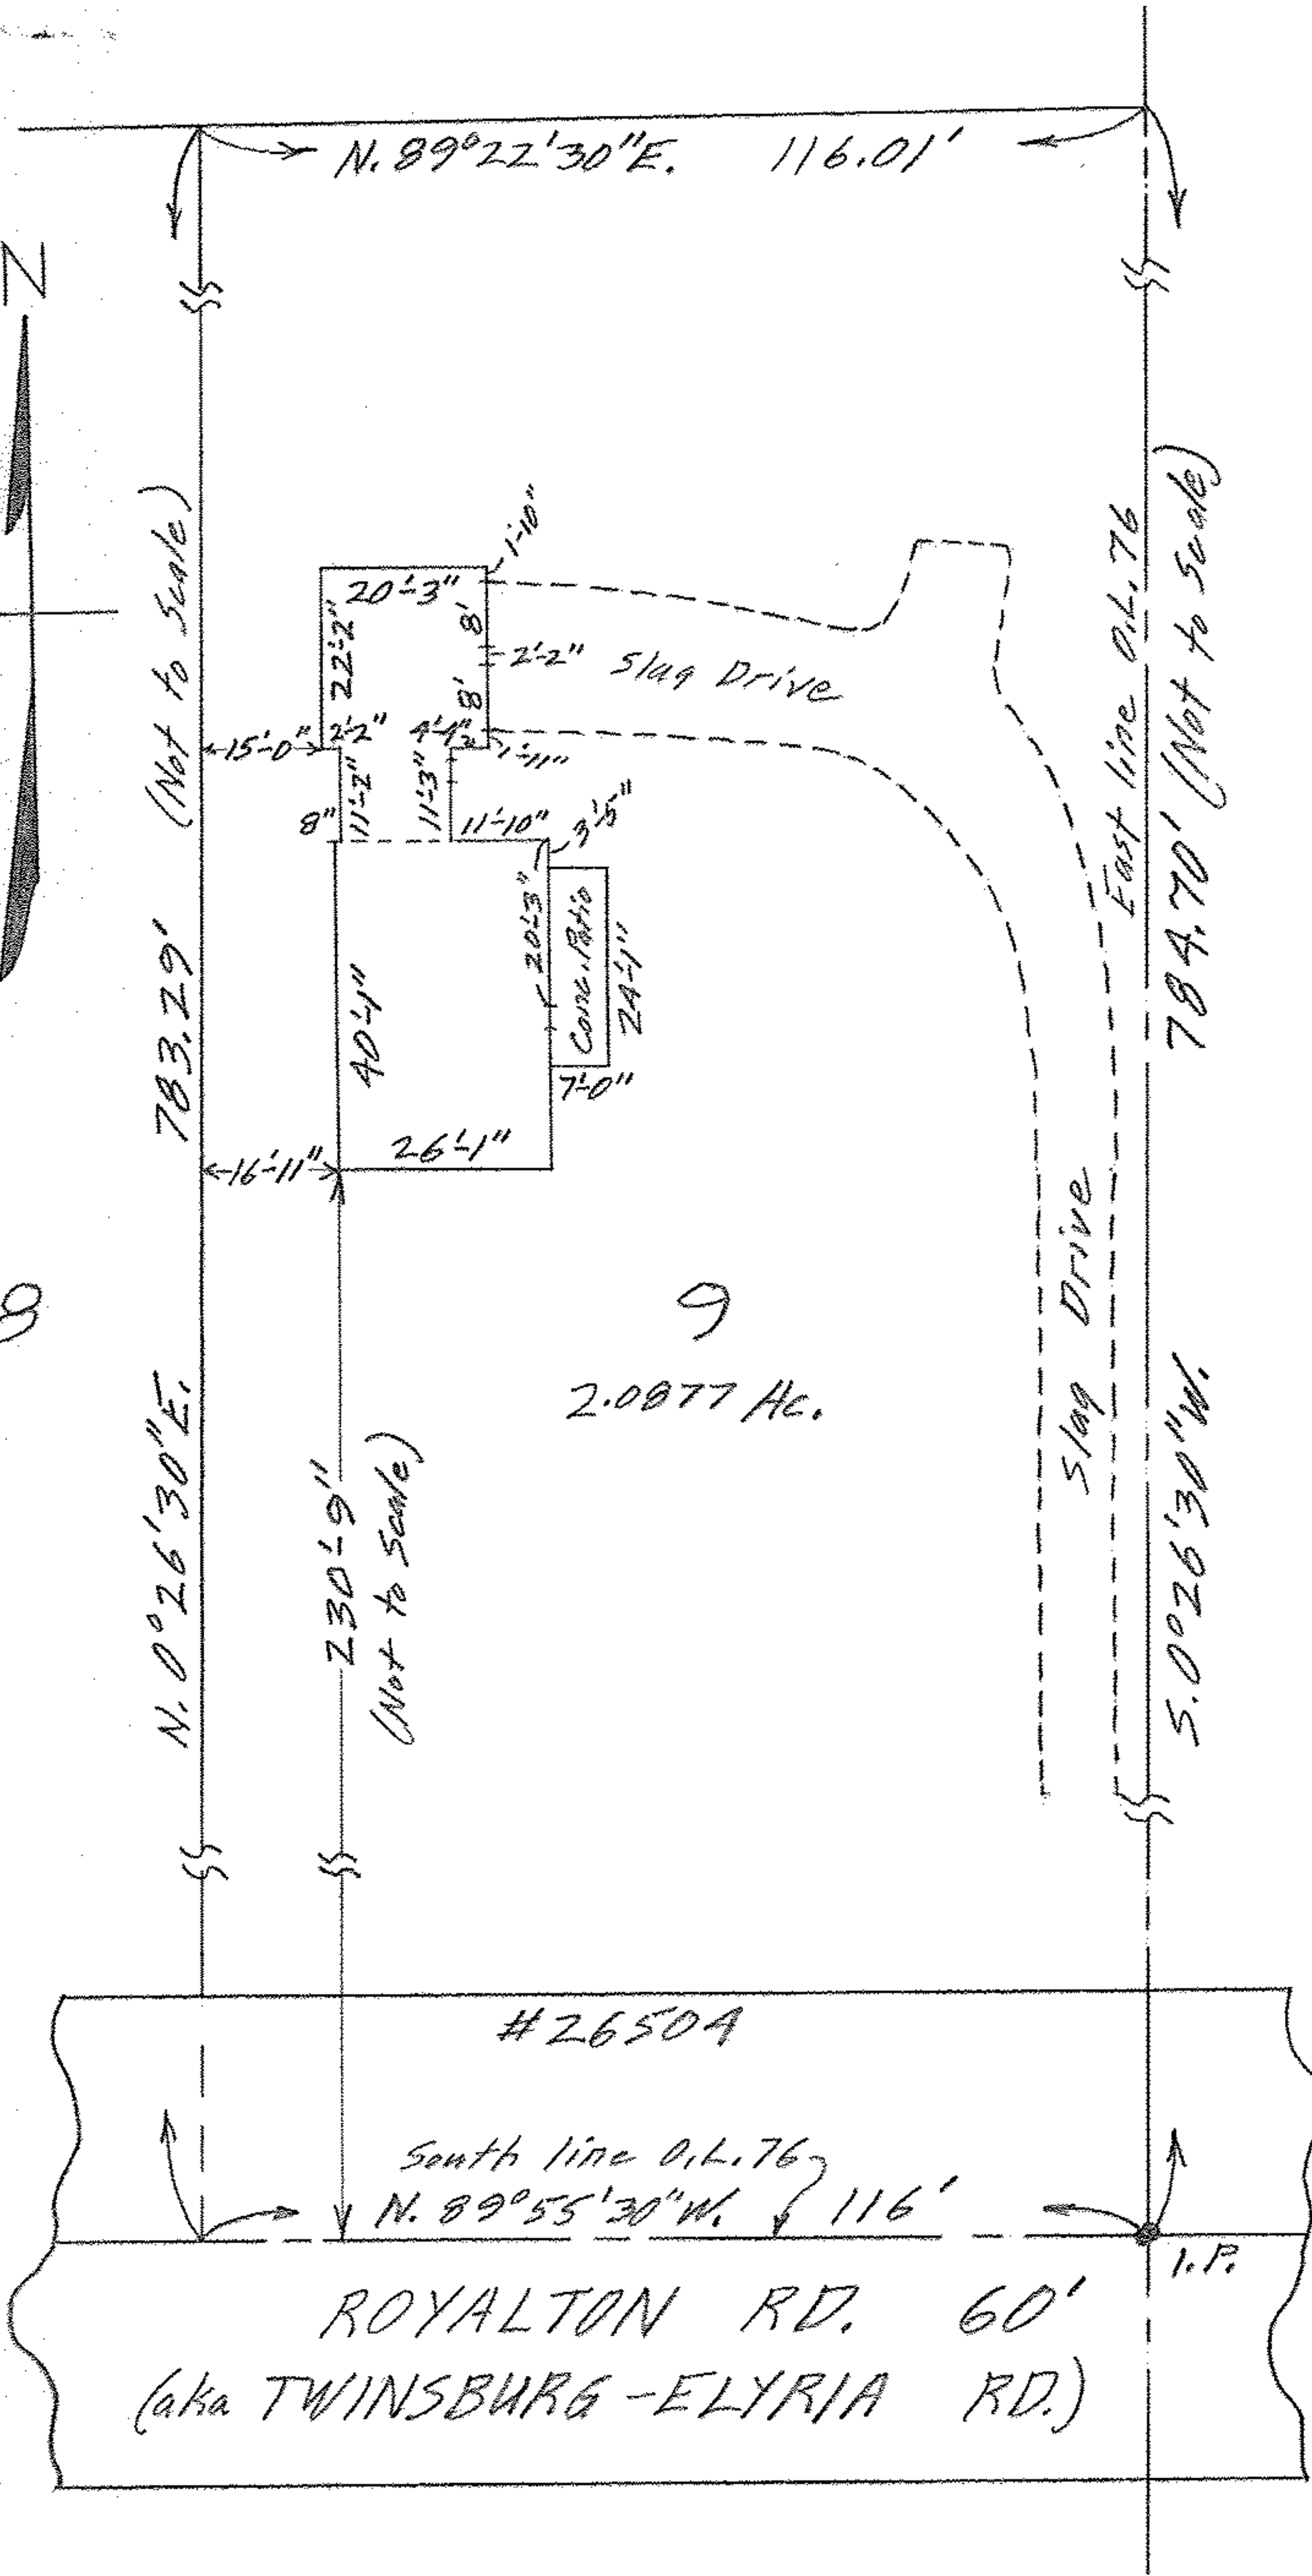


17-00-076-103-018 12-00-076-08 scan # 48167

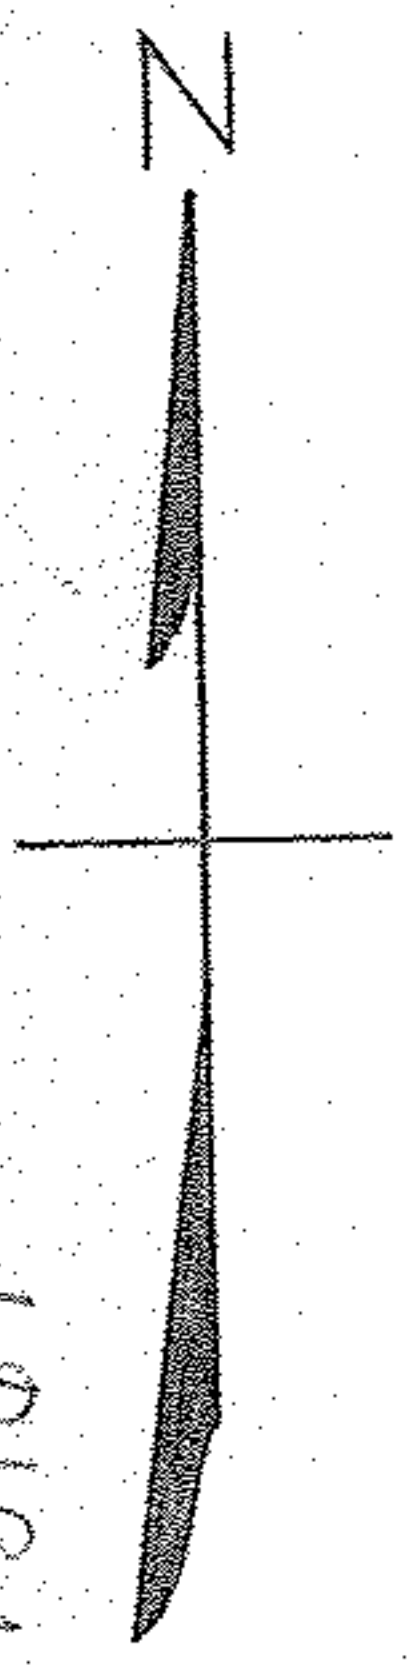

MAP OF SUB-LOT NO. 9
 HUMMON SUBIN. NO. 2 VOL. 16 Pg. 255-A
 ORIG. LOT 76 COLUMBIA TOWNSHIP
 LORAIN COUNTY - OHIO
 SCALE: 1"=30' DEC. 17-1963 2:30 P.M.
 Gary E. Penfound REG. SURVEYOR
 Thomas J. & Joanne Longworth W W