


Marshall D. & Jean K. Sowers

D. Vol. 820 P. 484

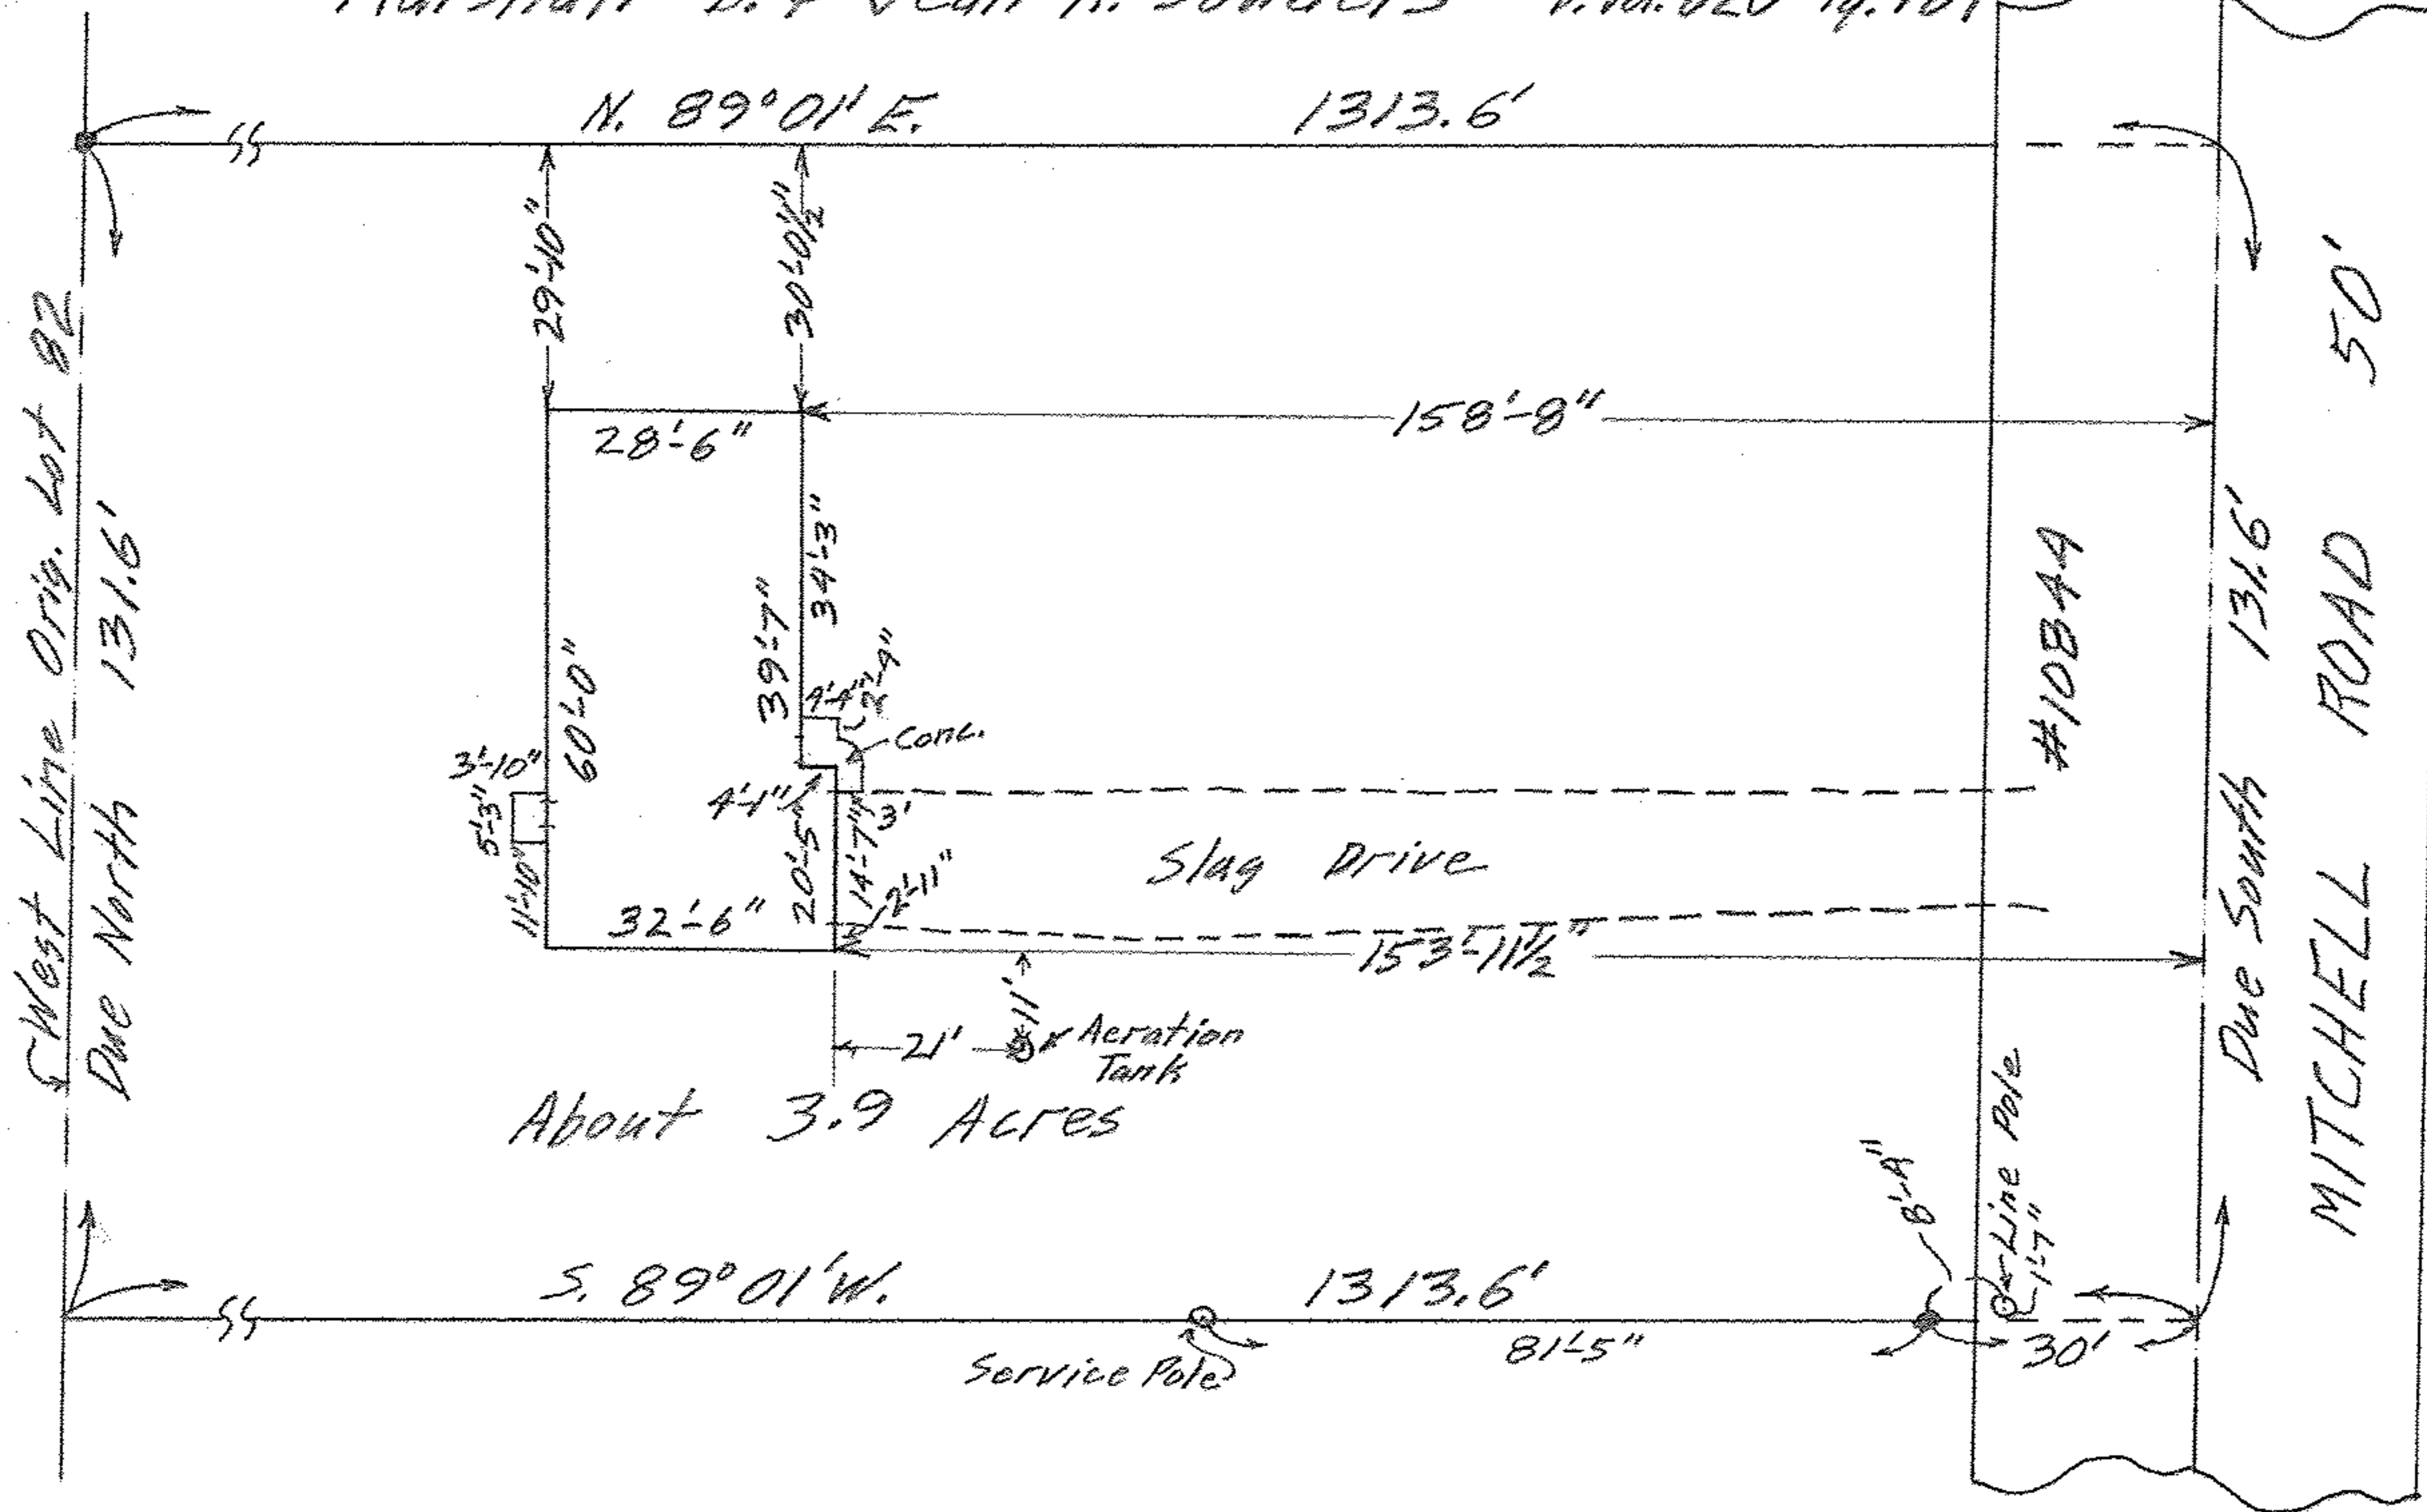

DETAIL SHEET OF PART OF ORIG. LOT NO. 82
 COLUMBIA TWP. LORAIN COUNTY OHIO
 DETAIL SCALE: 1" = 30' OCT. 1-1963 12:15 P.M.
 Gary E. Penfound REG. SURVEYOR

Gene R. & Nancy A. Yost W W