


SCAN# 48202 15:00:45-0 15:00:45 101 -02D

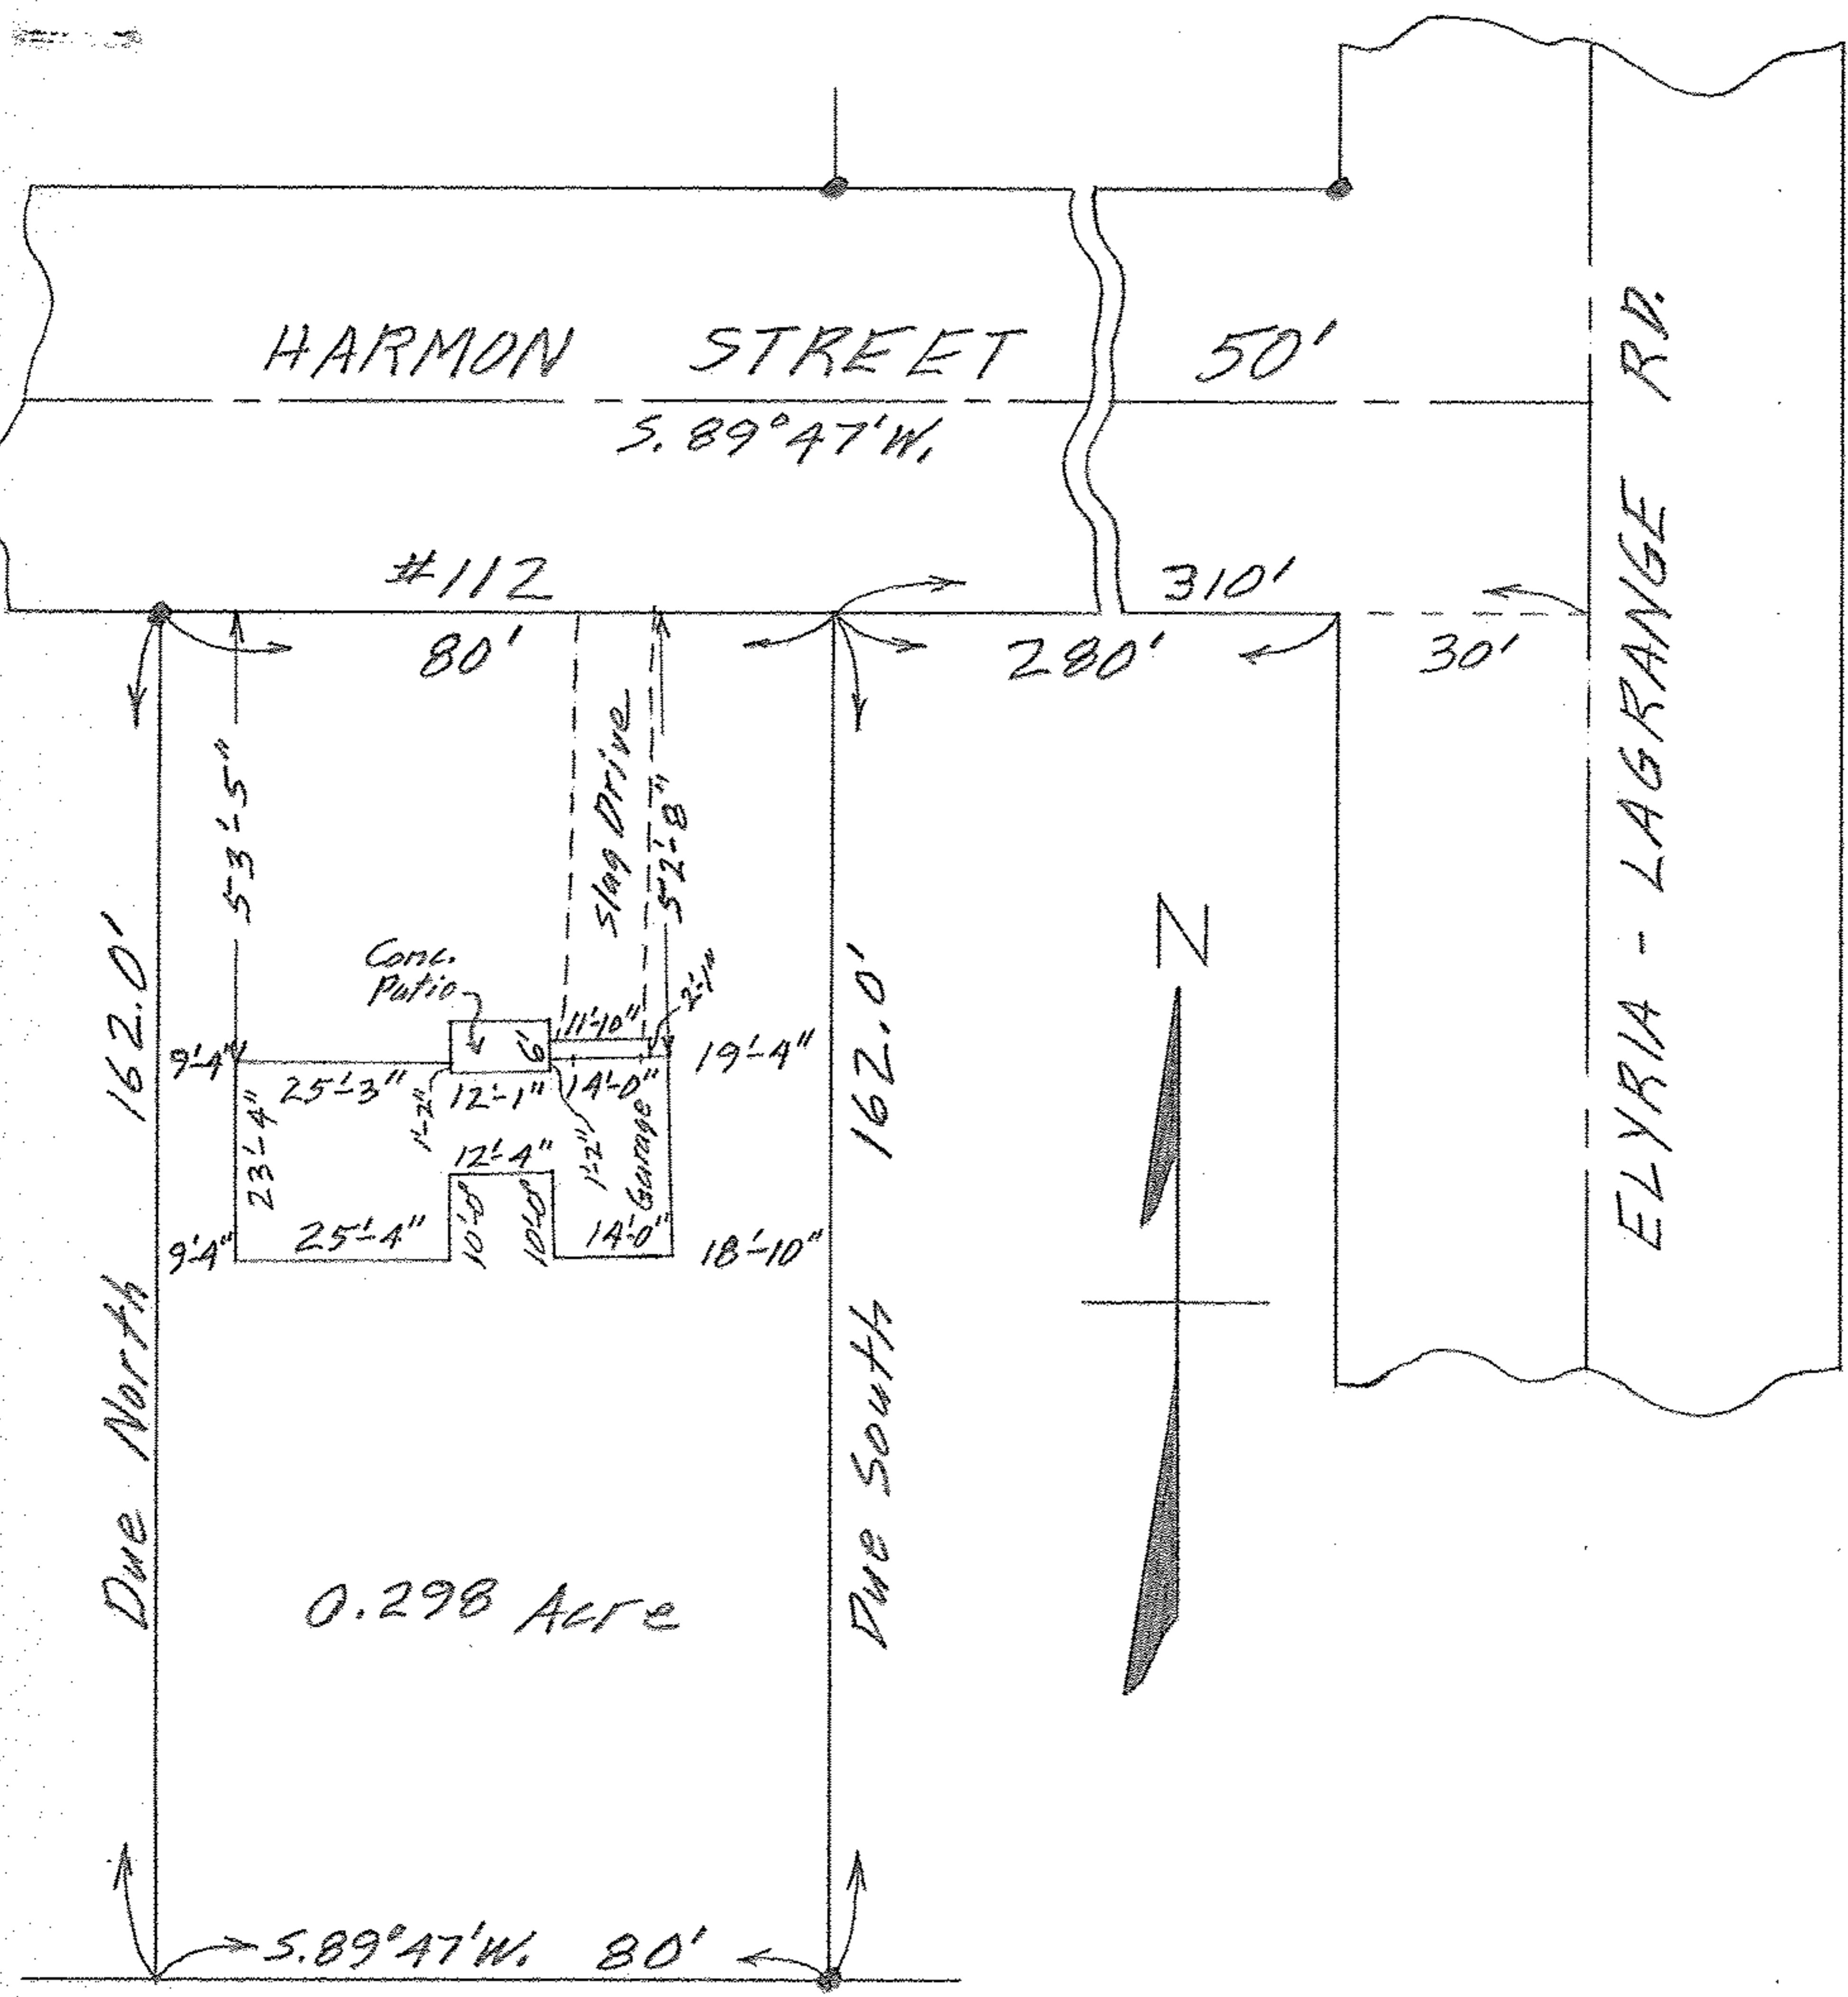

MAP OF PART OF ORIGINAL LOT NO. 45
 LAGRANGE TOWNSHIP & VILLAGE
 LORAIN COUNTY OHIO
 SCALE: 1"=30' JULY 31-1964 6:15 P.M.
 Mary E. Penfound REG. SURVEYOR

BERKS TITLE INS. CO.
 Harry C. Bogart, Agent

Opha C. & Adelaide Bell