

Scan# 482226 15 H 15-00-070-00-012


MAP OF PART OF ORIGINAL  
LOT NO. 70 LAGRANGE TWP.

LORAIN COUNTY - OHIO



SCALE: 1" = 40' JUNE 15-1967 11:30 A.M.

Gary E. Penfound REG. SURVEYOR

Southeasterly Line  
Victor W. Hoffman  
D. Vol. 891 P. 210

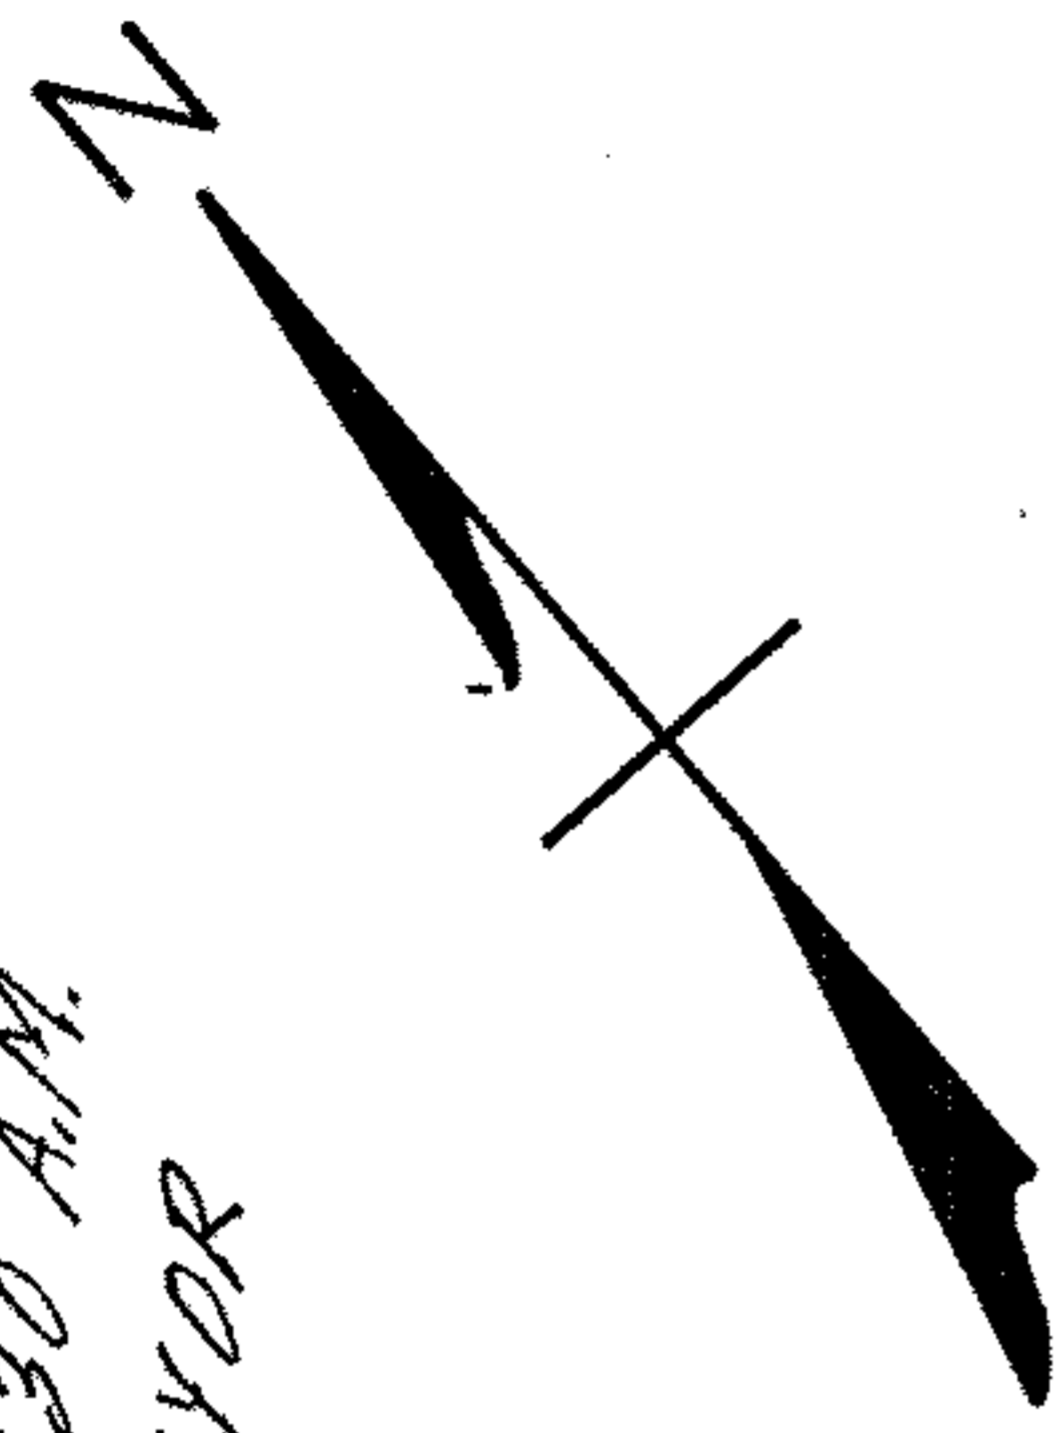

VERMONT STREET 60'

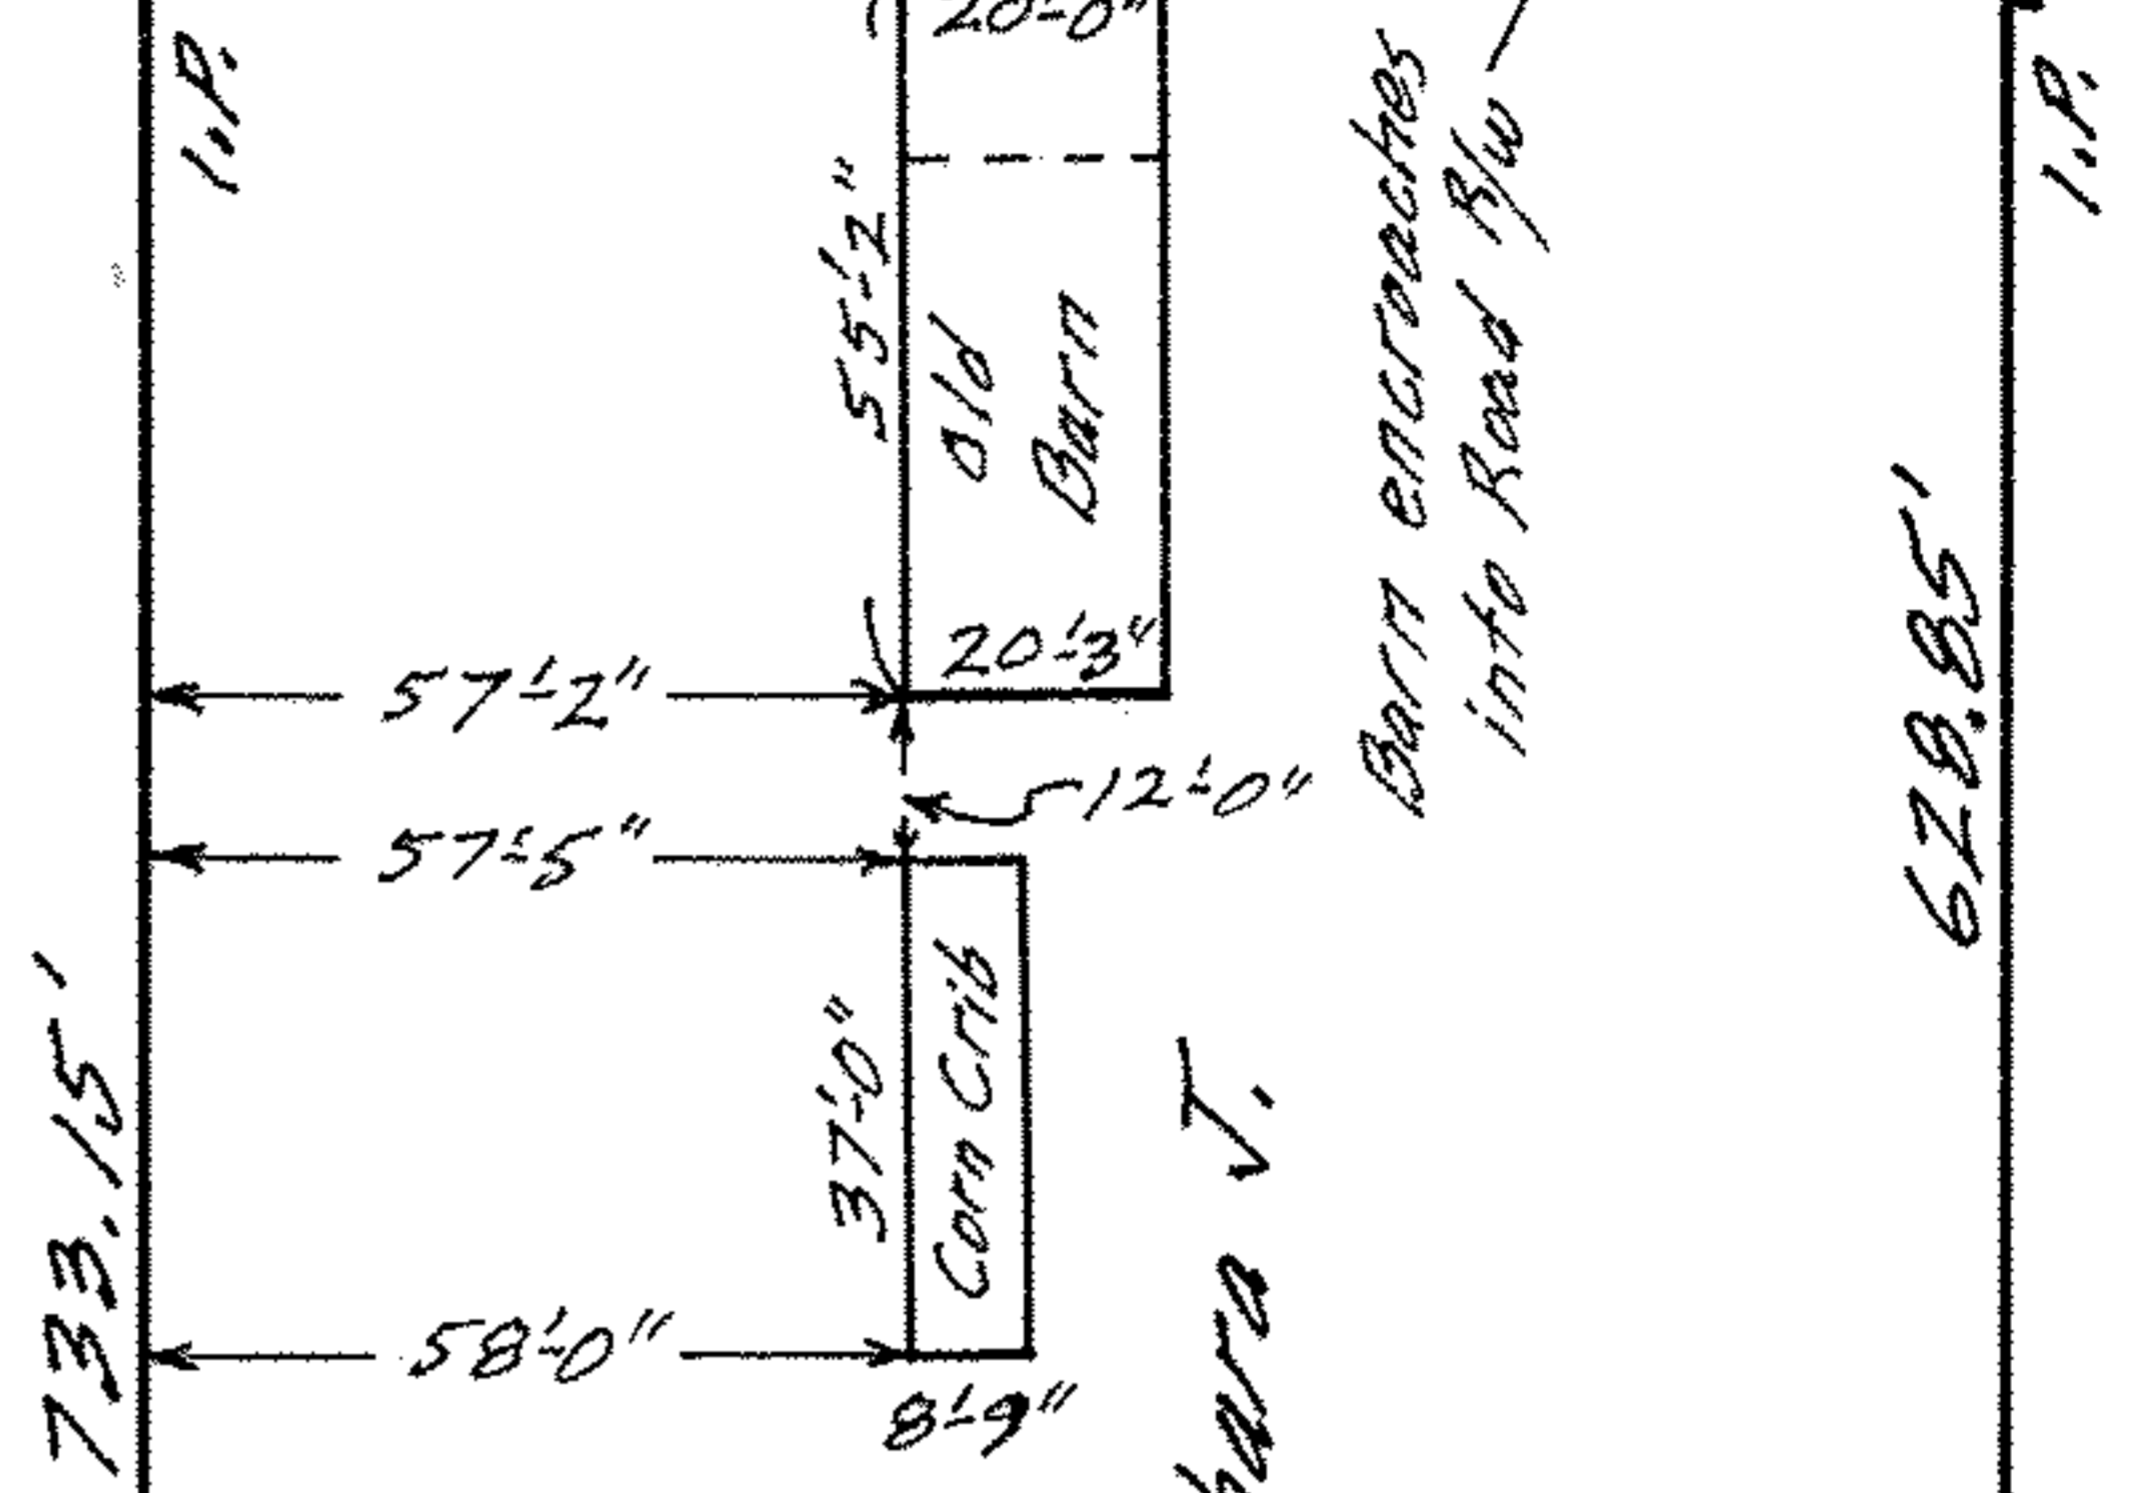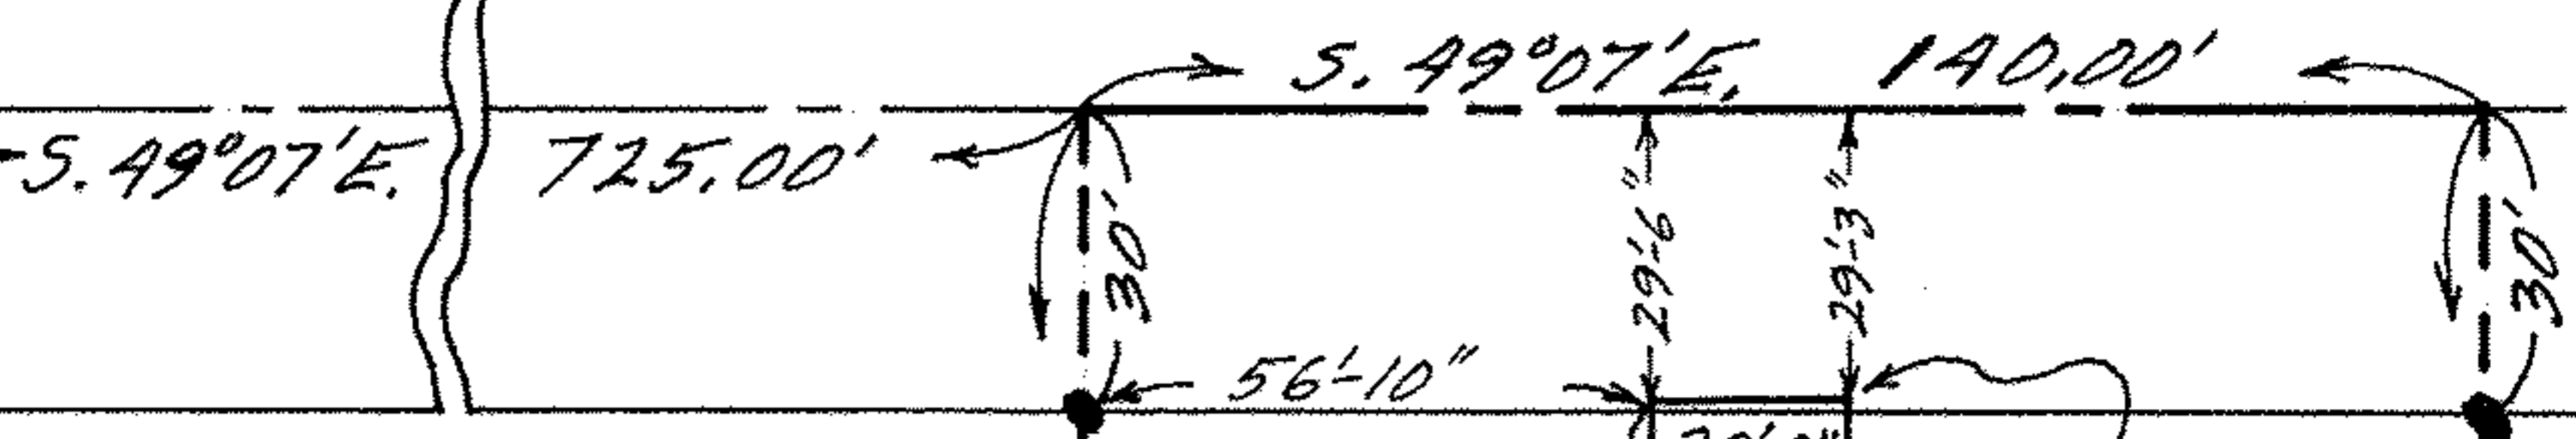

2.188 Acres

Richard A. & Barbara J.  
Koenig

N. 40° 53' E.

N. 85° 48' W.  
BLACK RIVER

174.57'

S. 40° 53' W.