
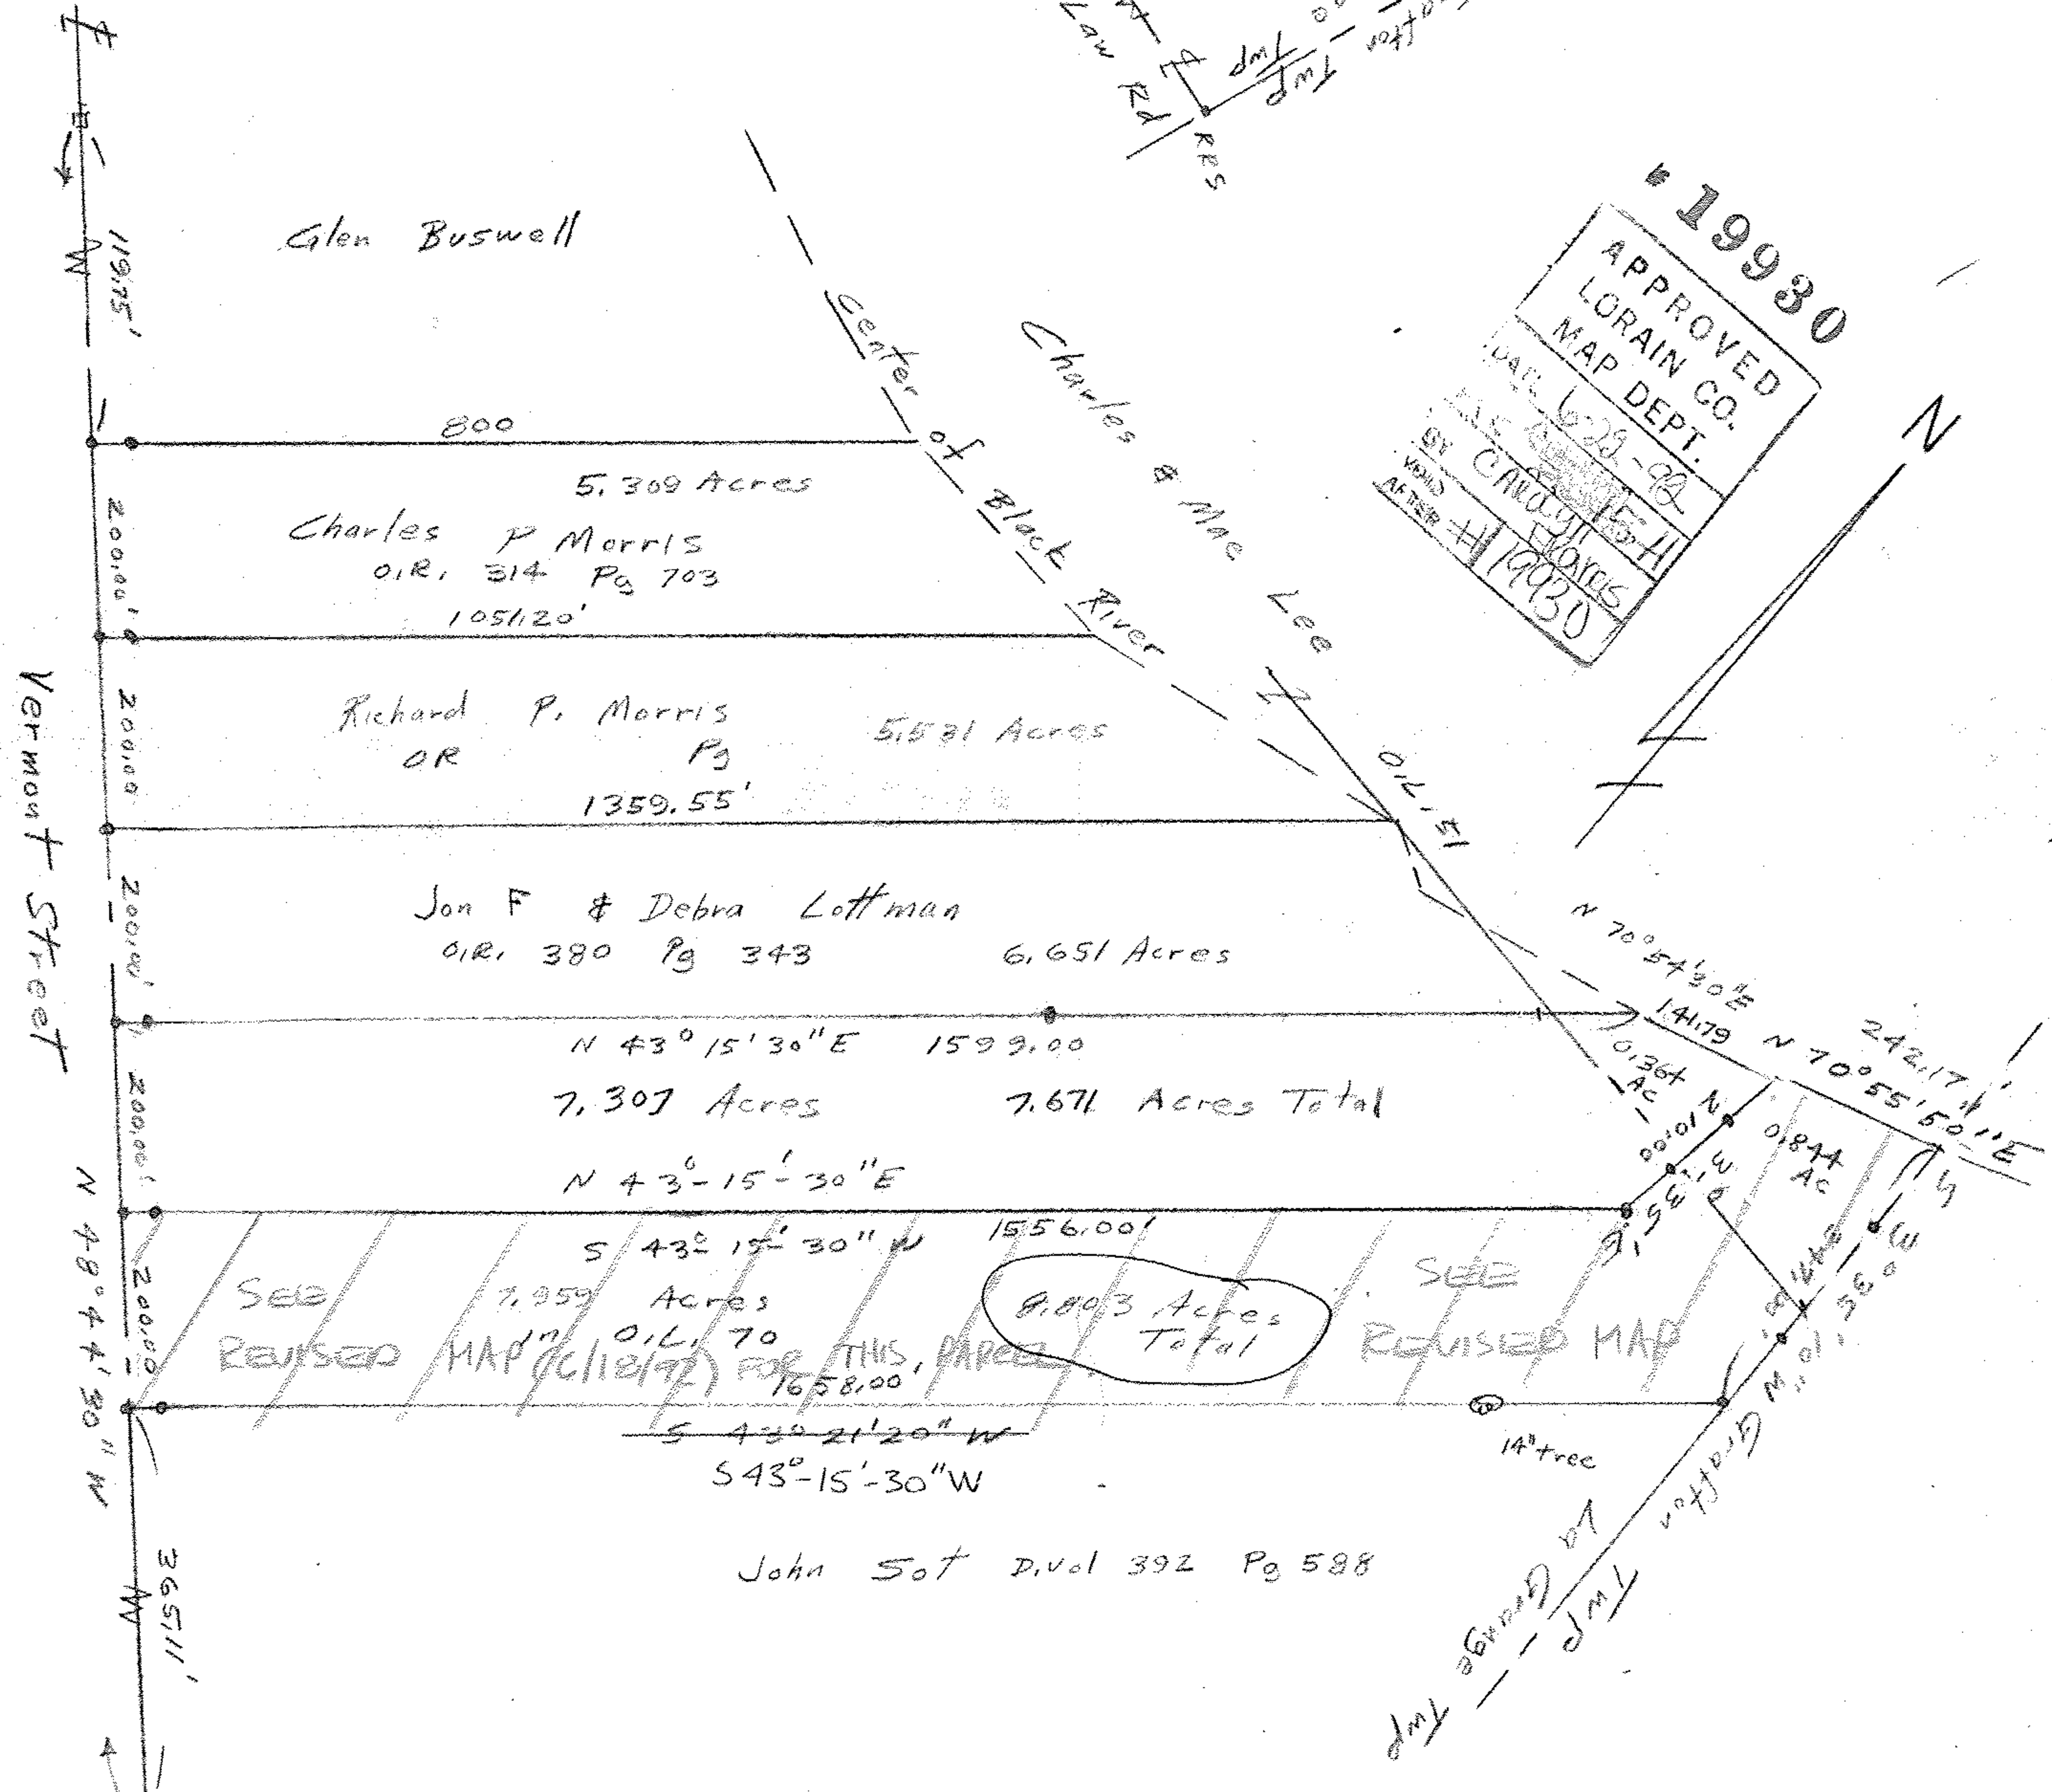
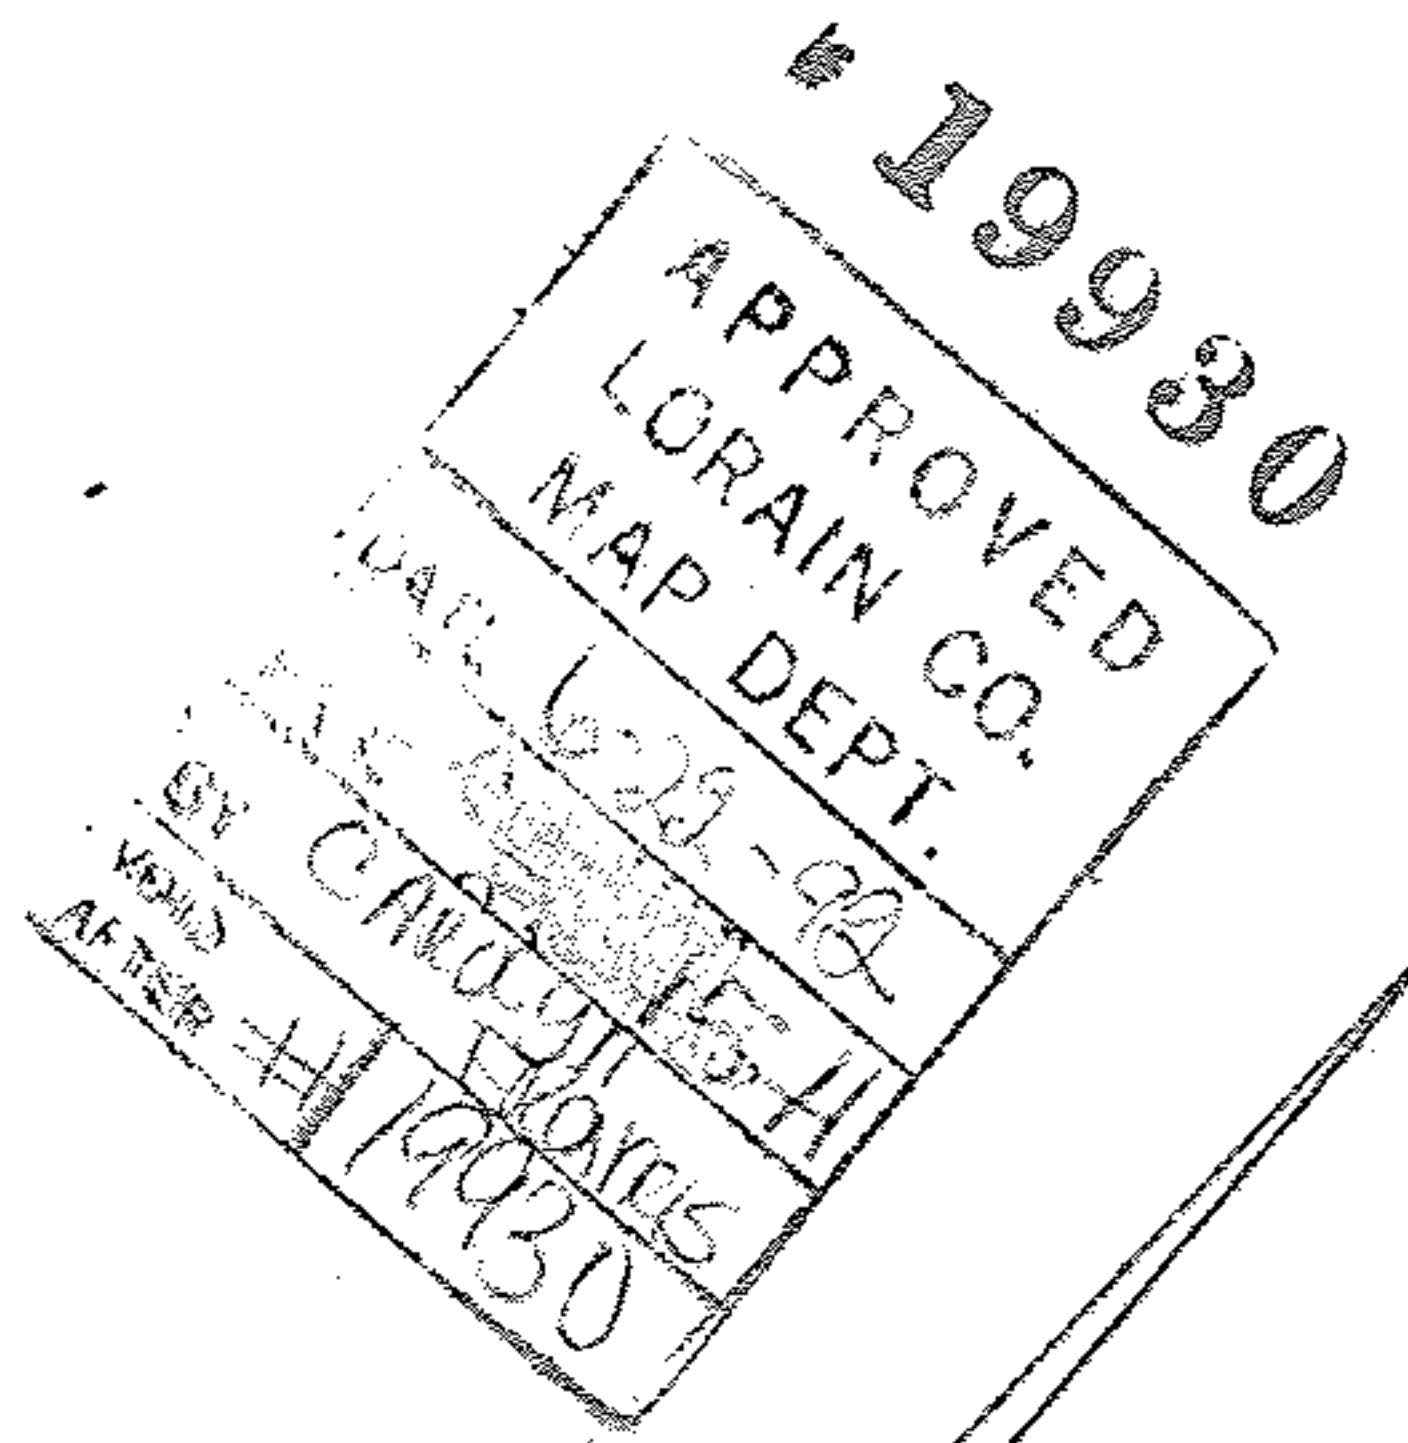


John Pozywak  
Reg. Surveyor  
5292

- Iron pipes fd
- Iron pipes or RLS set
- Monument Boxes

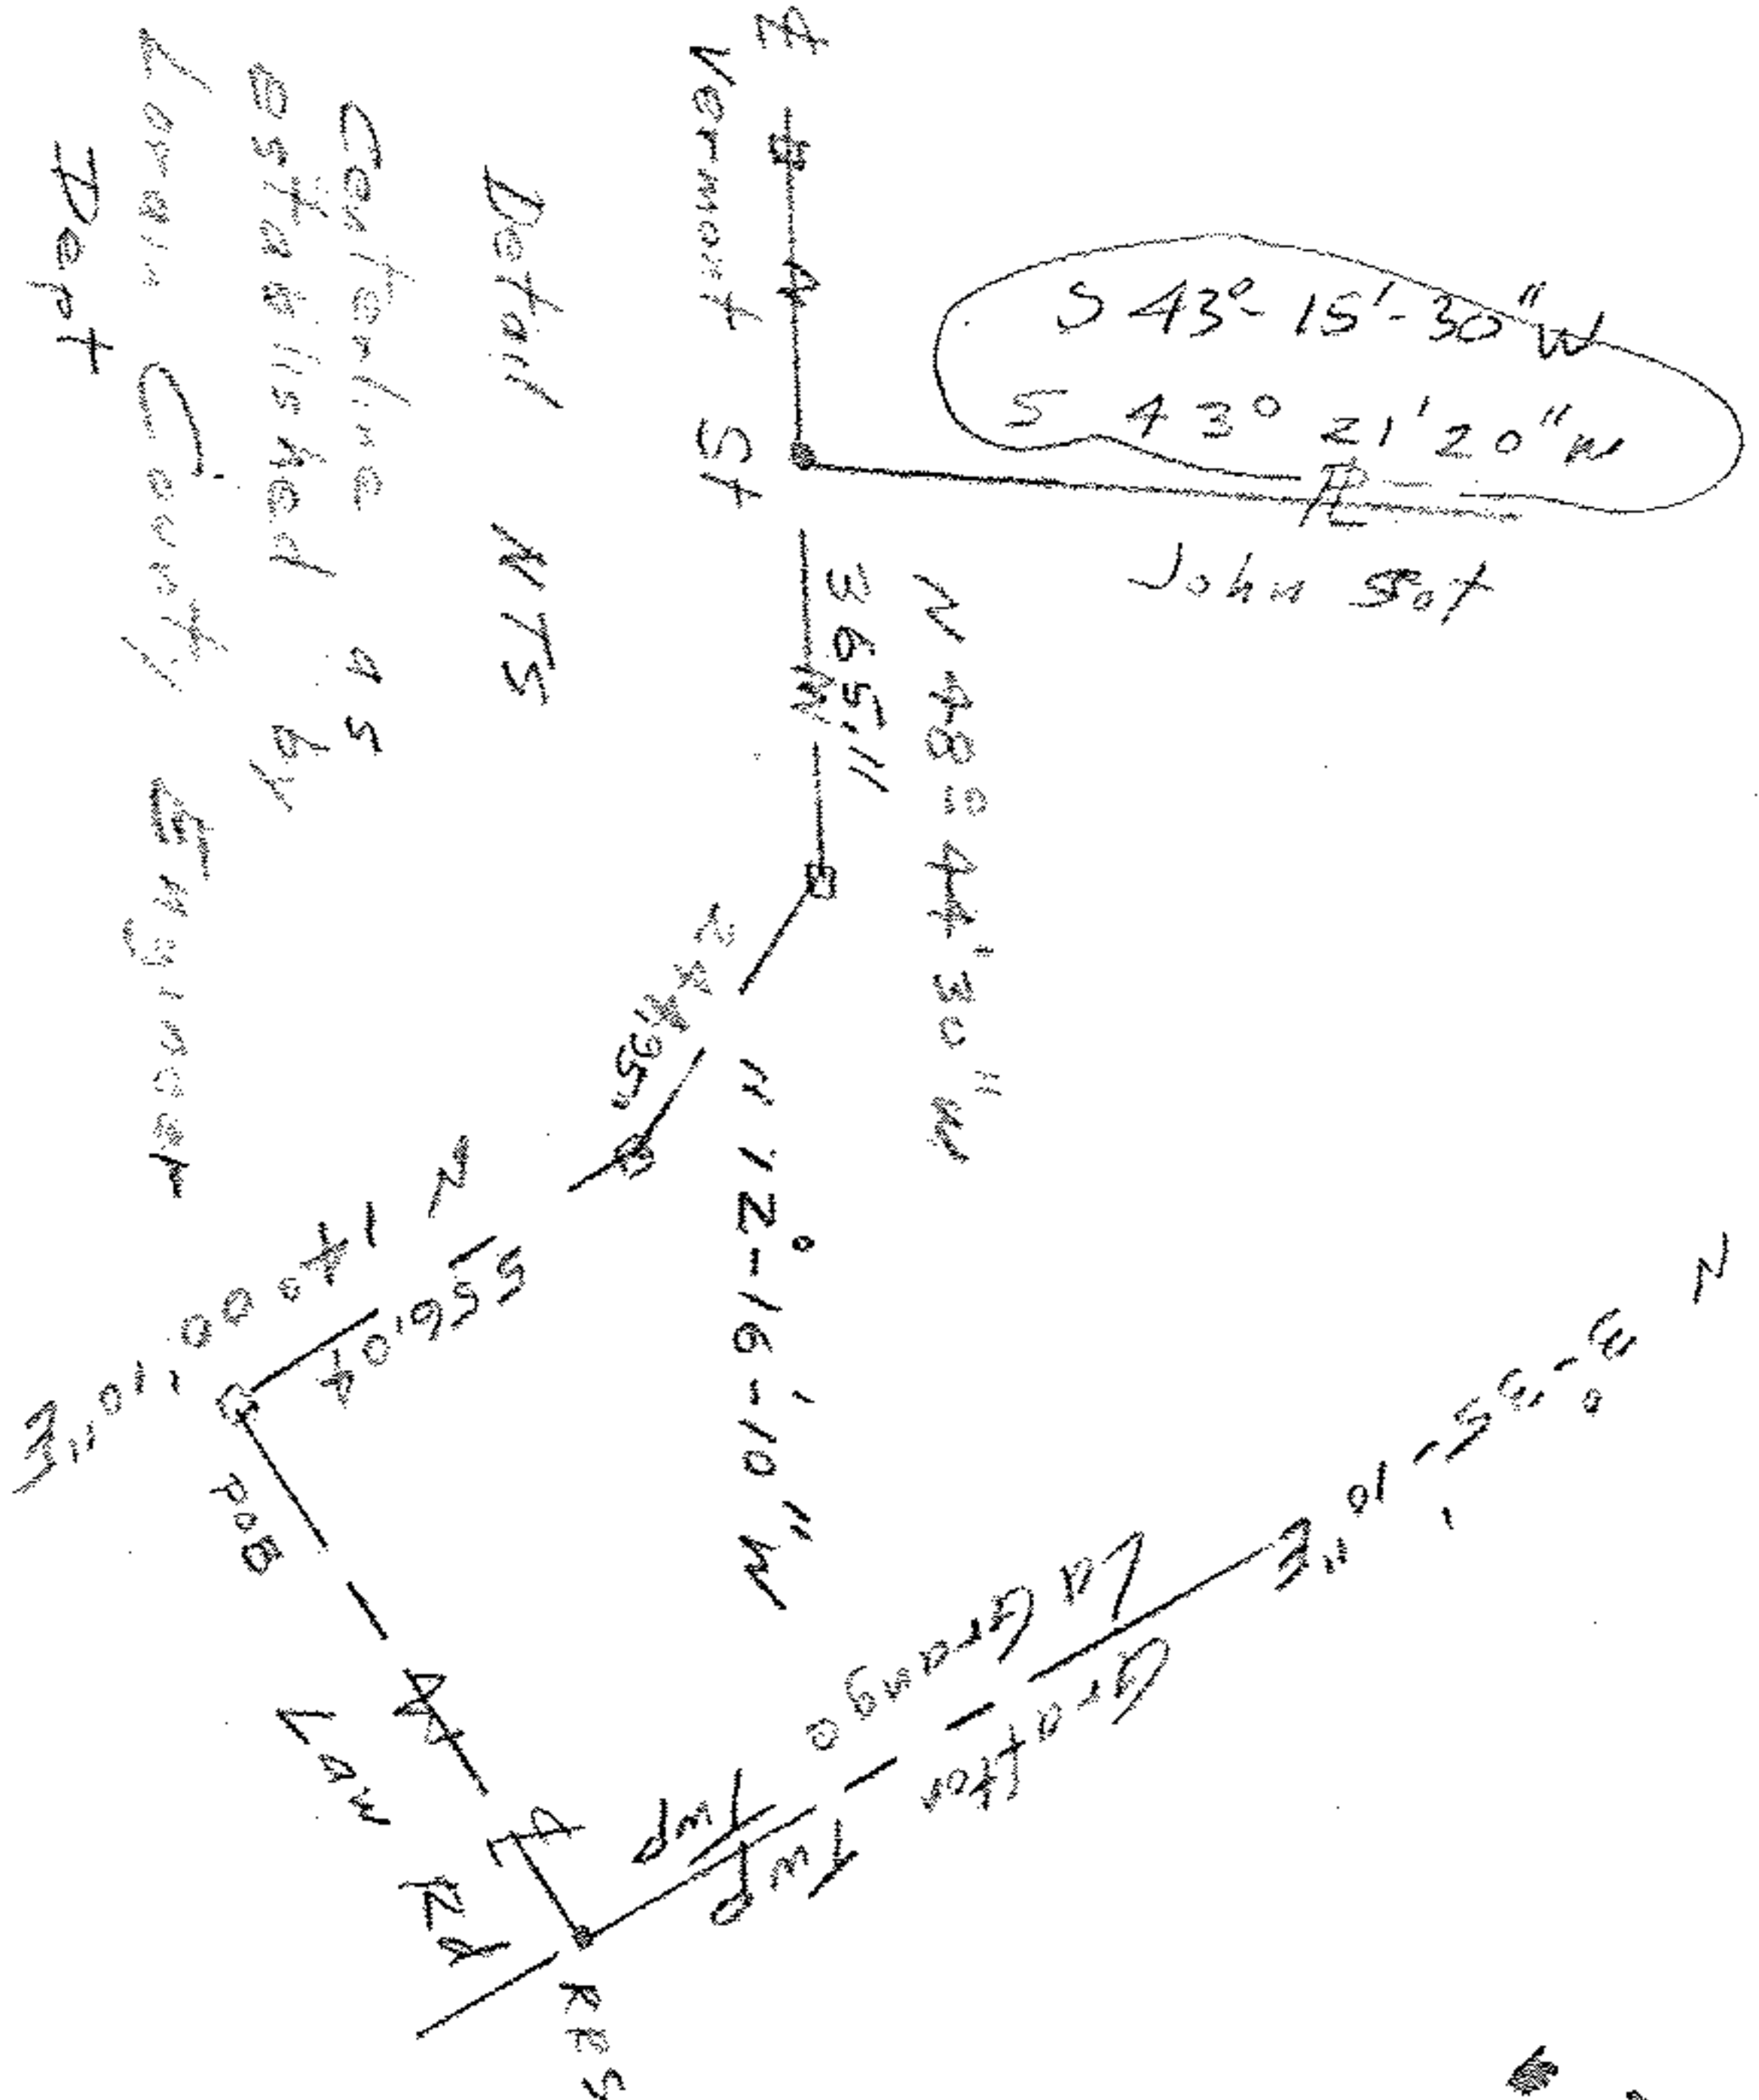

Survey of Parcel splits for  
Glen Buswell  
Part of Original Lots 70 & 51  
LaGrange Township  
Lorain County Ohio  
Scale 1"=200' Jan 14, 1992  
feet

Revised  
6/3/92

