


16-00-001-108
Scan # 48276

9192

R/W Curve Data
D = 1°-32'-32"
R = 2831.93
CB = 2°-57'-16"W
CH = 76.22

R/W Curve Data
R = 1196.28
D = 10°-11'-38"
CH = 212.56

16-00-001-108-028
16-00-001-028

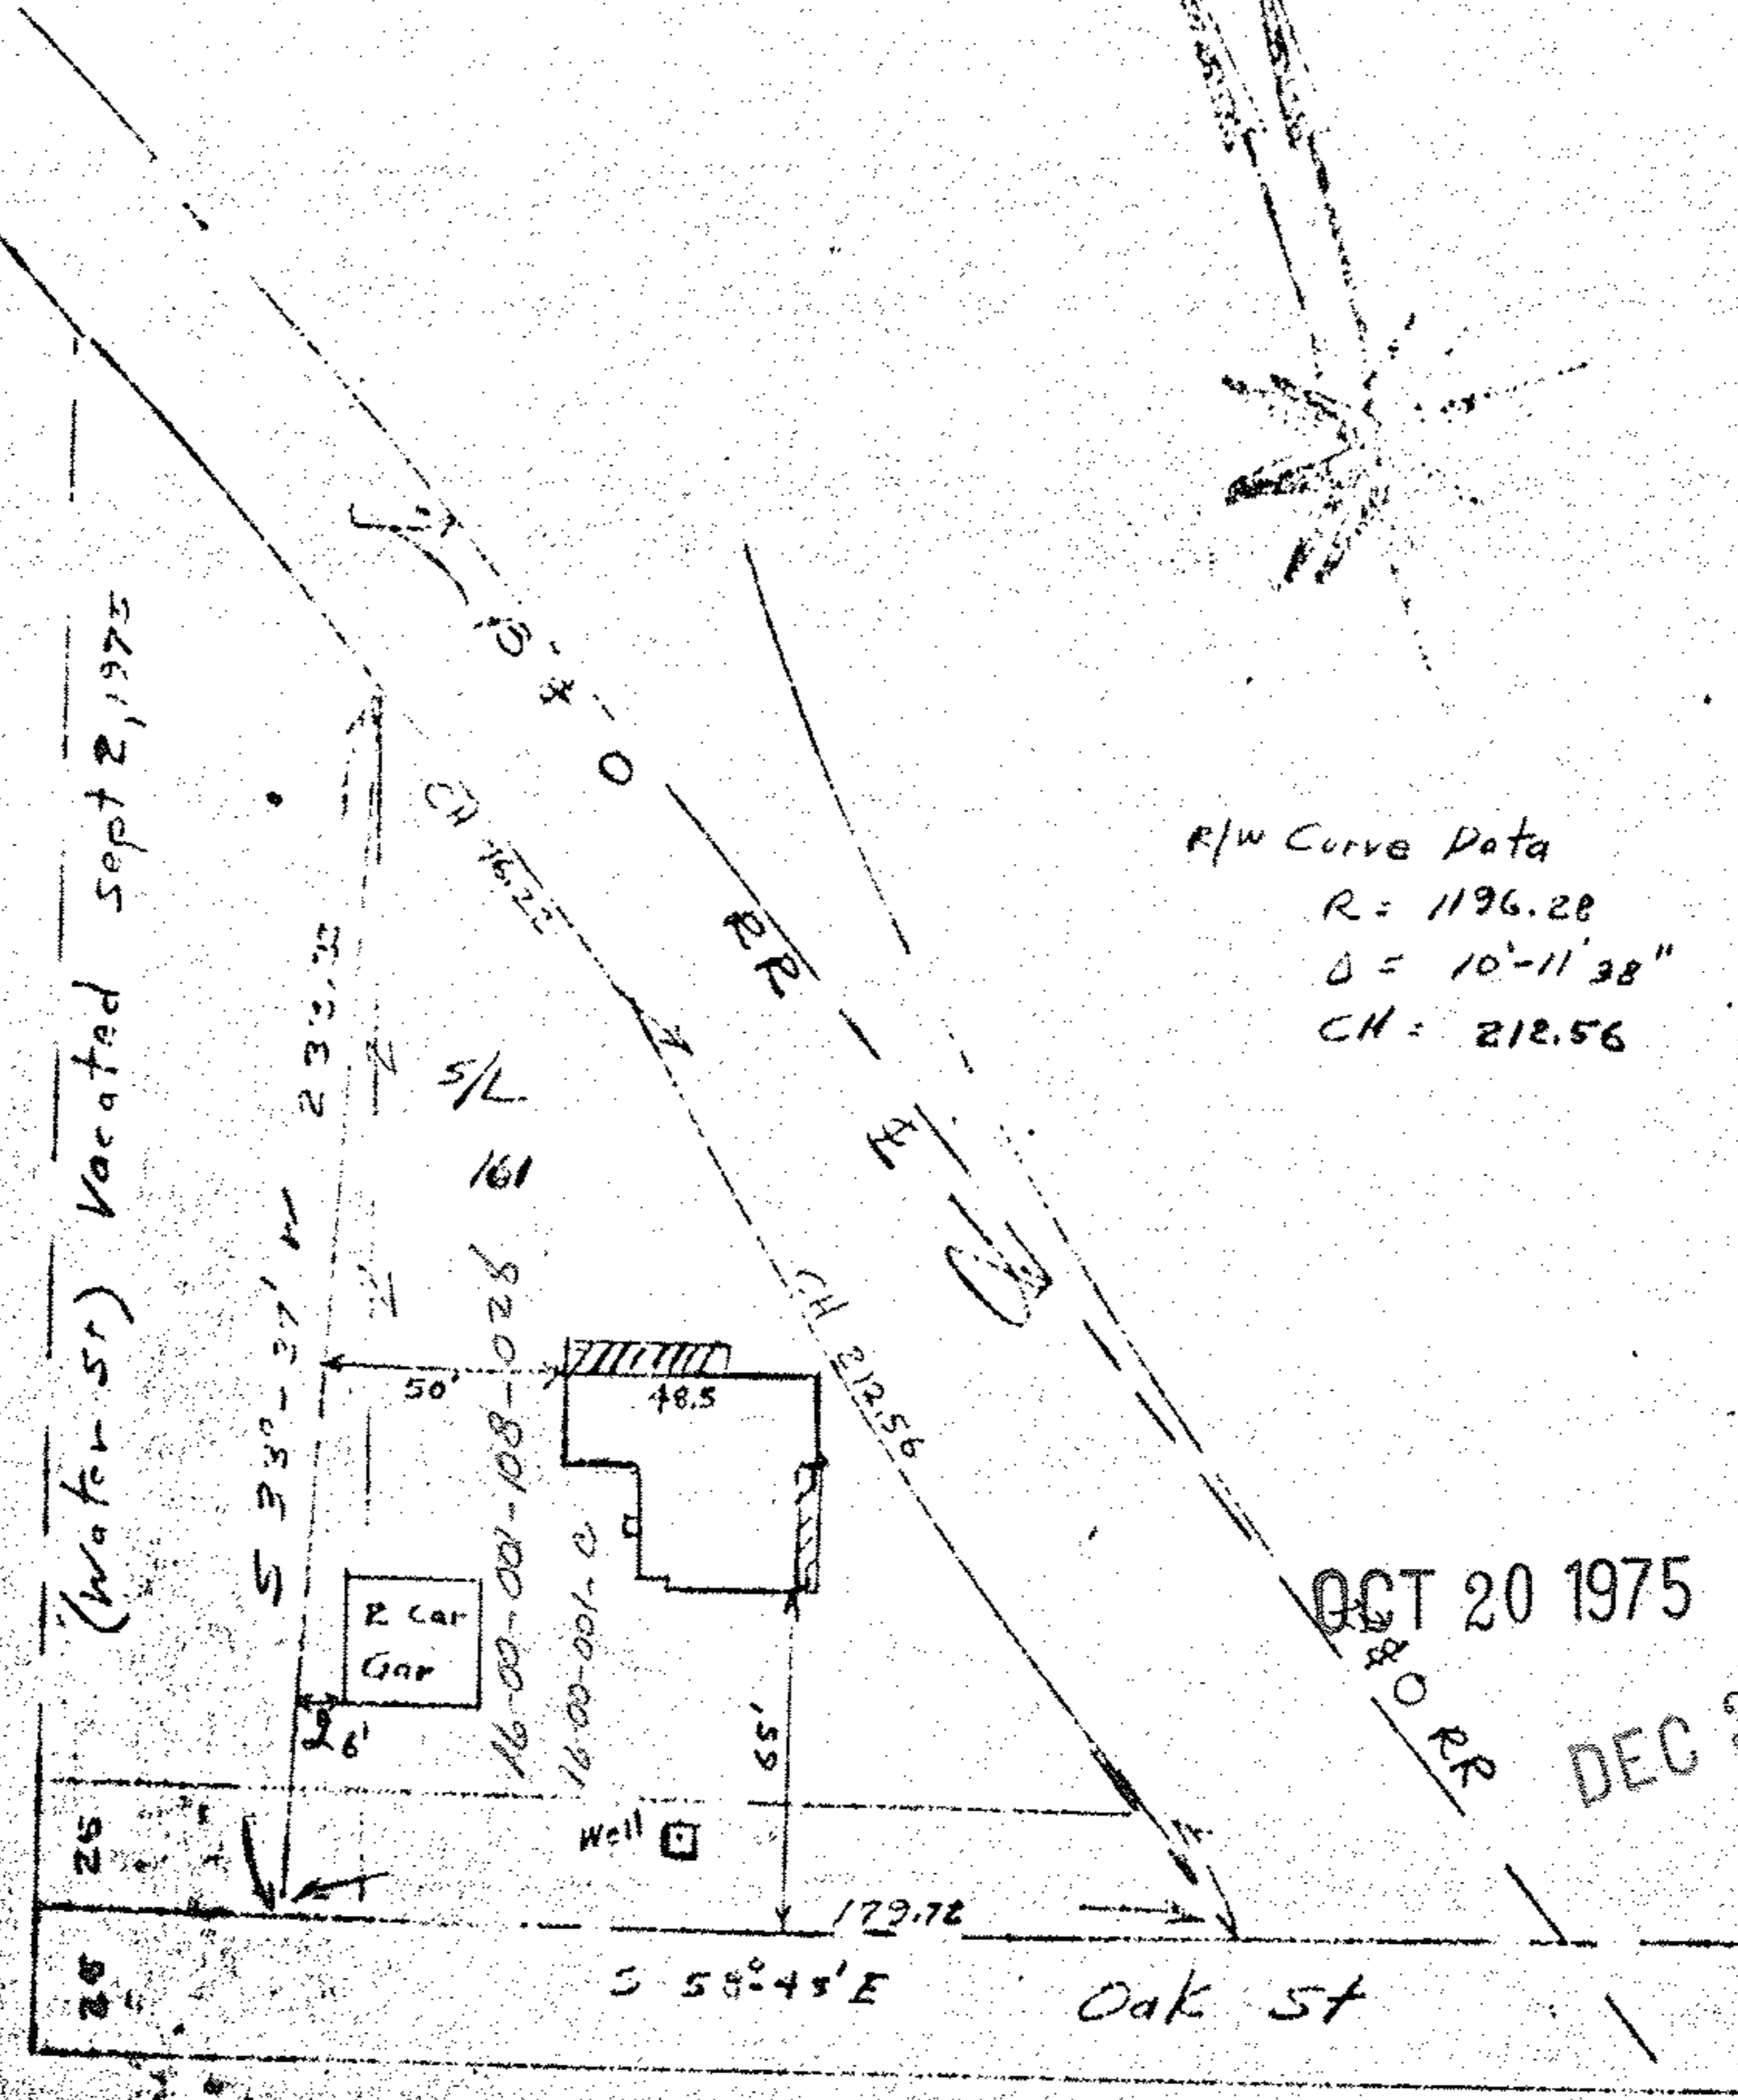

OCT 20 1975
DEC 31 1975

John Poznyak
Reg. Surveyor
292

LOCATION SURVEY ON SUBLOT 161
Part of Original Lot 1
GRAFTON TOWNSHIP
Village of Grafton
LORAIN COUNTY OHIO
Scale 1"=60' Sept 8, 1975