


Scan # 43278
10-00-002/05-003
1000-001-D

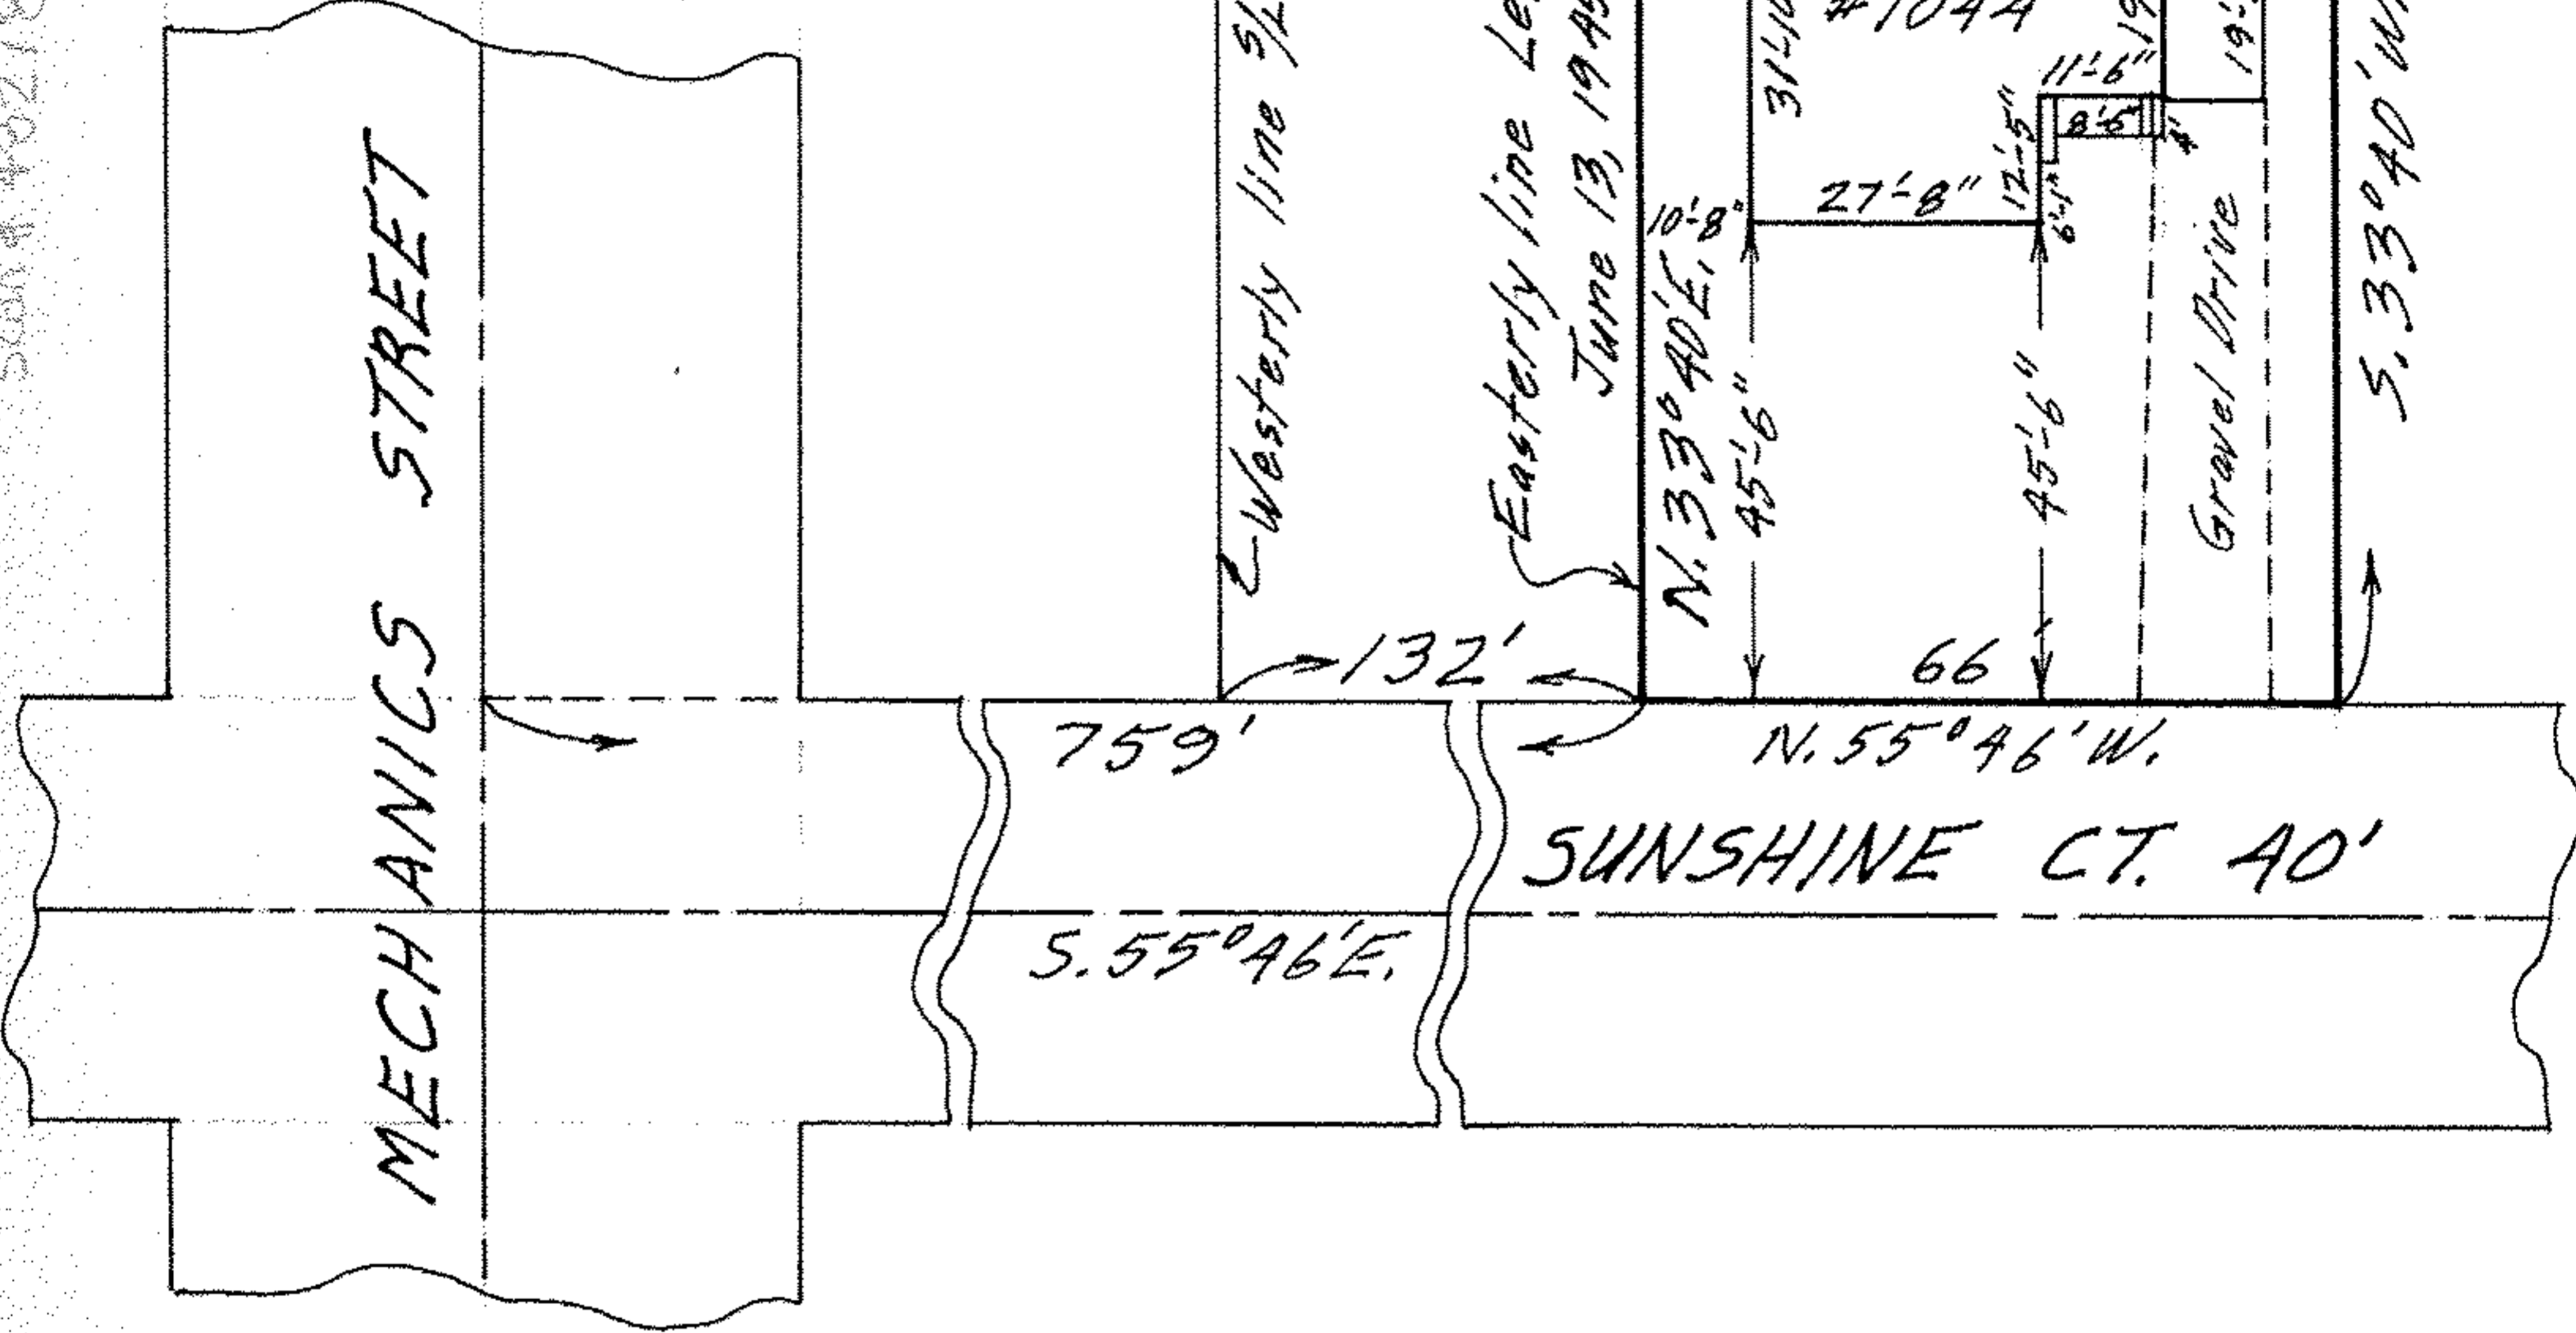

MAP OF PART OF ORIG. LOT NO. 2
GRAFTON TWP. - GRAFTON VILLAGE
LORAIN COUNTY - OHIO
SCALE: 1" = 30' MAY 25-1966 8:00 P.M.
Gary E. Penfound REG. SURVEYOR

BERKS TITLE INS. CO.
Order No. 1690