

16.00.003.105.016

SC091 48284 1600-003-A

Southerly Extension
Westerly Line
WILLOW ST. NORTH

WILLOW STREET 60'

#1161

N. 84°56'40"E.
A=75.29 C=75.21'


R=800'

A=75.01' C=74.98'
S. 89°40'30"E.

A+C=96.77'
S. 85°18'50"E.

I.P.

I.P.

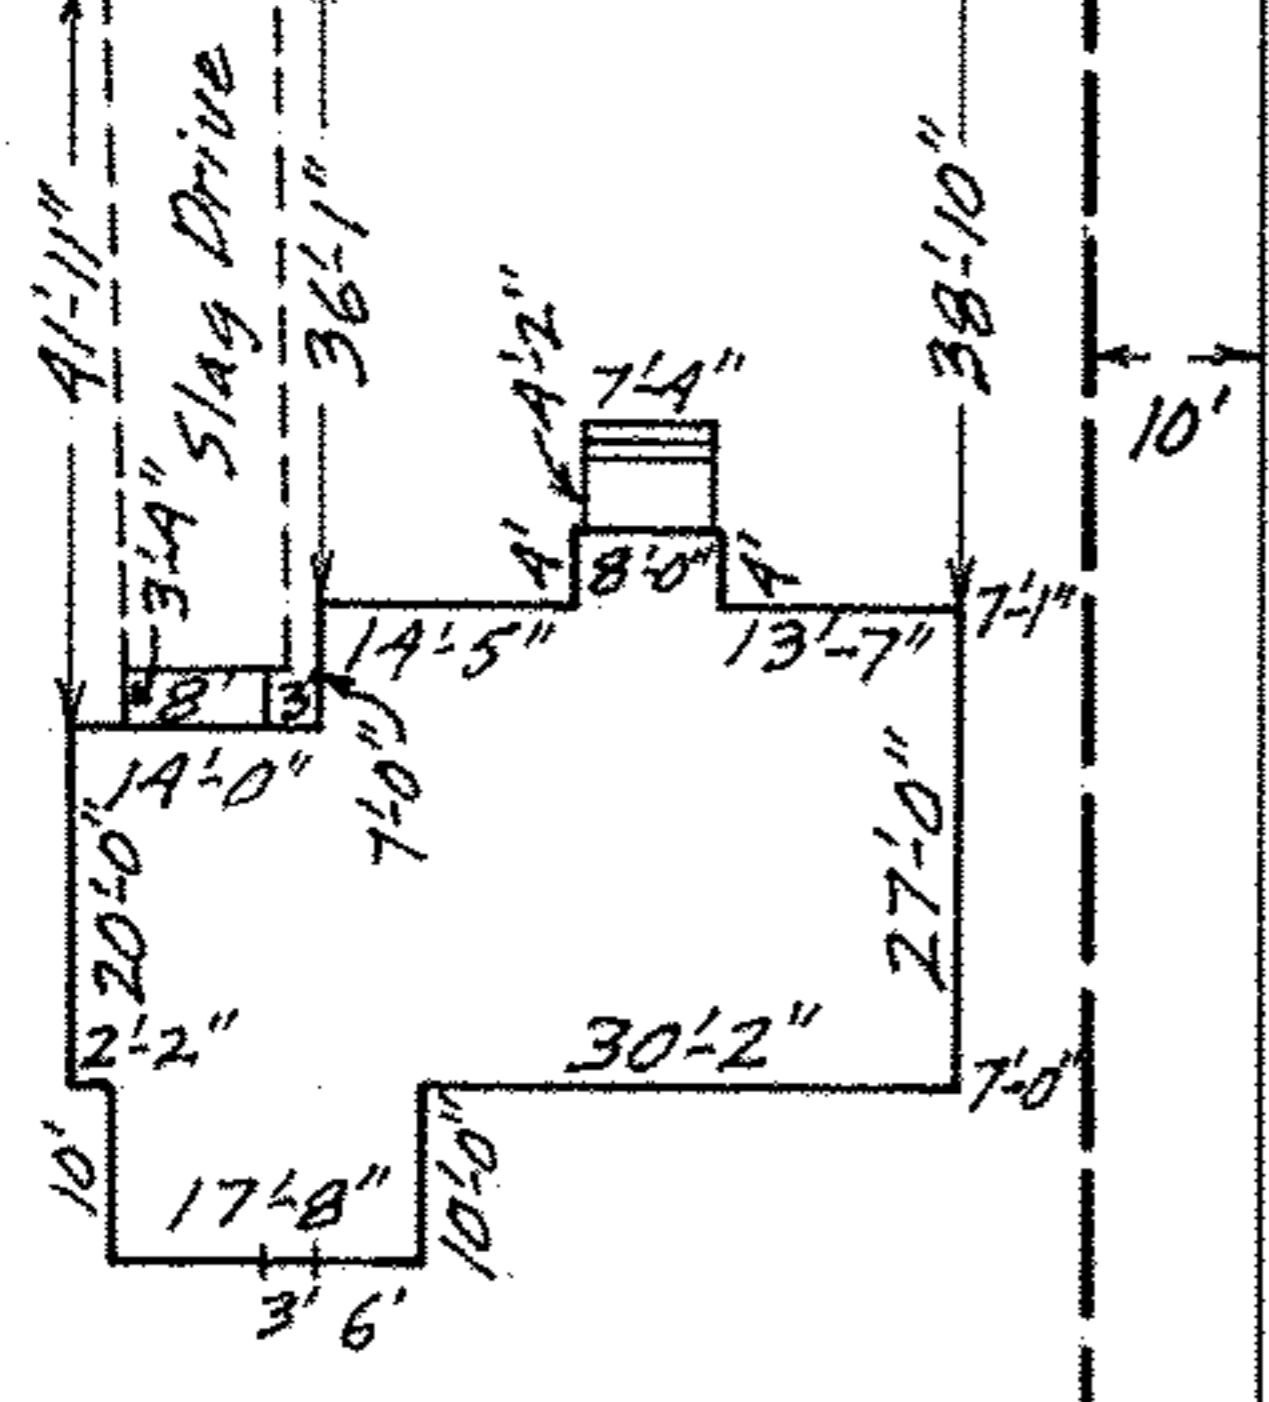

7

N. 0°45'W. 218.68'

8

About 225'

9

S. 0°45'E. 225.63'

65.01'
75.01'
N. 89°45'30"W.
65'

MAP OF WESTERLY 65 FEET OF
SUB-LOT NO. 8 OF MYLES KNECHTGES
SUB'N. NO. 1 VOL. 14 PG. 21 PLATS
O.L. 3 GRAFTON TWP. - GRAFTON VILLAGE
LORAIN COUNTY - OHIO
SCALE: 1"=30' JUNE 19-1966 7:15 P.M.

Guy E. Penfound REG. SURVEYOR

BERKS TITLE INS. CO. Order No. 1663