


Scan# 48290 16-00-027-DW-007, 006, 003

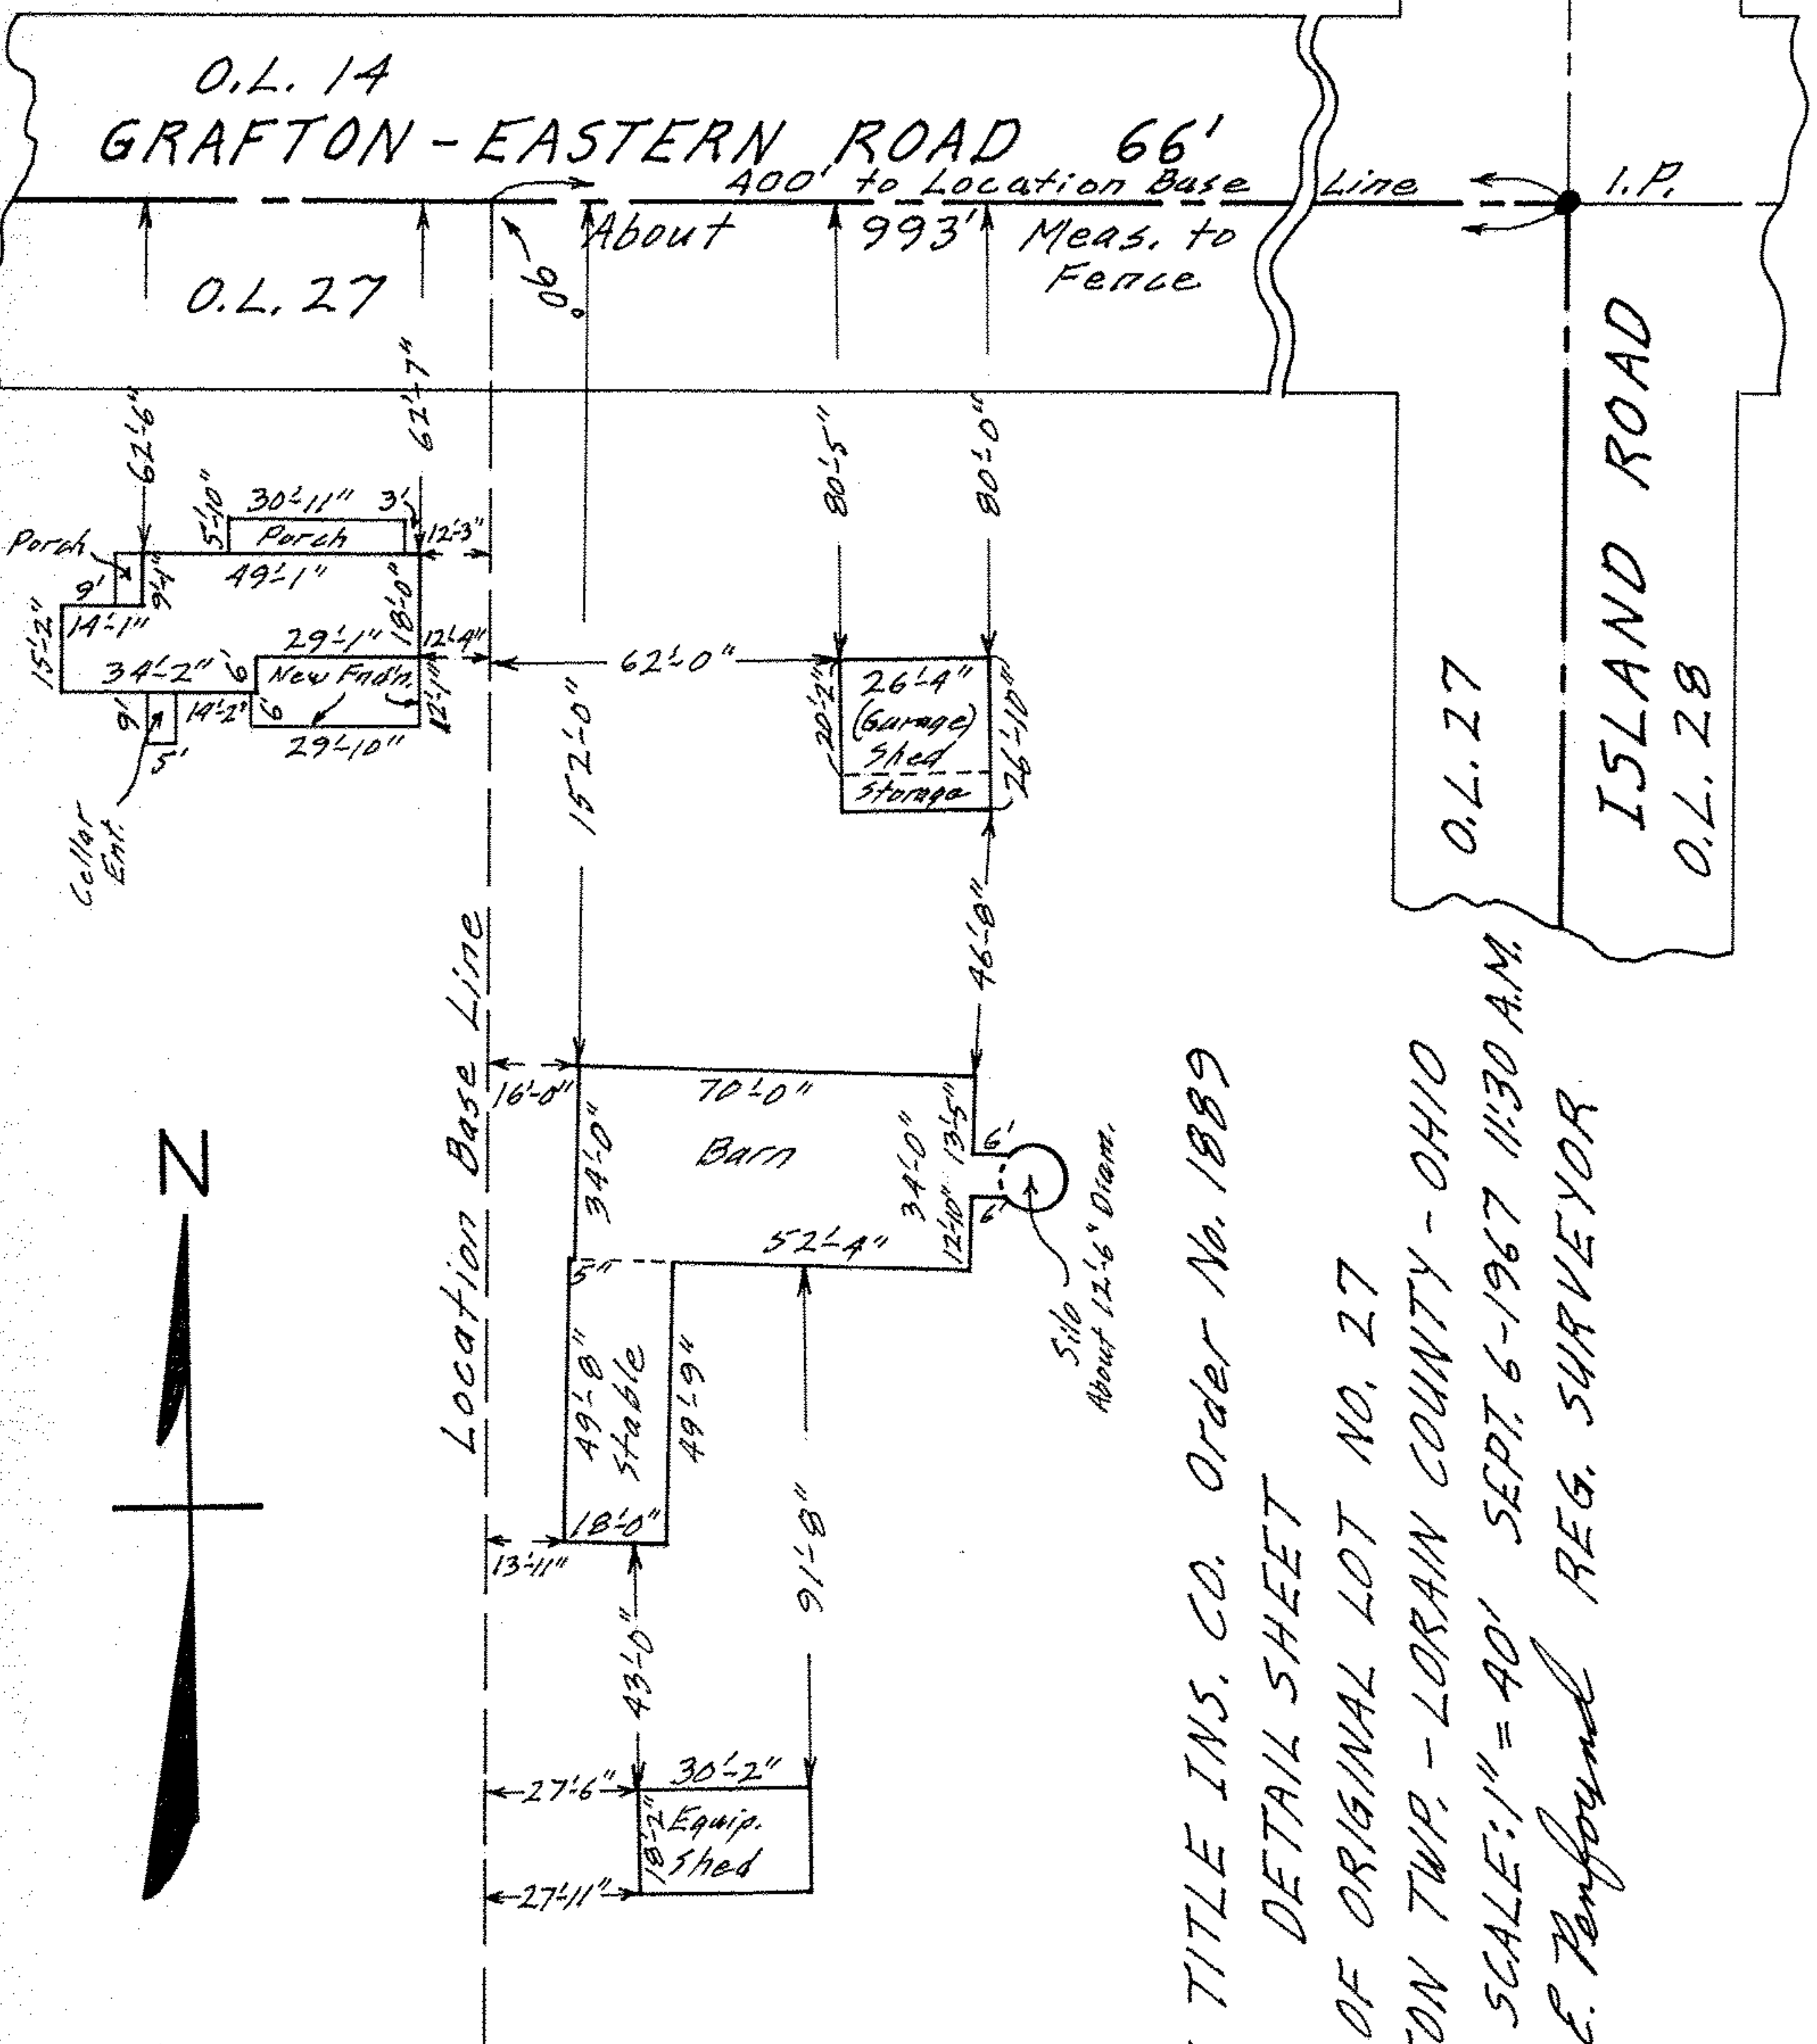

BERKS TITLE INS. CO. Order No. 1889
 DETAIL SHEET
 PART OF ORIGINAL LOT NO. 27
 GRAFTON TWP. - LORAIN COUNTY - OHIO
 DETAIL SCALE: 1" = 40' SEPT. 6-1967 11:30 A.M.
 Gary E. Penfound REG. SURVEYOR