


DIMENSIONS SHOWN ON THIS PLAT ARE EXPRESSED IN FEET AND DECIMAL PARTS THEREOF. ALL BEARINGS ARE TO AN ASSUMED MERIDIAN AND ARE USED TO INDICATE ANGLES ONLY. PERMANENT MONUMENTS WERE FOUND OR SET AT ALL POINTS INDICATED HEREON, ALL OF WHICH I CERTIFY TO BE CORRECT.

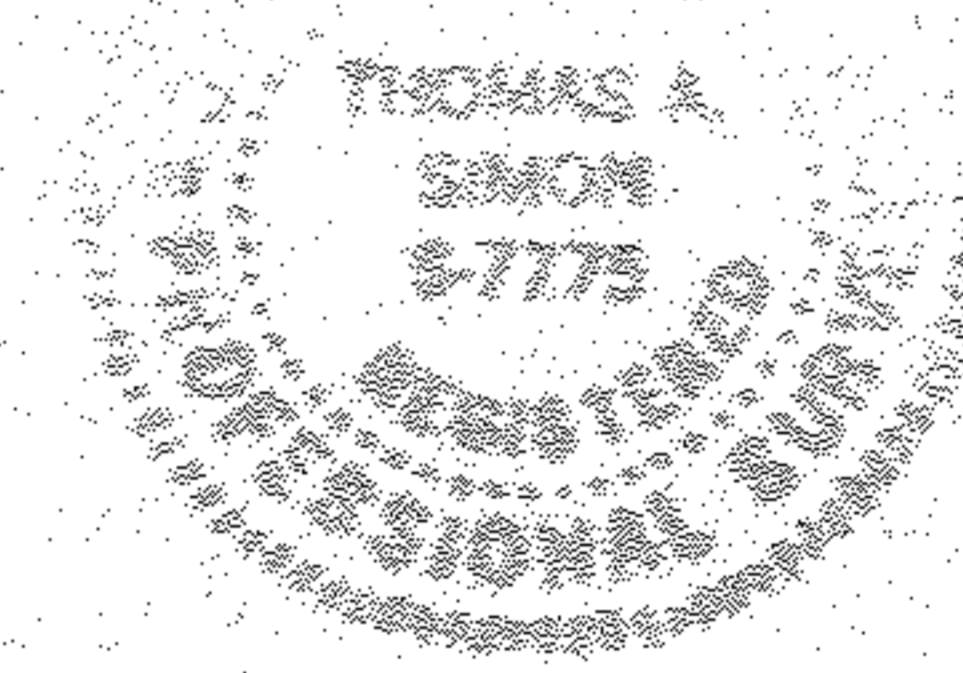

*Thomas A. Simon*  
 THOMAS A. SIMON  
 REG. PROFESSIONAL SURVEYOR  
 NO. S-7775

BASIS OF BEARINGS IS THE CENTERLINE OF BETTS ROAD (NORTH 89°57'20" EAST). IRON PINS SET ARE 5/8" DIAMETER, 30" LONG WITH PLASTIC CAPS "T. SIMON, S-7775".

APPROVED  
 LORAIN CO.  
 MAP DEPT.  
 DATE 5-20-14  
 PAGE 13-F  
 BY R. MAINES  
 #14-02945-A

13-09-022-000-004  
 Scan # 48344

PLAT OF SURVEY & SPLIT  
 FOR  
 LORNA PLOTT

BEING KNOWN AS PARTS OF ORIGINAL CAMDEN TOWNSHIP  
 LOT NOS. 22 AND 33, TRACT 9  
 COUNTY OF LORAIN STATE OF OHIO  
 APRIL, 2014 SCALE: 1" = 300'

1. PIN FD. & USED  
 30.00' C/L

BAIRD ROAD

O.L. 21  
 TR. 9  
 O.L. 34  
 TR. 9

O.L. 22  
 TR. 9  
 O.L. 33  
 TR. 9

CENTER OF  
 8" x 8" CONC  
 FENCE POST  
 (BROKEN)  
 FD. & USED

13-09-033-000-011  
 D. & R. SEARLES  
 DOC. #20110366570  
 3/8/11

13-09-033-000-008  
 W.M. SEARLES LIVING TRUST  
 DOC. #19860382534  
 3/25/96

13-09-033-000-011  
 RUSSELL & DORTHY SEARLES  
 DOC. #20110366570  
 3/8/11

BETTS ROAD

O.L. 34  
 TR. 9  
 O.L. 39  
 TR. 9

O.L. 33  
 TR. 9  
 O.L. 40  
 TR. 9

O.L. 33  
 TR. 9

O.L. 32  
 TR. 9

THOMAS SIMON & ASSOCIATES, INC.  
 PROFESSIONAL LAND SURVEYORS  
 150 SOUTH OLIVE STREET  
 ELYRIA, OHIO 44035  
 (440) 327-2925  
 FAX 327-2964

