


17-E

# 15200 SCAN # 48375 17-20-016-000-026


Parent 025

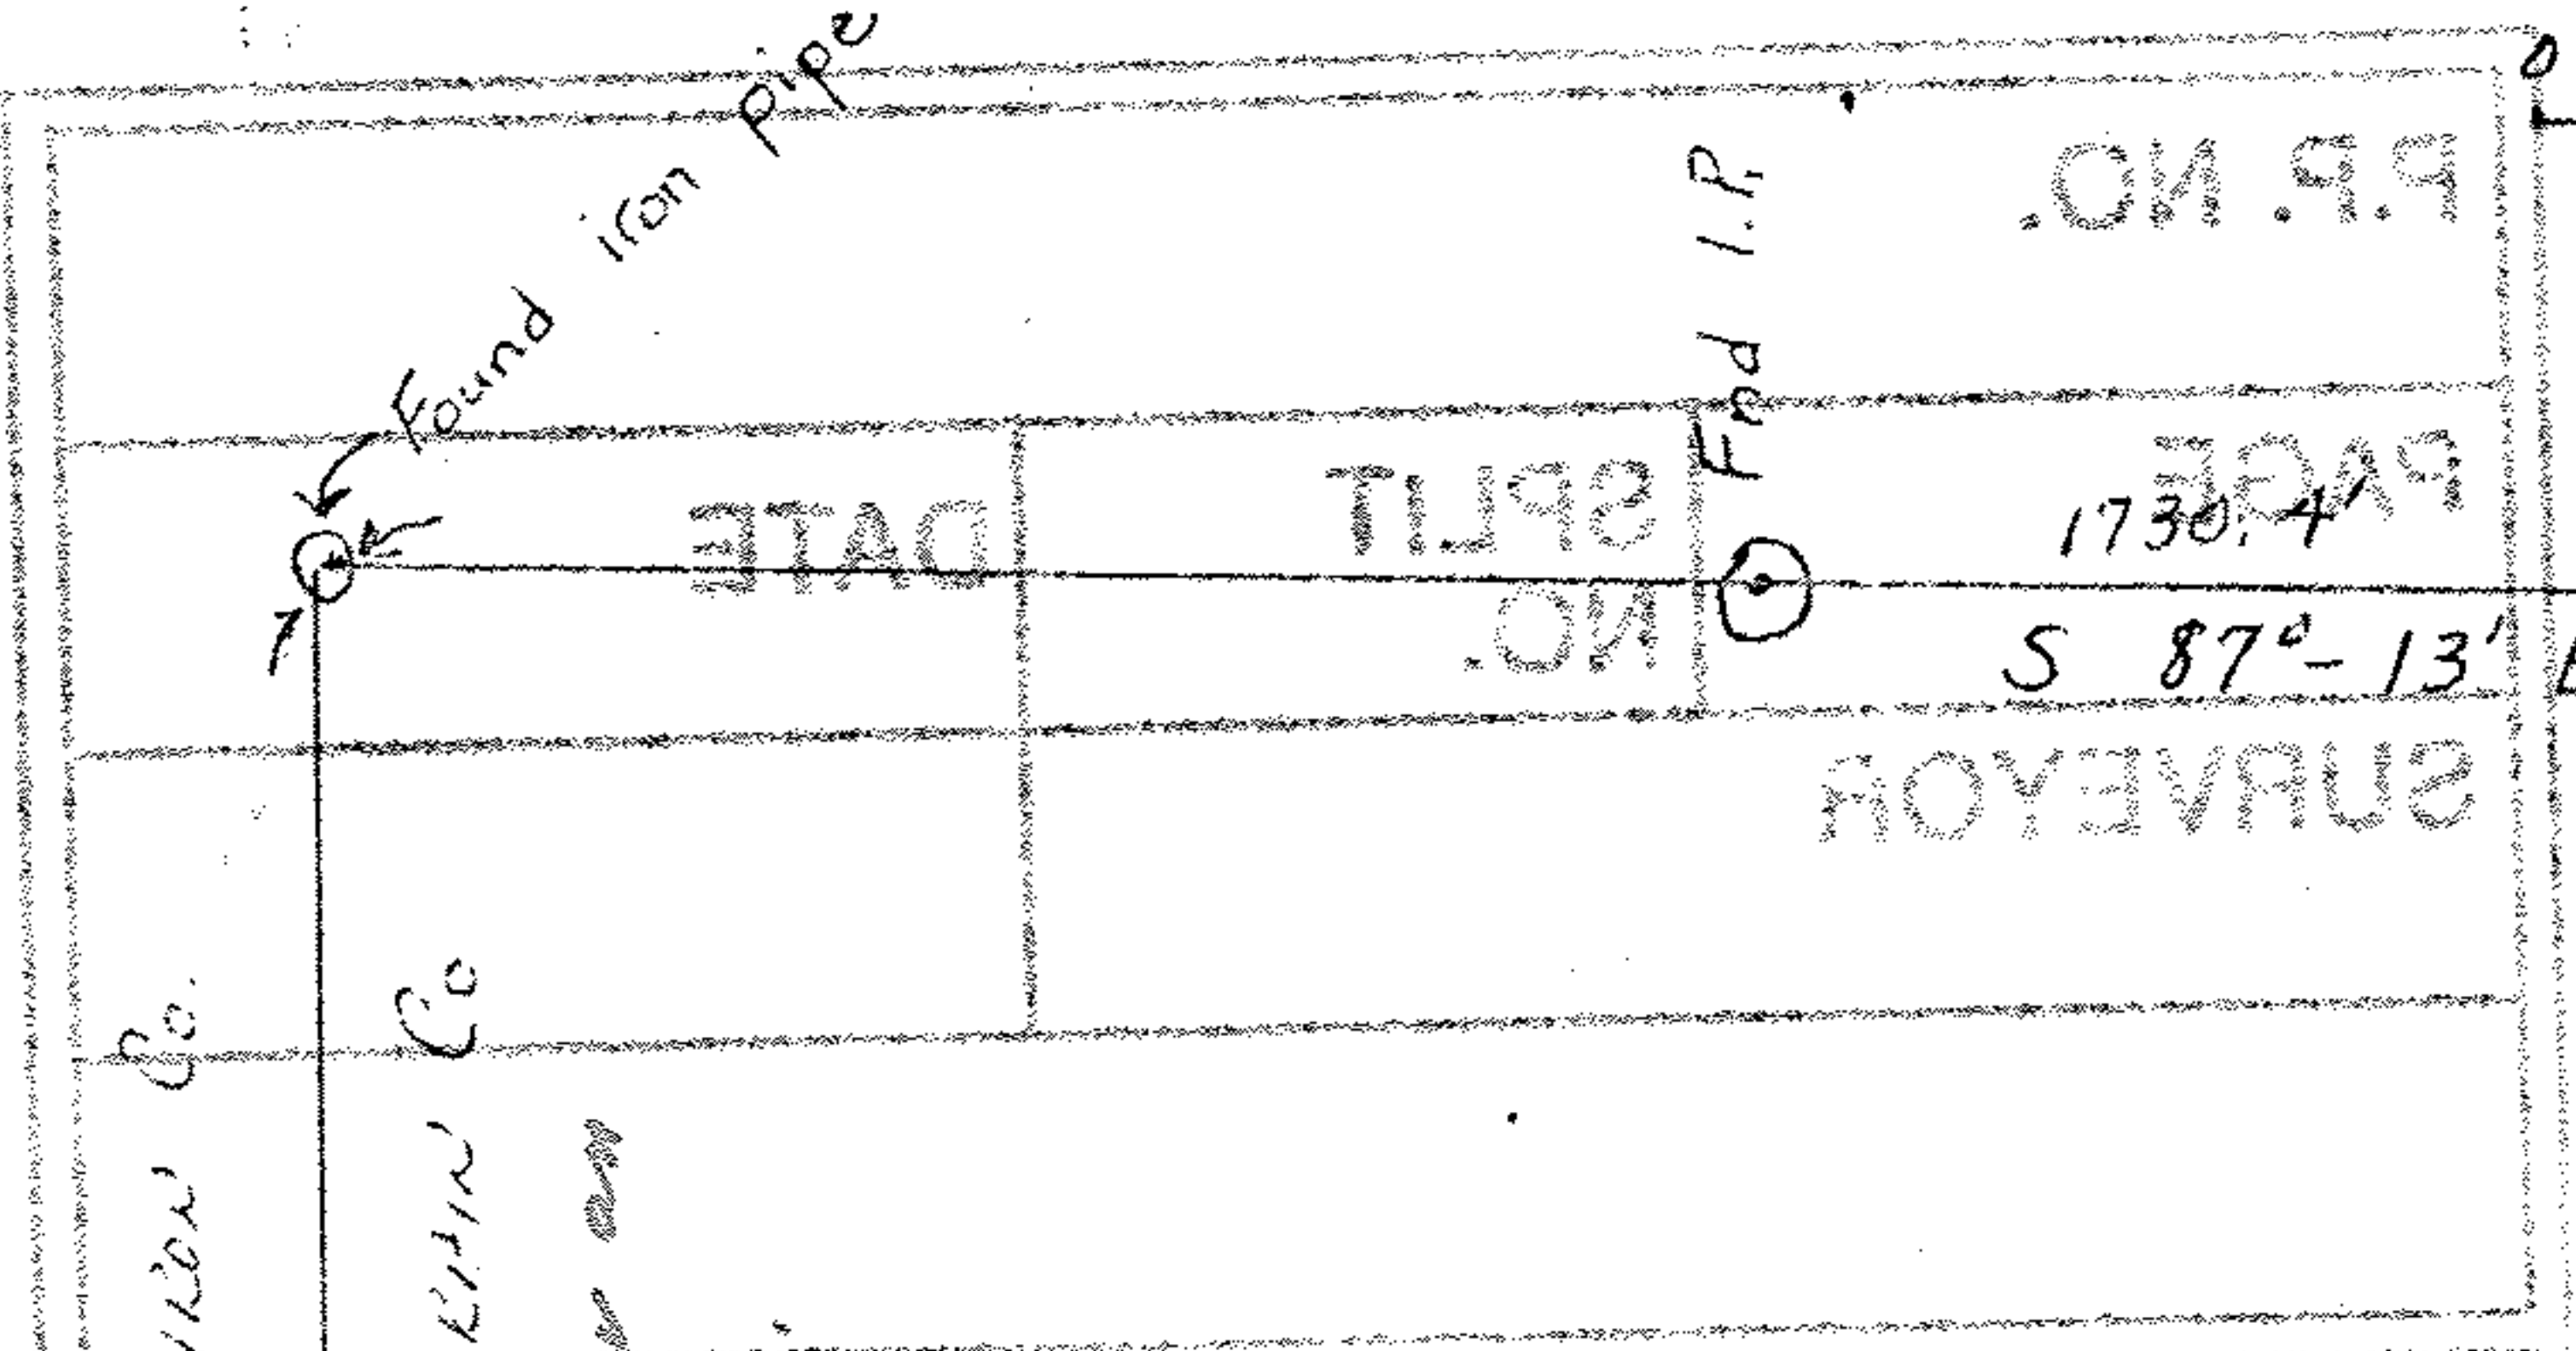

36.42± Acres

# 15200

APPROVED
LORAIN CO.
MAP DEPT.
DATE 8-10-83
PAGE 17-E
BY <i>[Signature]</i>
VOID AFTER 15200

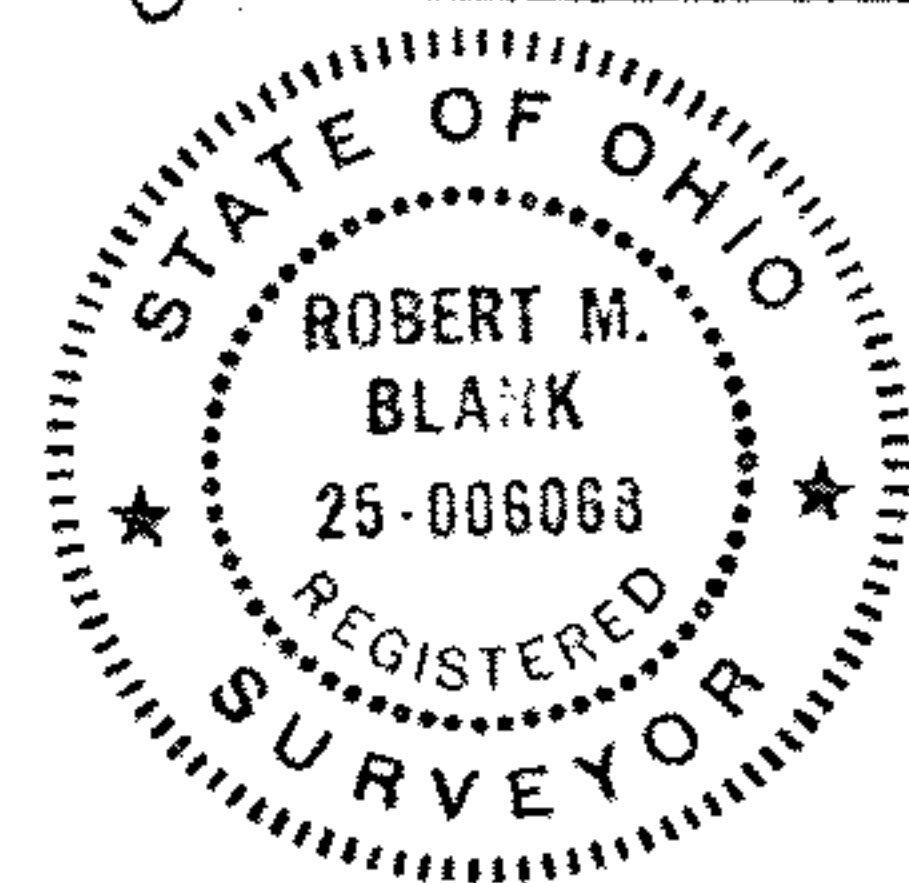

*Robert M. Blank*

Set I.P. 910.1' N 10-31'E

Corr. Per Survey on Dred. Flo.

300'

Set I.P.

400'

Set I.P.

N 87°-13' W 500' 1754.7'

Set I.P.

470'

Set I.P.

Set RR Spike

911' N.S.

GORE - GRHAMMAGE RD

30' Fnd I.P.

Fnd I.P. 2024.8'