




LAUNDON . SIMON . CAHL & ASSOC. INC.
 CONSULTING ENGINEERS & SURVEYORS
 219 COURT ST. ELYRIA, OHIO 44035

SURVEY FOR:

LEONARD TRIPP

Orig. Lot 17	City of	Date JUNE '86 Scale 1"=100'
Orig. Sec	Village of	Dwn. by R.G.S. Chkd. by C.J.
Tract GORE STRIP	County of LORAIN	Job No. 86-1489 F.B. —
Township of BRIGHTON	State of OHIO	Printed

17.80-017.500-016-038, 041
 17-E

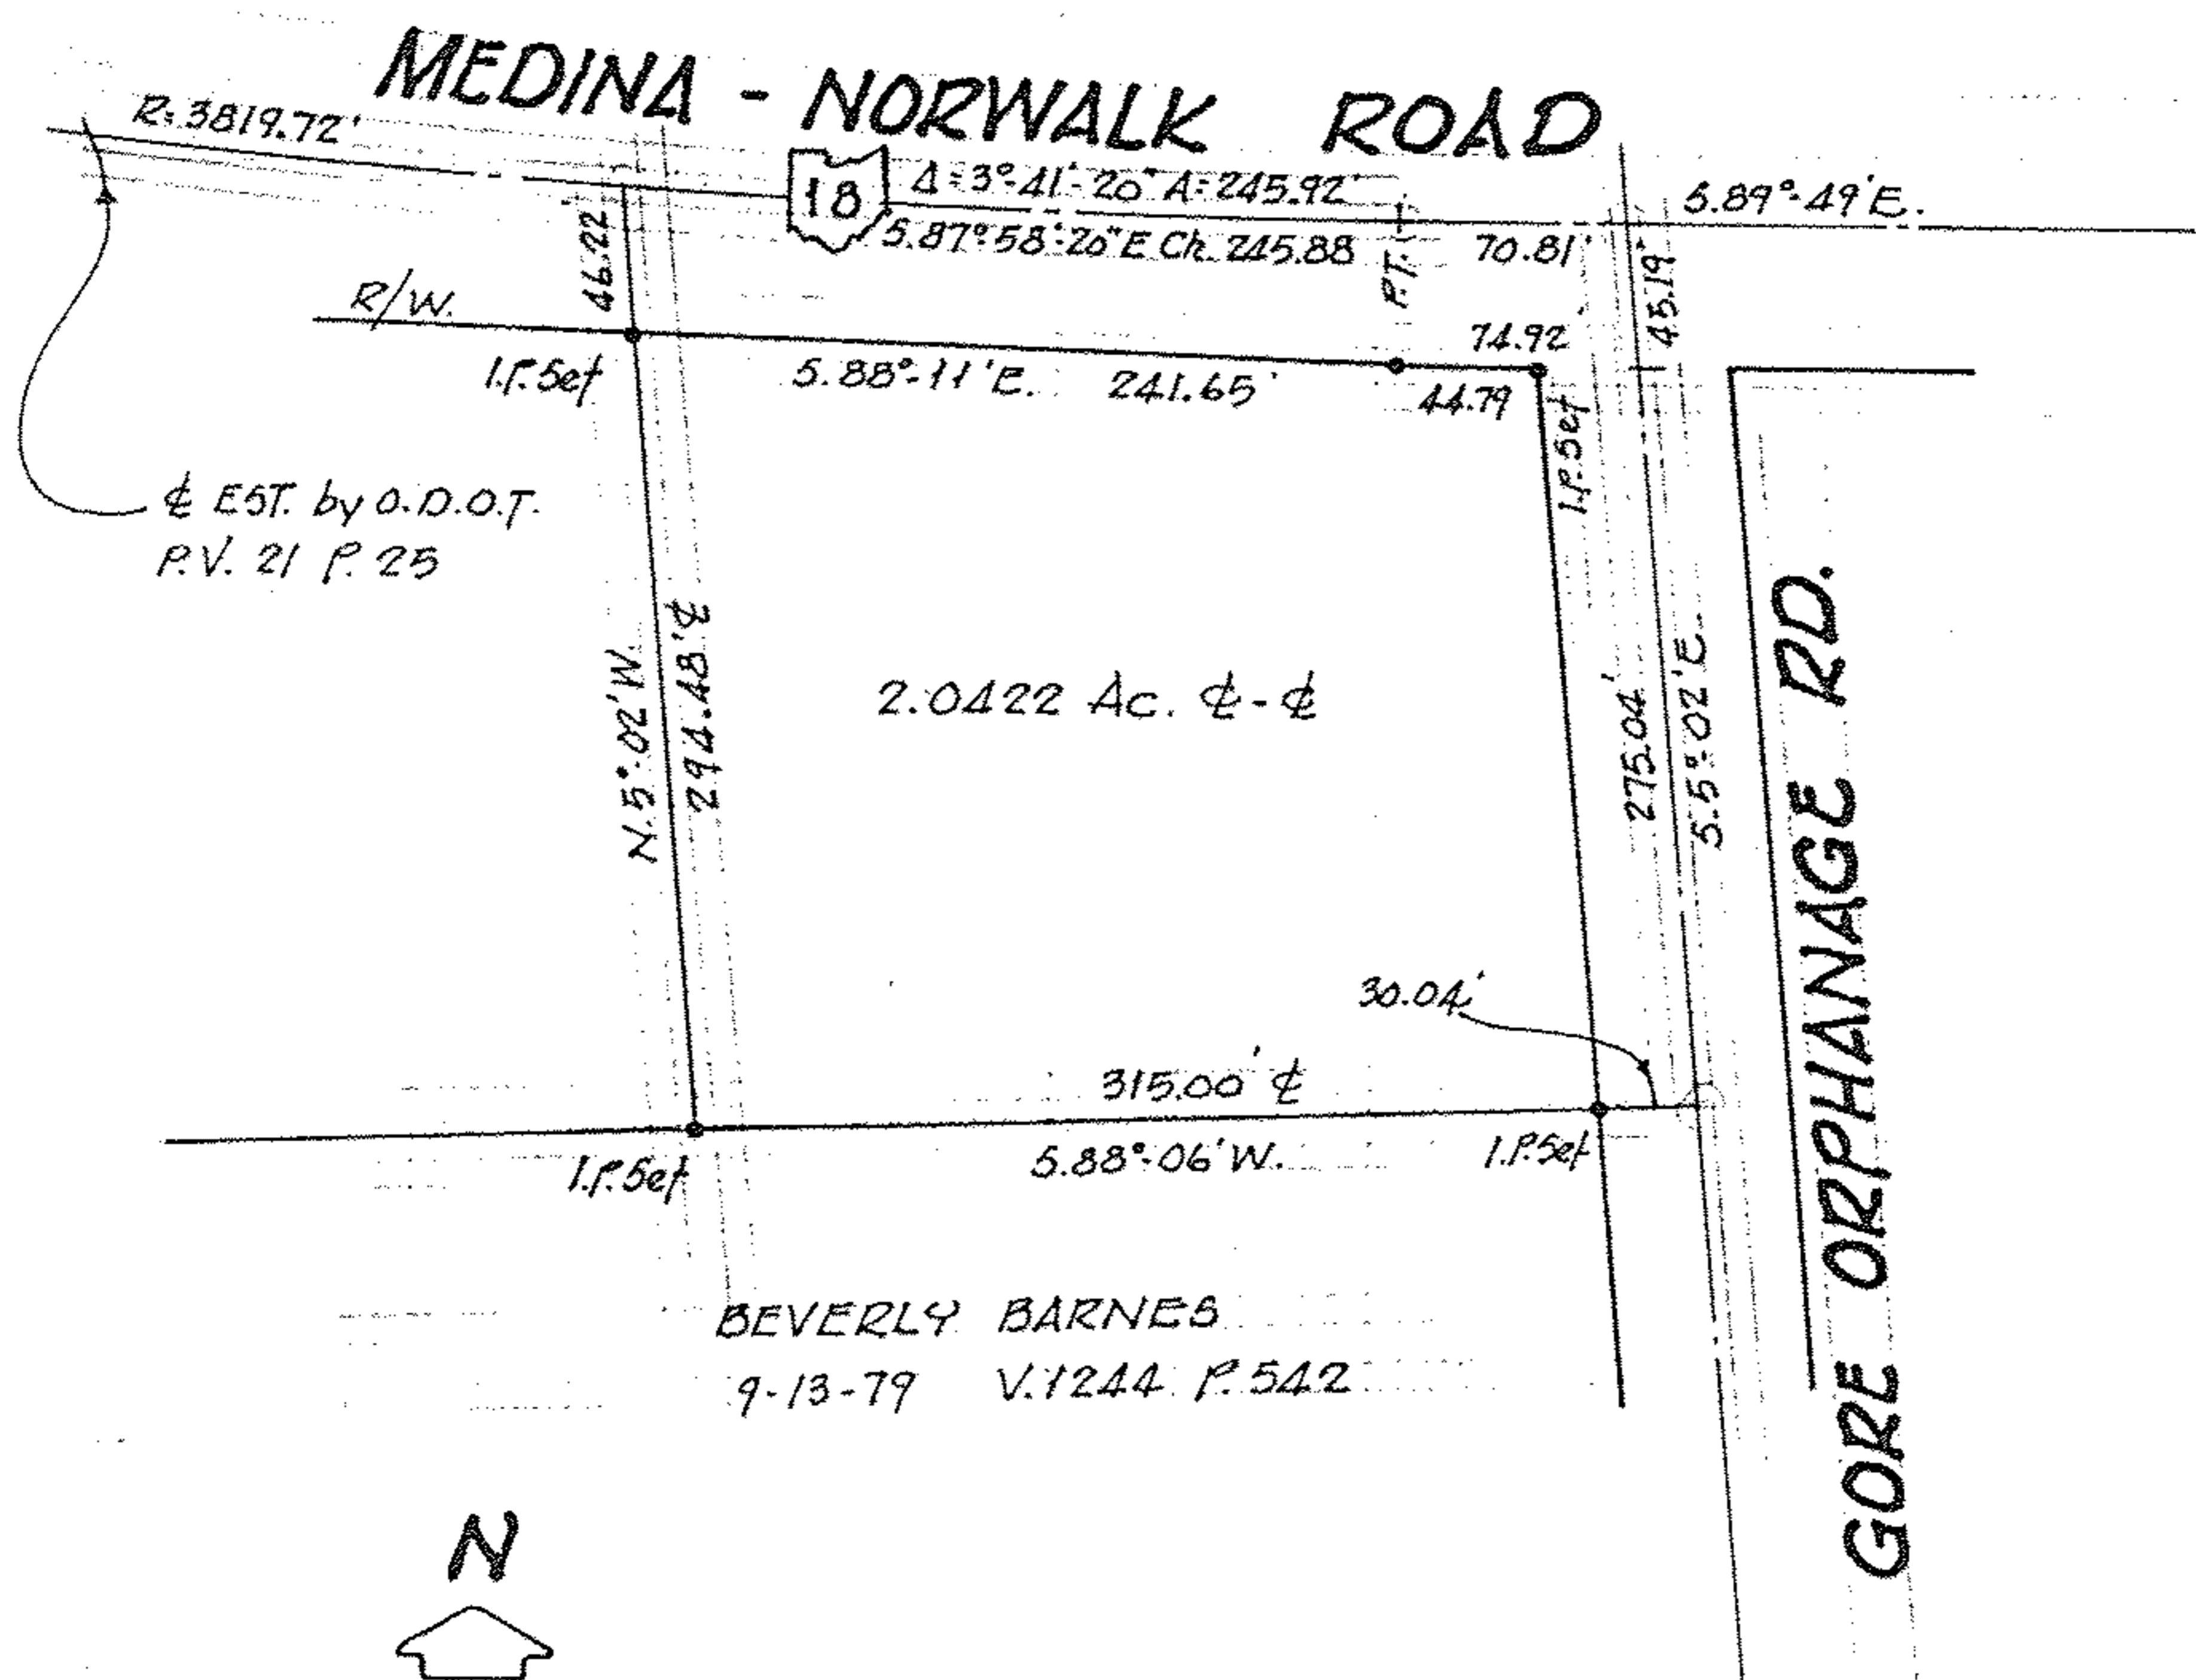

GORE ORPHANAGE RD.