



18-00-001-000

PLAT OF SURVEY FOR HAROLD WILES
PART OF ORIGINAL LOT NO. 1, WELLINGTON TWP.
LORAIN COUNTY STATE OF OHIO

18247
12/7/88
18-H
T. M. Main

18-H

18247

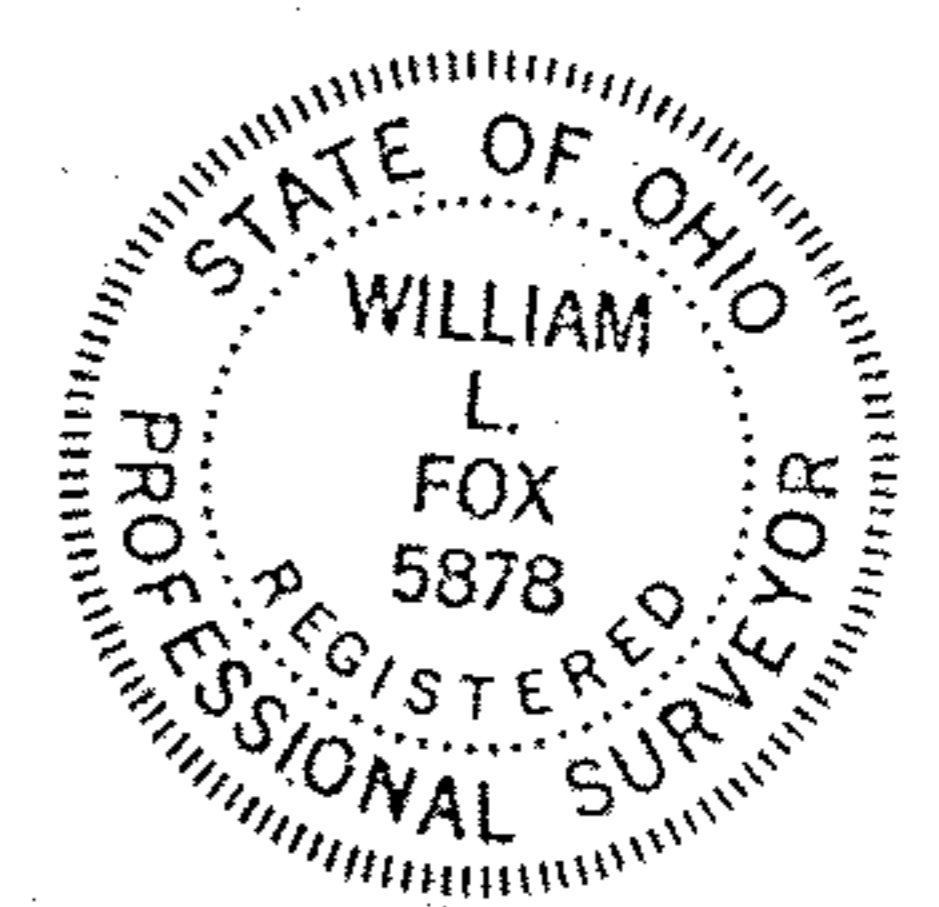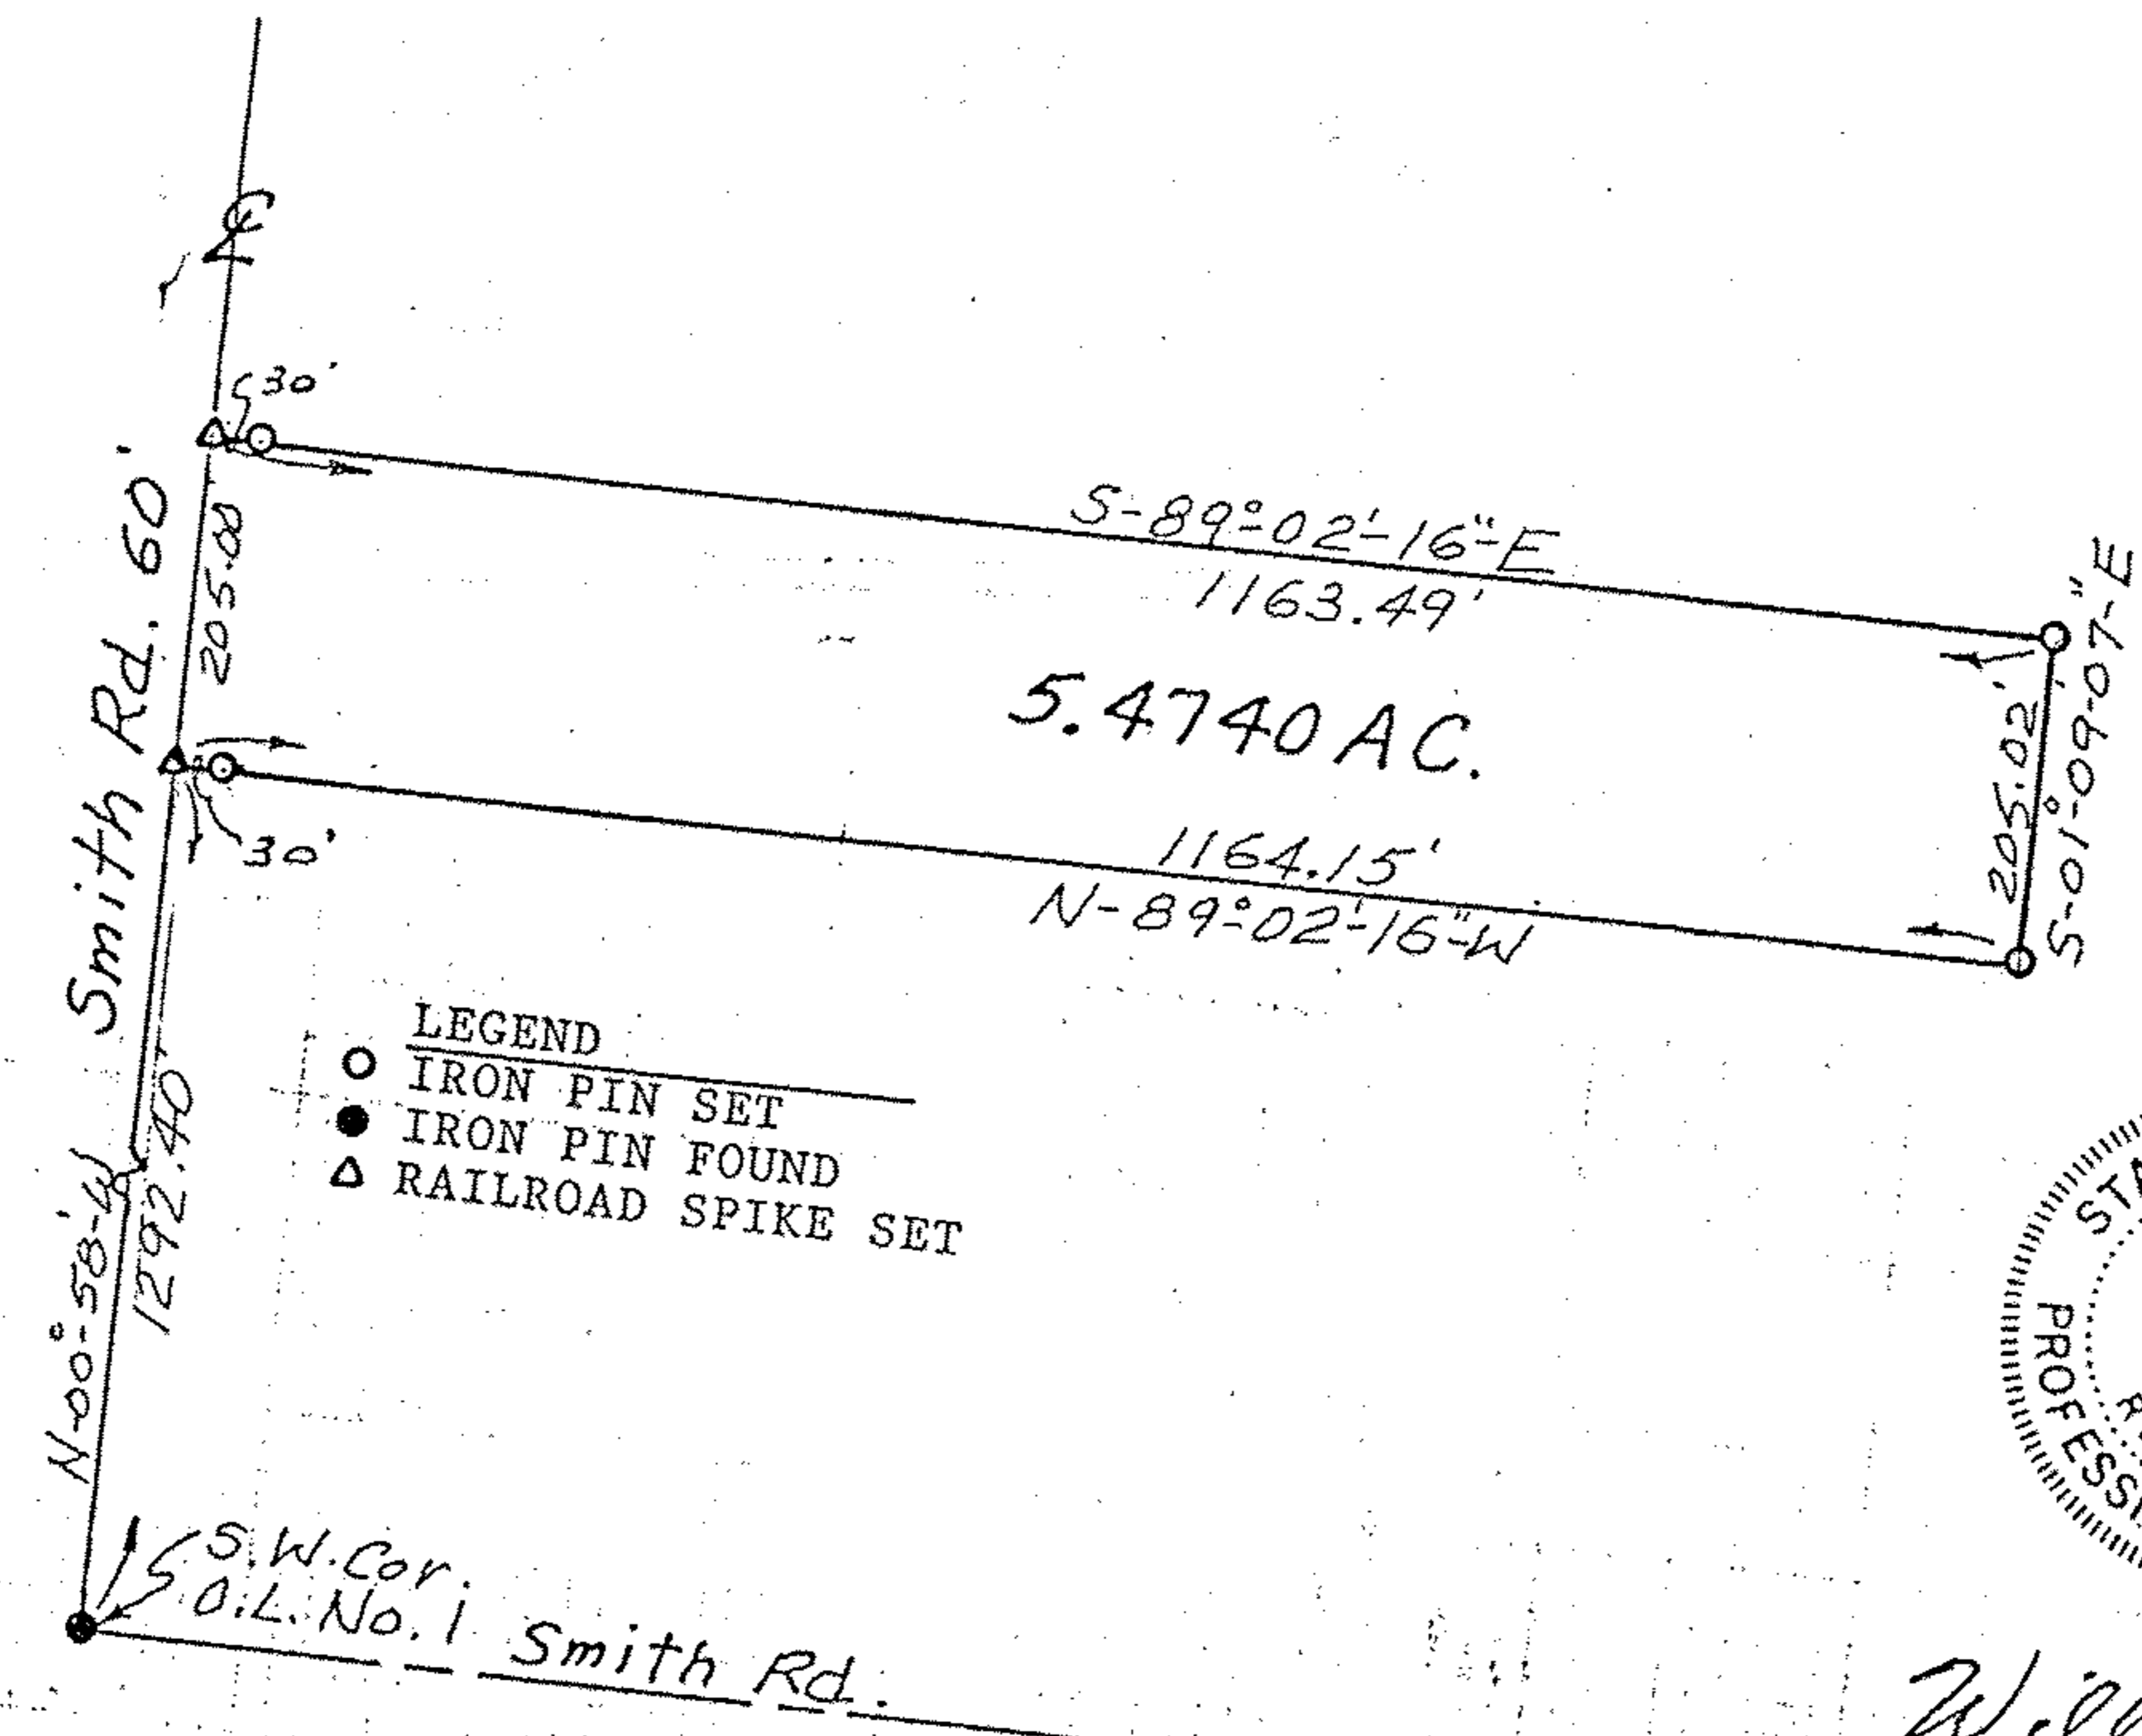

William L. Fox
William L. Fox, P.S.
Registered Surveyor No. 5878

FOX SURVEYING
34 S. Broad St.
Cincinnati, Ohio 44805

Scan # 27753 18-00-001-000-018, 019