


18-00-028-109-025, 026
 Scan # 40393

Brian L & Virginia Meyers
 OR 1224 Pg 182

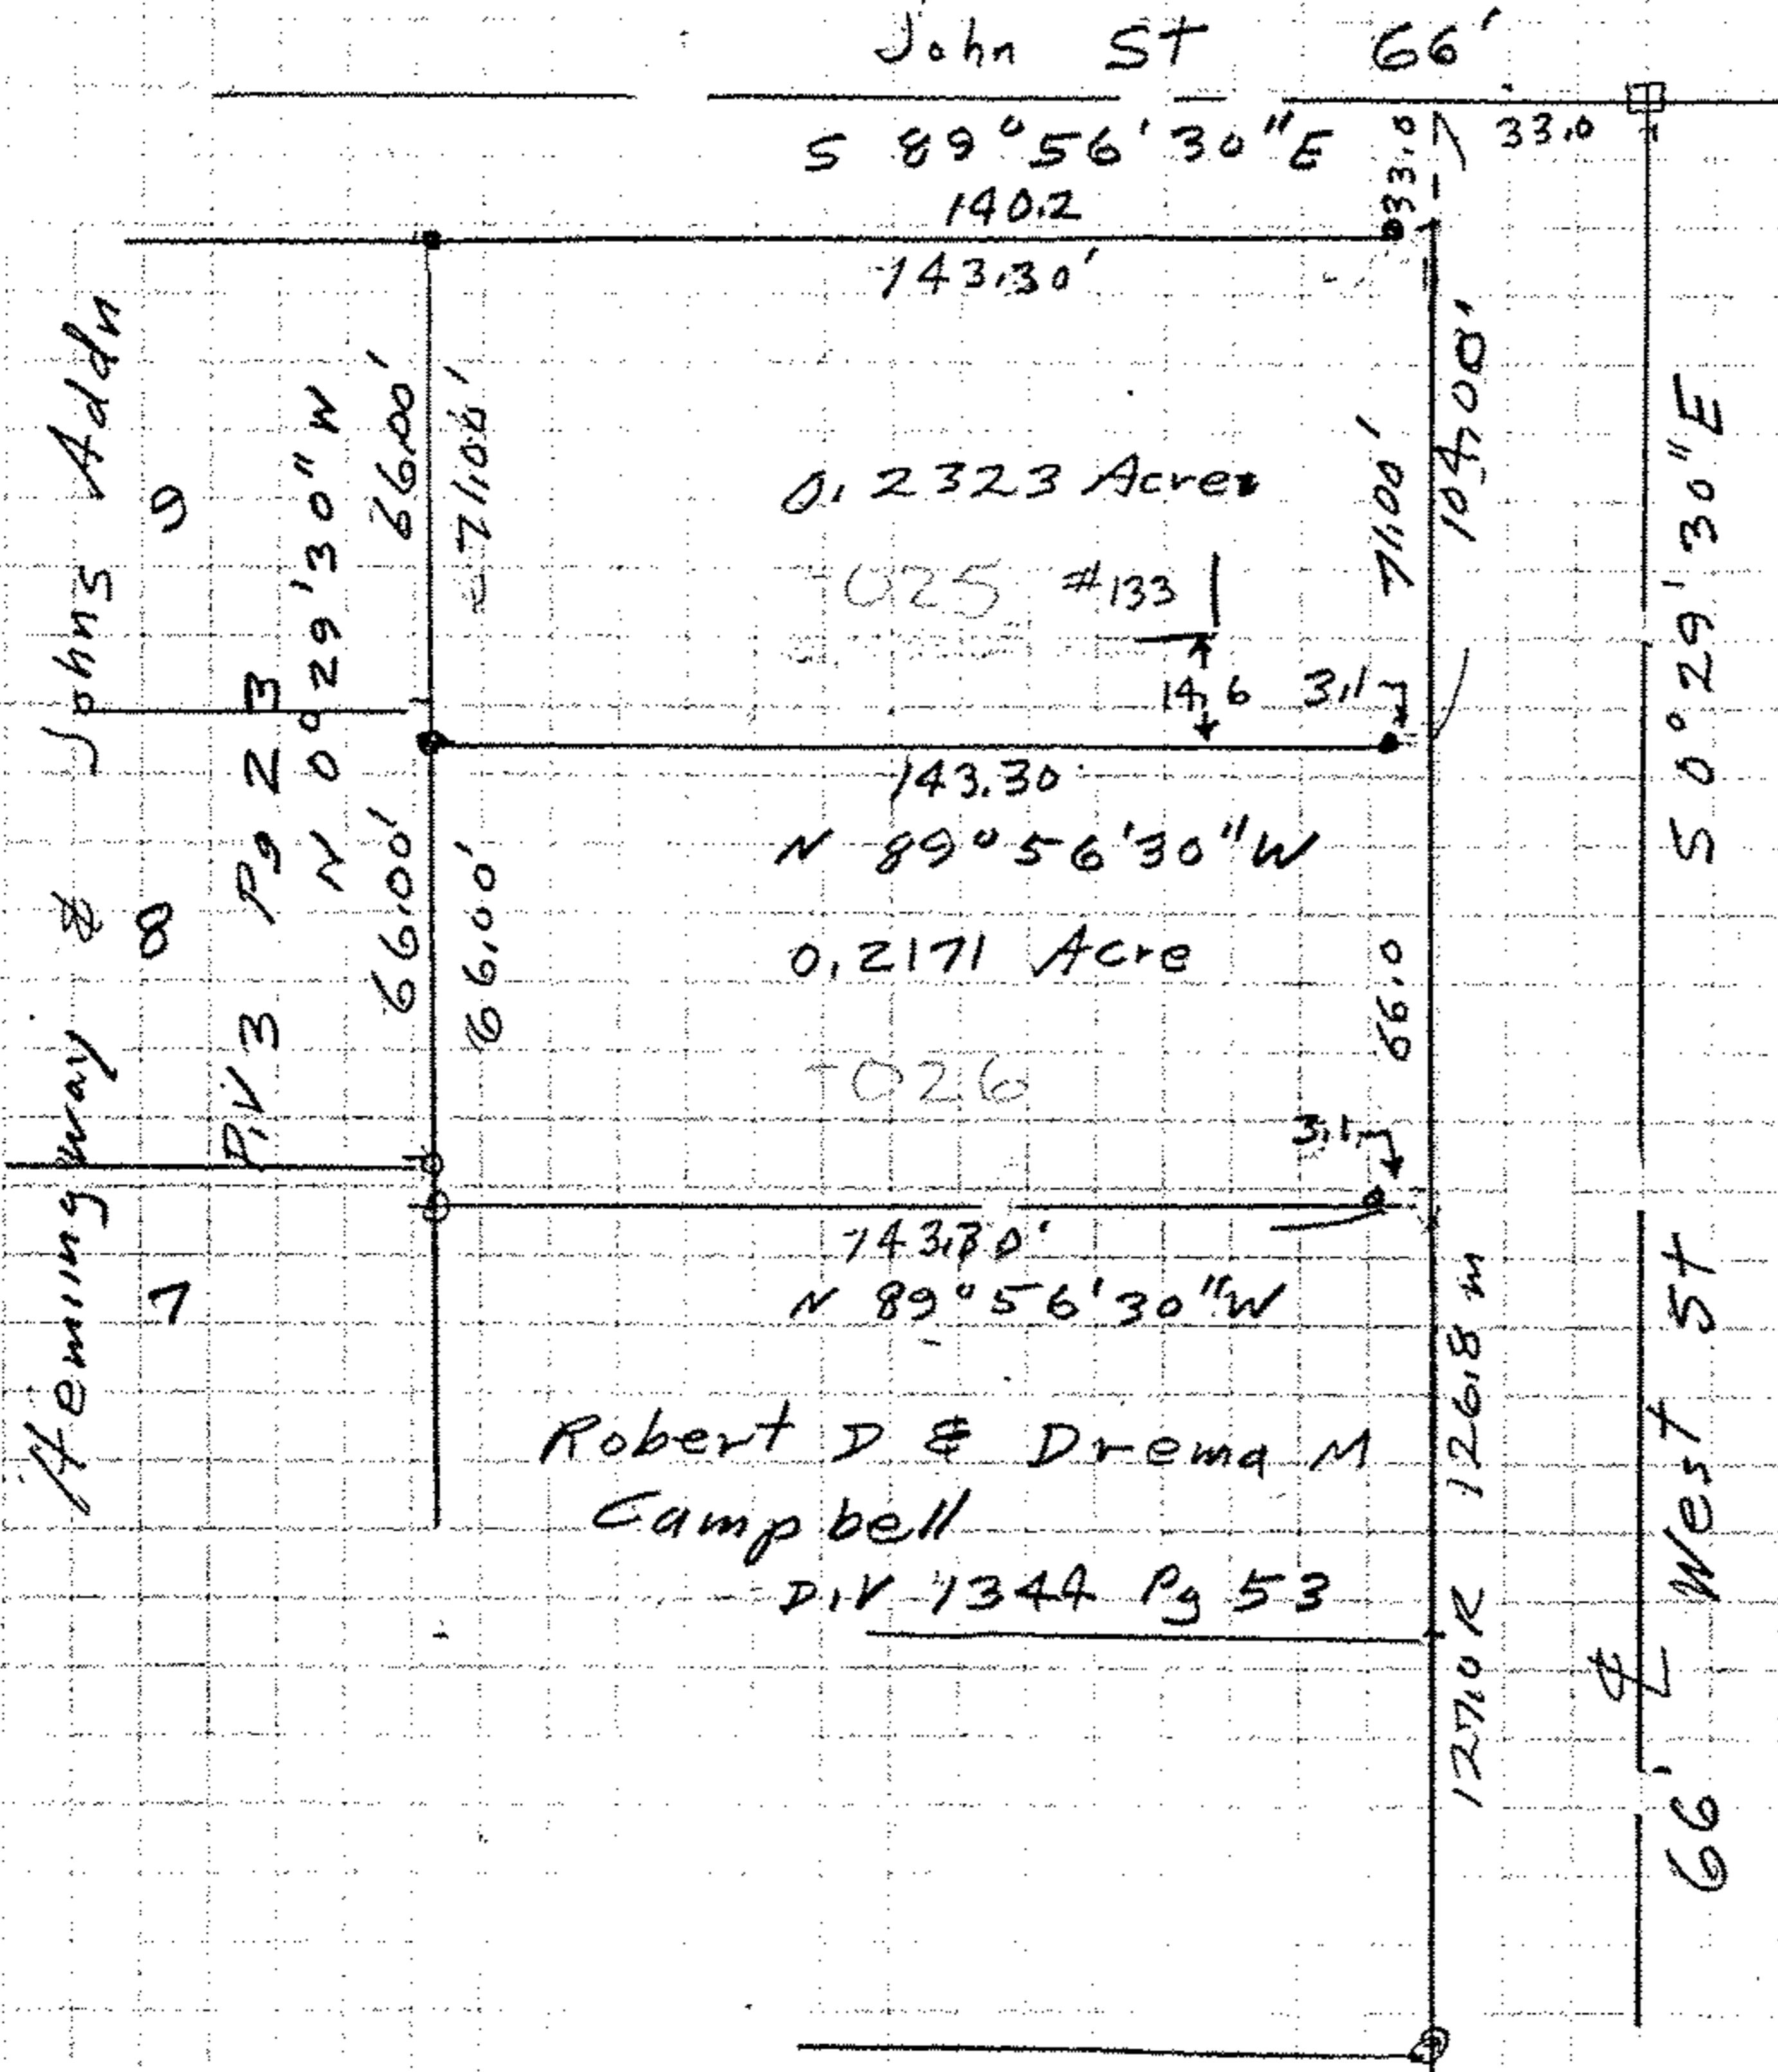

Robert D & Drema M
 Campbell
 DIV 1344 Pg 53

#00098
 APPROVED
 LORAIN CO.
 MAP DEPT.
 DATE 6-1-99
 PAGE 18-00-028-C
 BY T. J. Jilk
 00098

□ Monument box
 ○ Iron pipe
 ● Iron pipe

John J. Jilk
 REGISTERED SURVEYOR
 5292
 STATE OF OHIO

Survey for Brian Meyers
 BIK 2 D.J. Johns Addition
 R Vol 1 Pg 36
 Original Wellington Twp Lot 28
 Village of Wellington
 Lorain County Ohio
 scale 1"=50' NOV 1998