



P.P. NO. 99
 PAGE 2

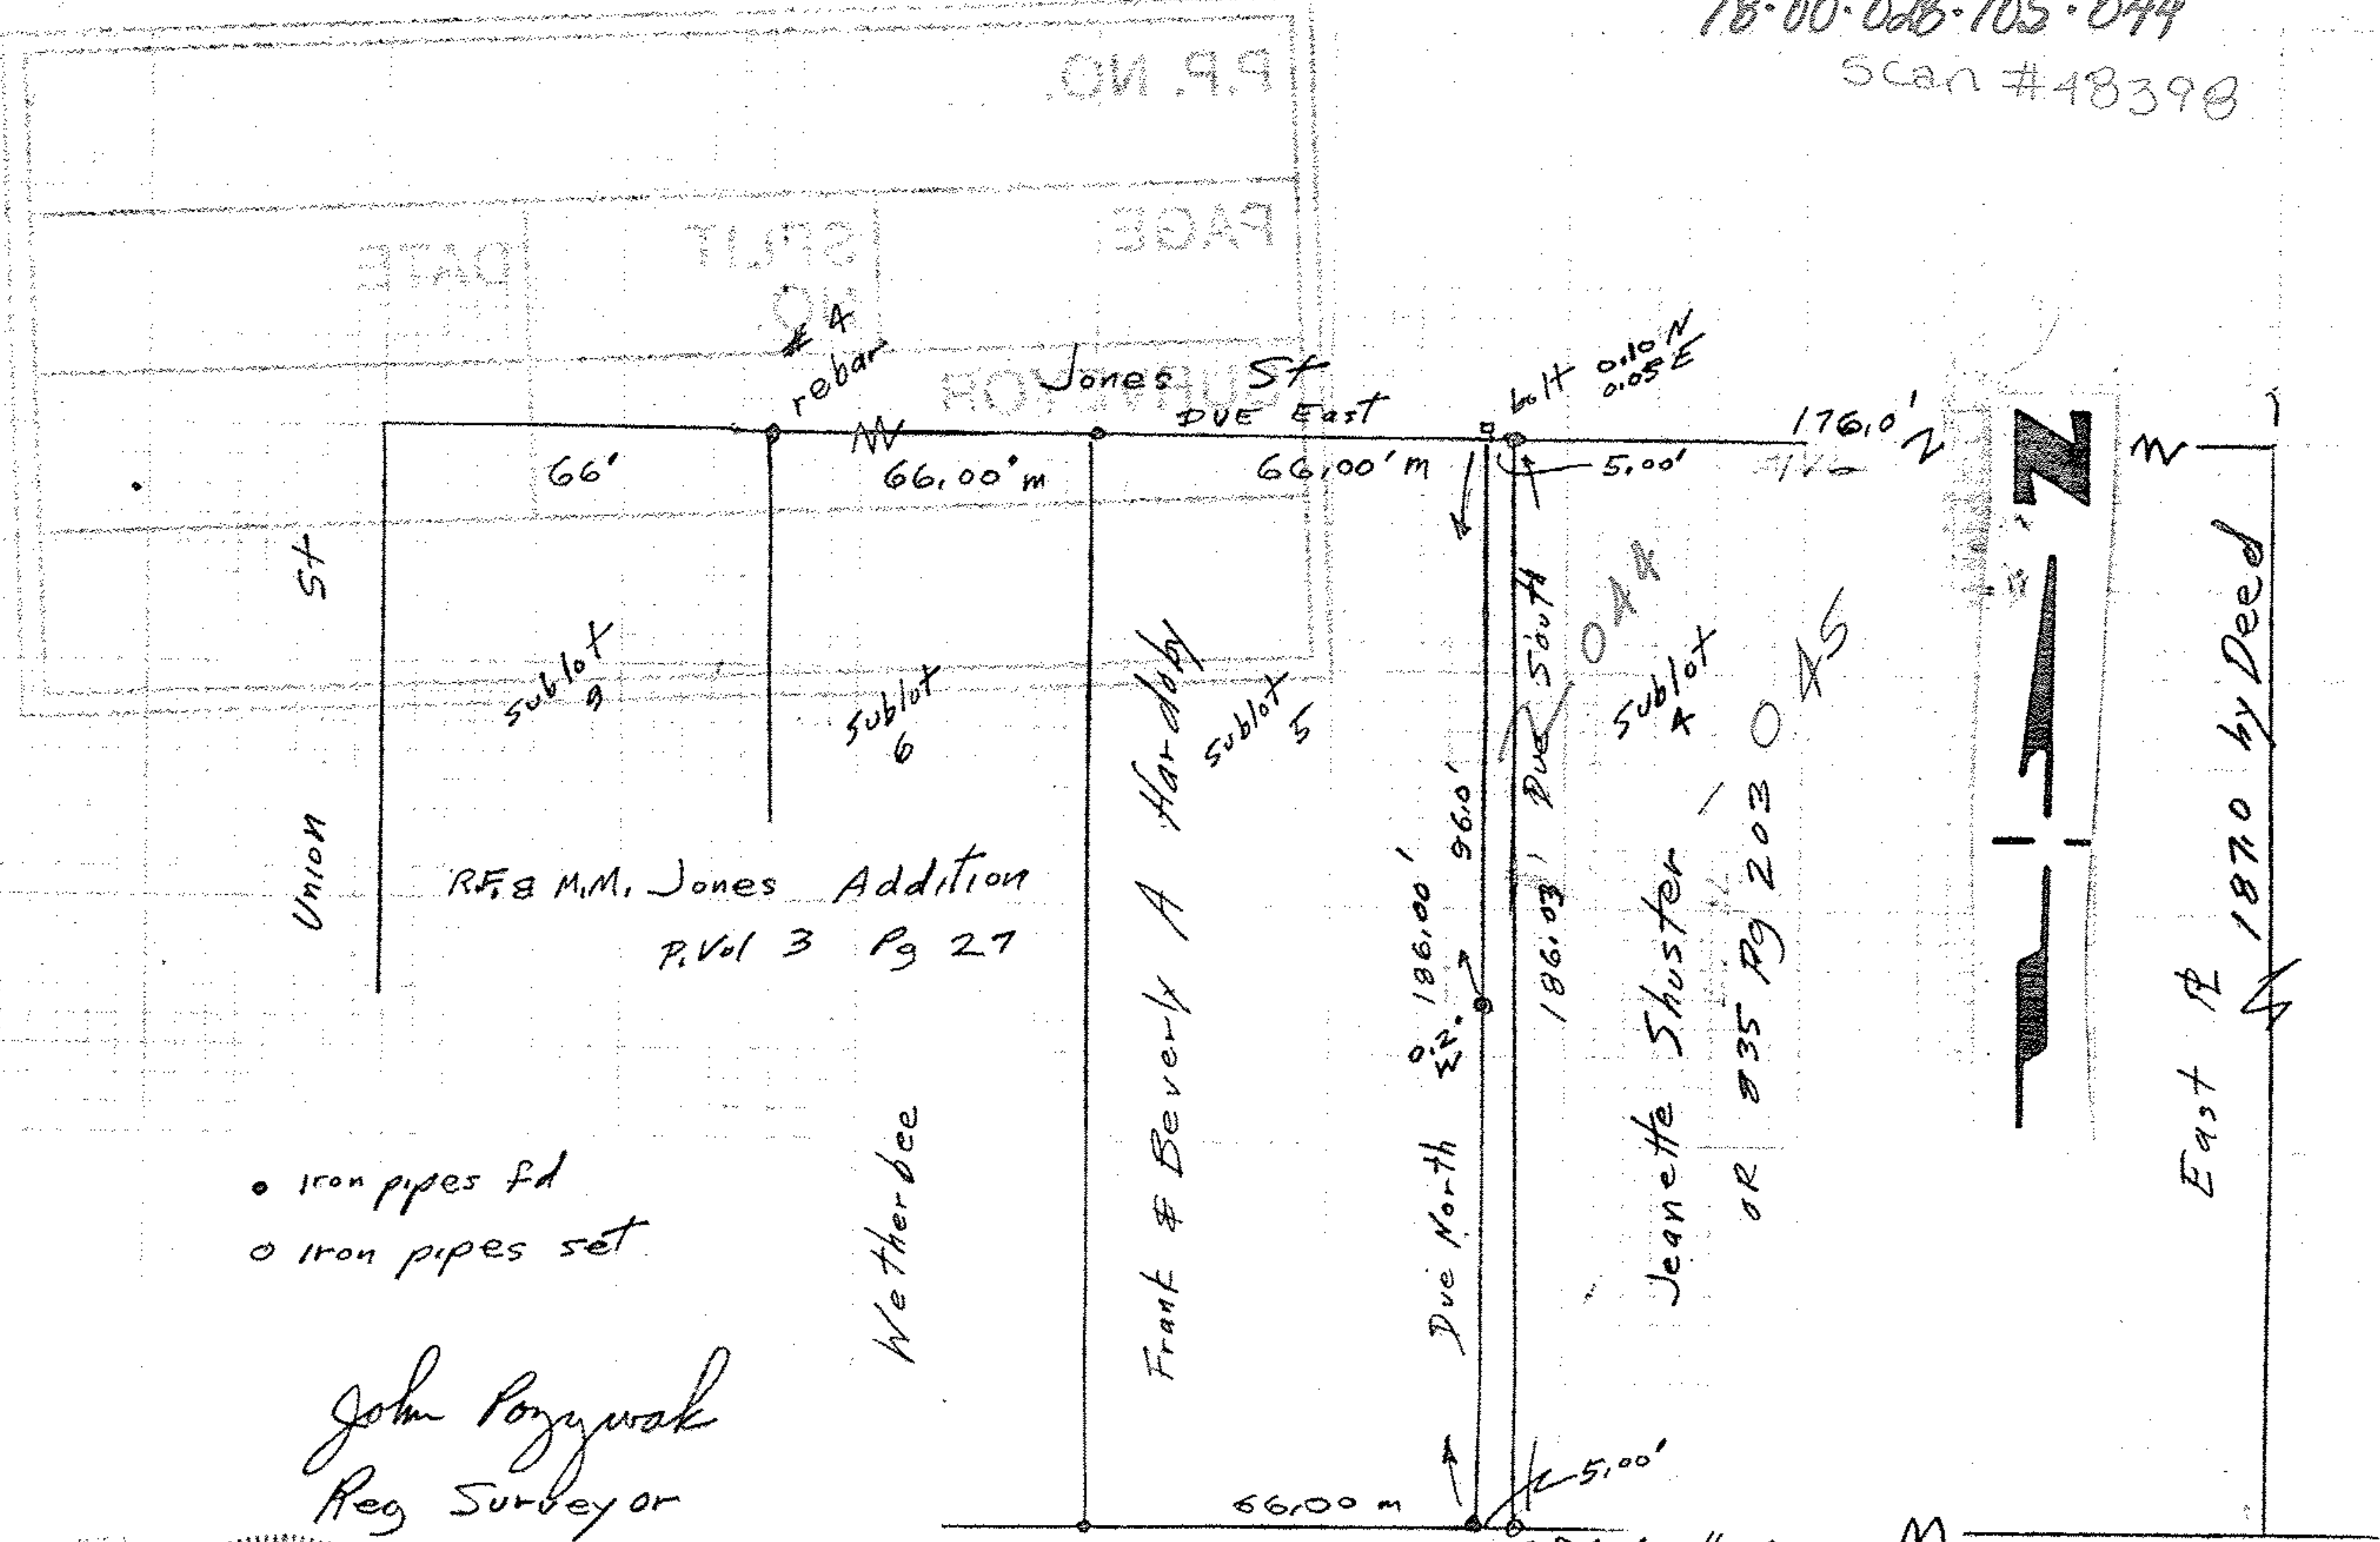

- iron pipes fd
- iron pipes set

John Pozywak
 Reg Surveyor
 5292

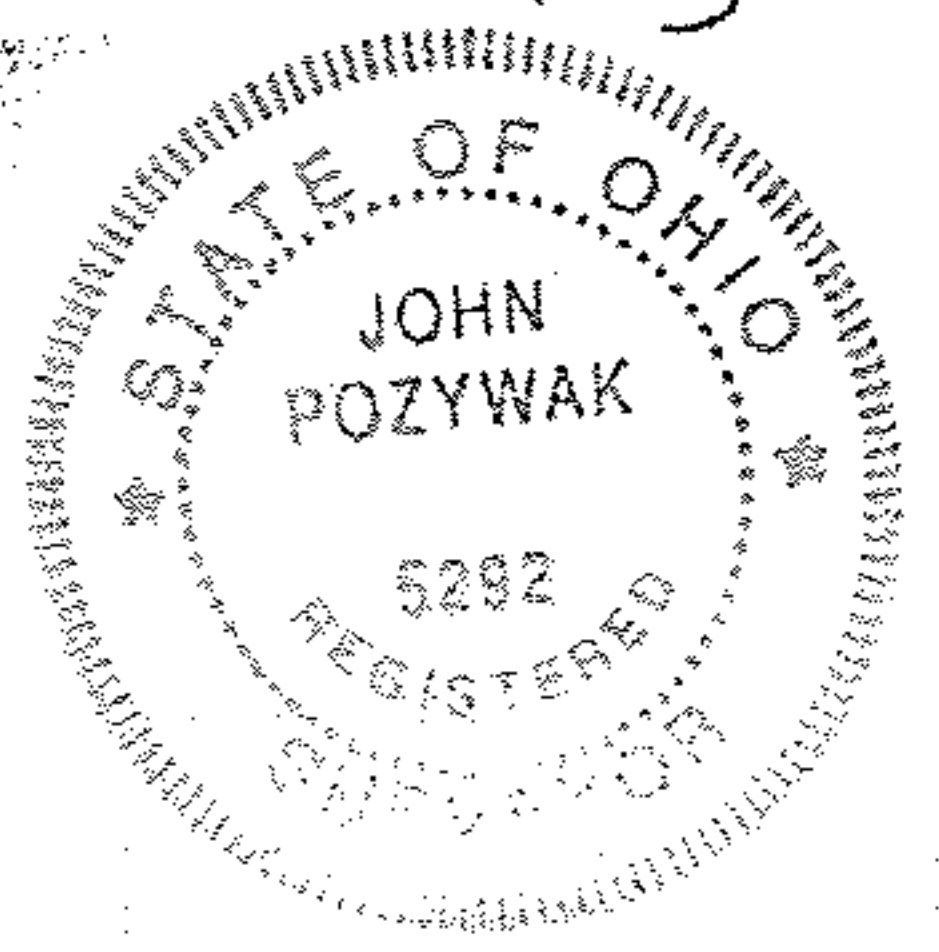

Bearing to described angles only

N 89° 40' 30" W
 Survey for Frank Hardoby
 Part of subplot 4
 Jones Add. P. Vol 3 Pg 27
 Original Wellington Township 28
 Lorain County Ohio
 Scale 1"=40' June 1994

East of 1870 by Deed