


Map of Part of Bennett and Kirk Co. Add.
Wellington Village Lorain Co. Ohio.
Scale 1" = 100' June 10, 1978

Volume 1 Page 33 Lorain Co. Records

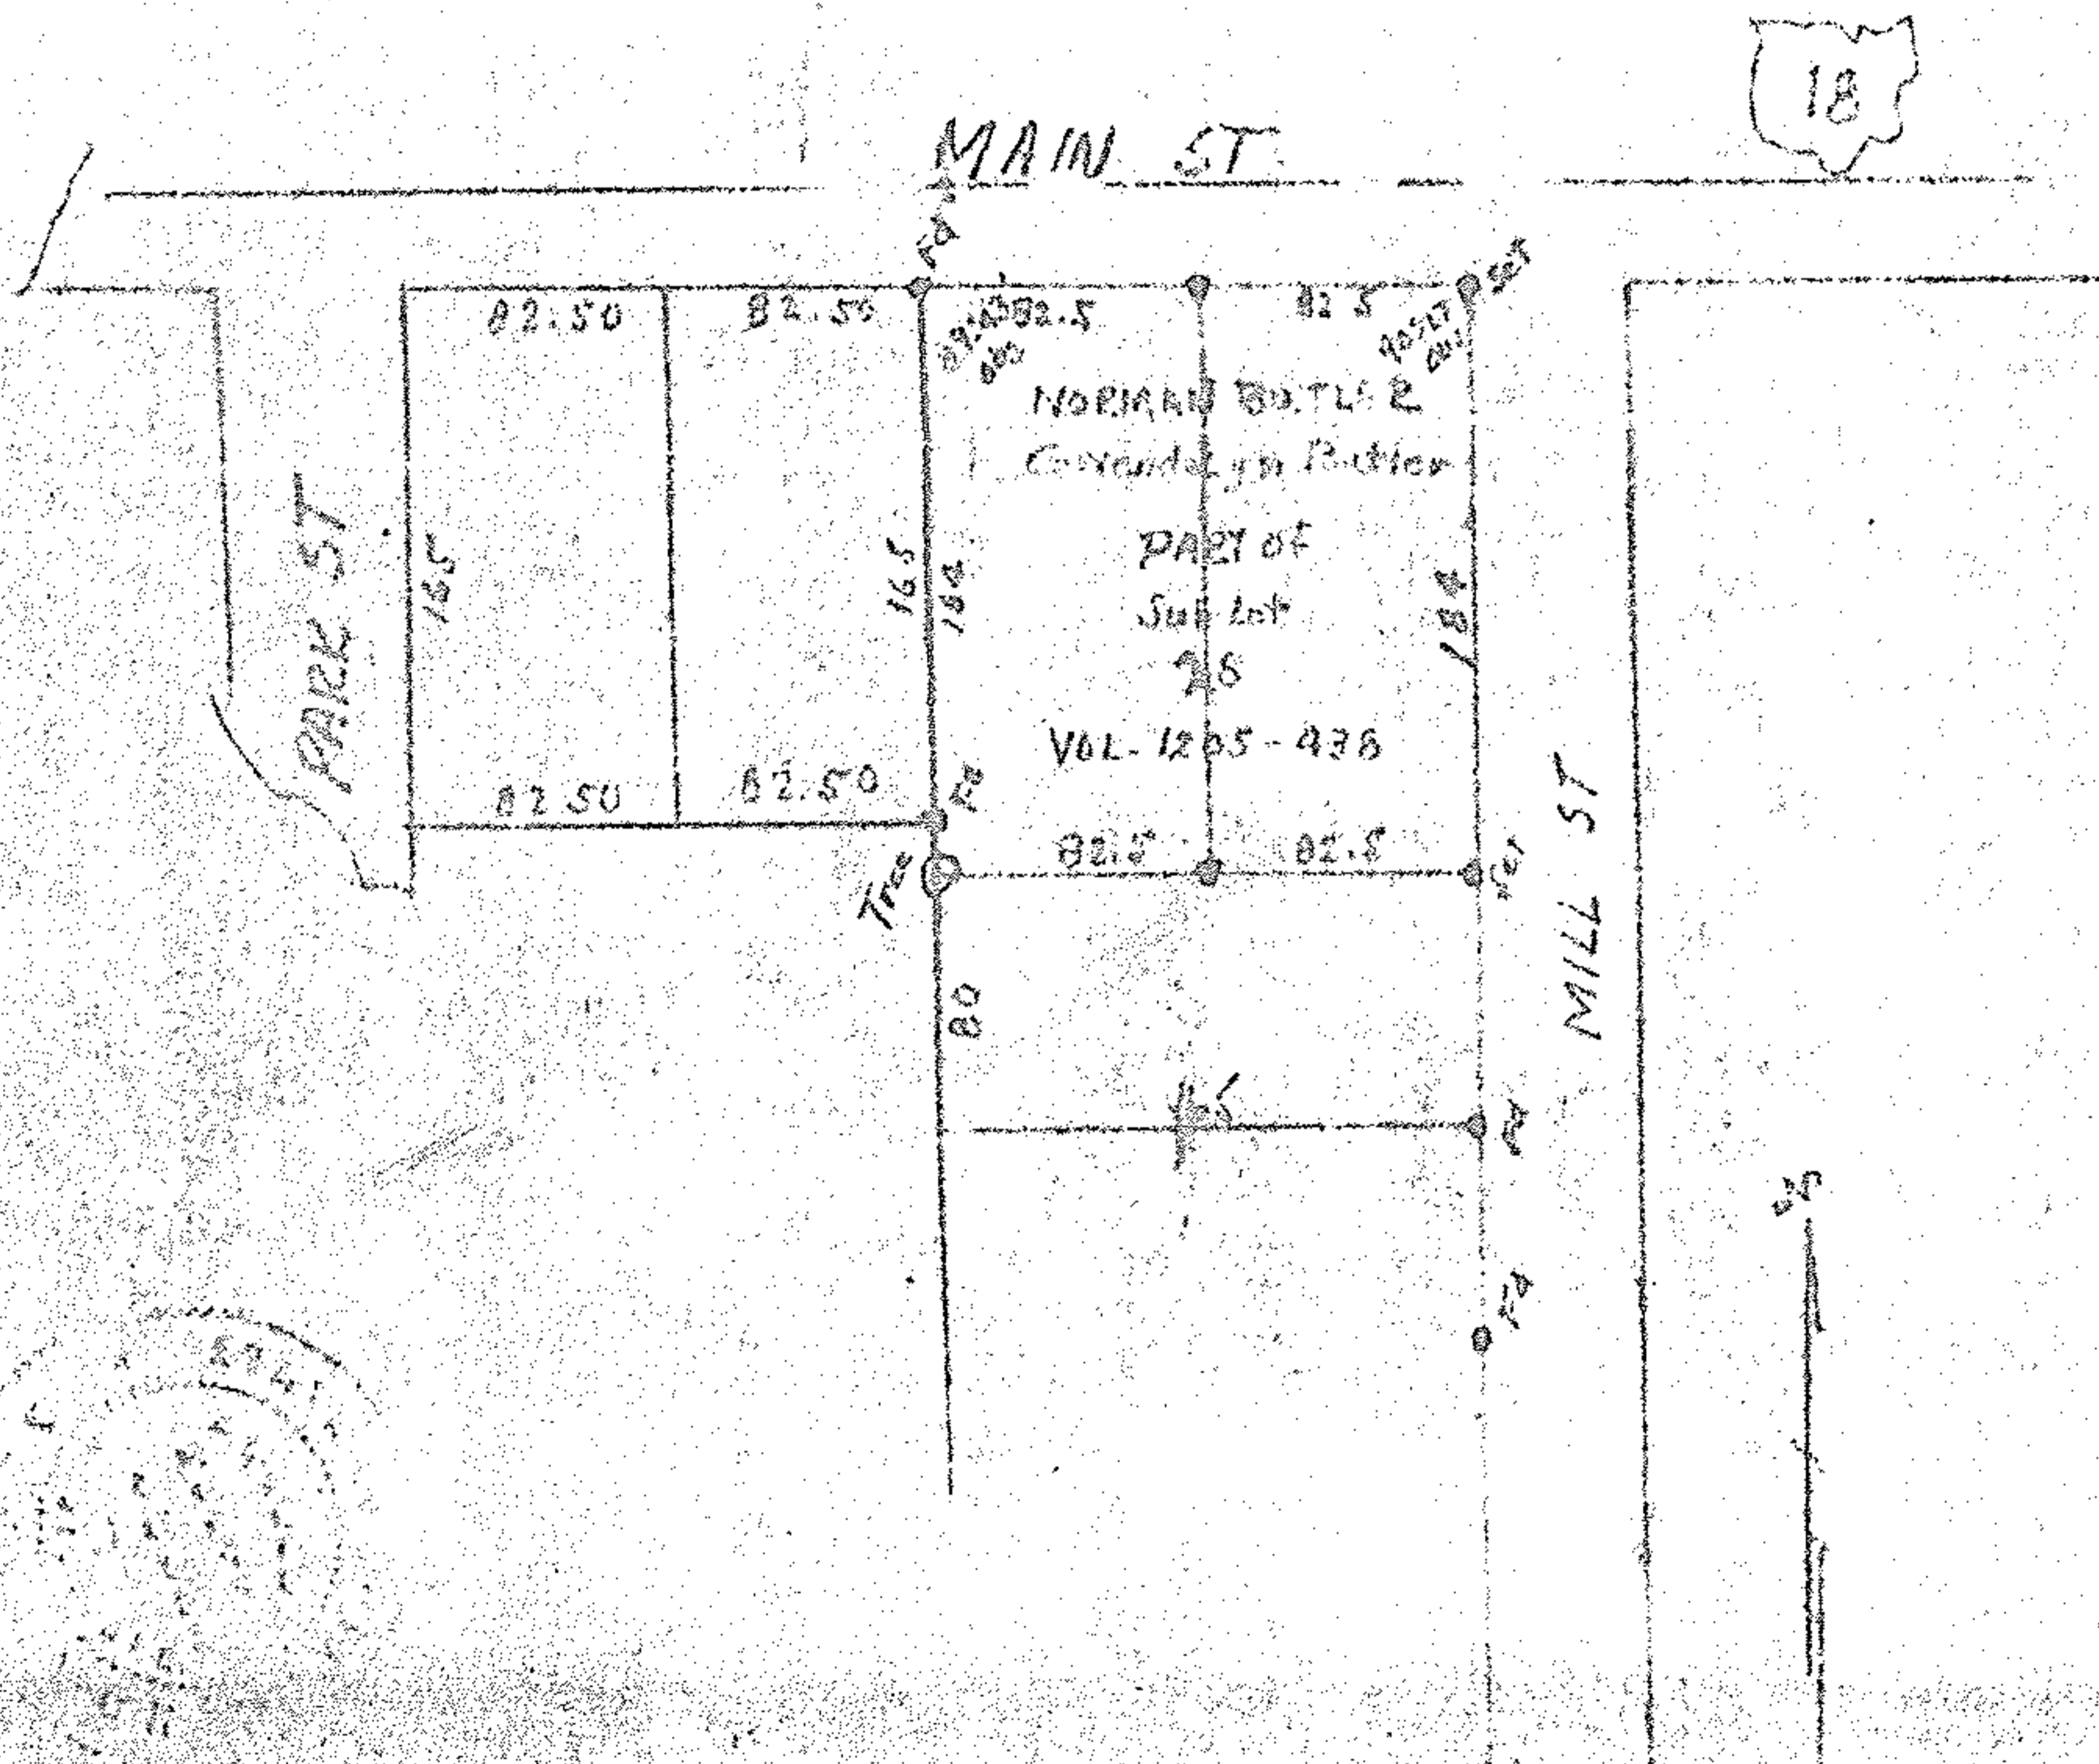

18-00-027-A
SCAN# 48409

The Wellington Planning Com.
James Guerin
9/24/78

18-00-027-

18-00-027-102