


Survey for Parcel Split
 Laurence Jackson
 Part of Original Lot 14
 Tract 3 Penfield Township
 Lorain County Ohio
 Scale 1" = 200' Oct 1991

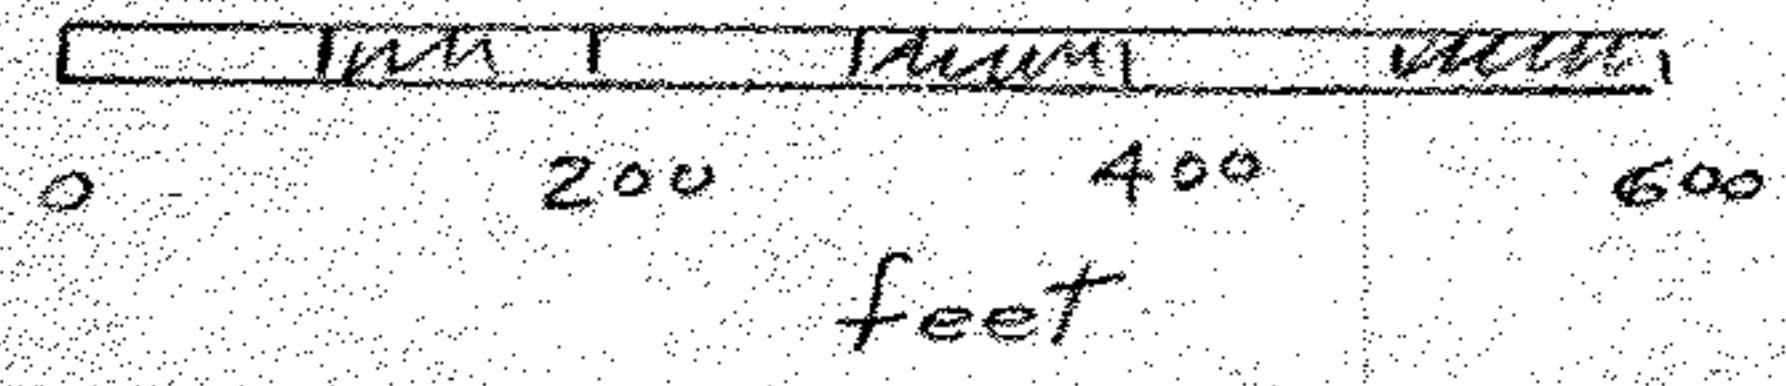

- o iron pipes fd
- iron pipes set

John Pozzywalski
 Reg Surveyor
 5292

19693
19698

APPROVED LORAIN CO. MAP DEPT.	
DATE	12-13-91
PAGE	19-G
BY	T. M. Mearns
VOID AFTER	19693

19698