


19-A 19-05-018-000-013-011  
Stanley & Thalia Sooy

See 18" File

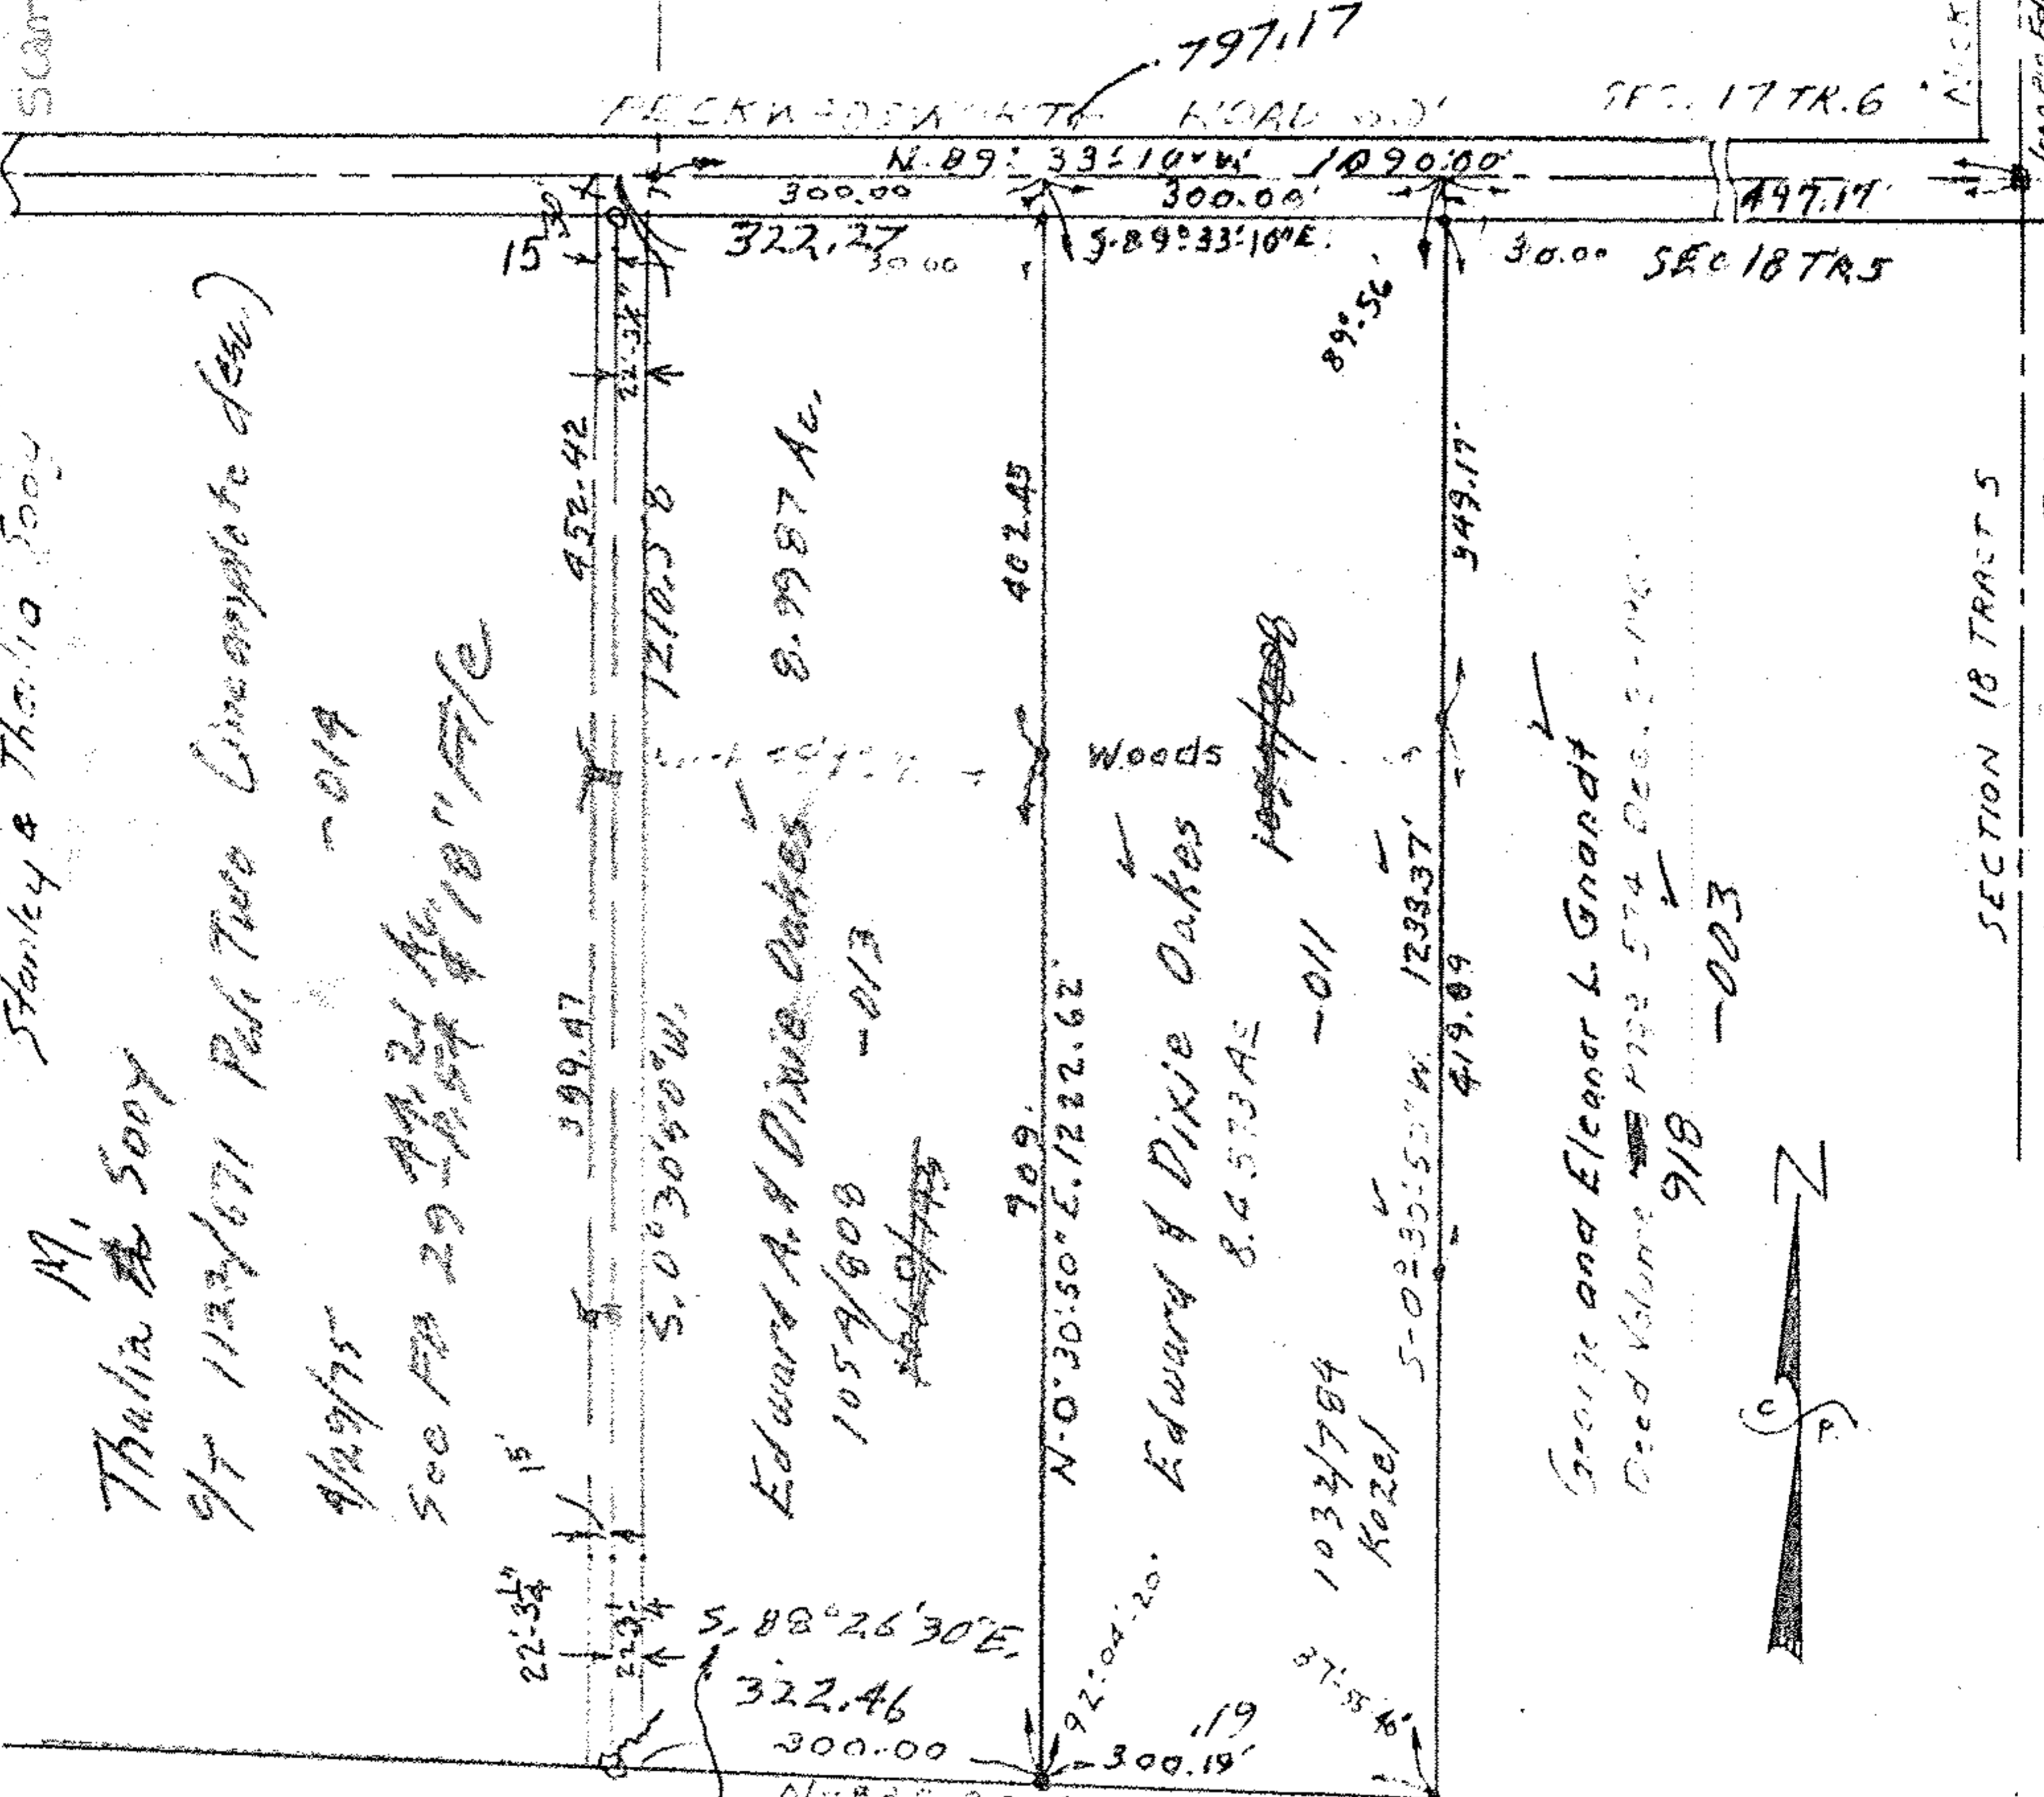

M. Thalia Sooy  
 9/7 1123/671 Part Two (incomplete desc.)  
 9/29/75  
 See PB 29-24-24 A.C. & 18" File

Edward A. & Dixie Oakes  
 1059/808 -013  
 8.9987 Ac.  
 Woods

Edward & Dixie Oakes  
 8.4573 Ac.  
 1034/784  
 Korzel

George and Eleanor L. Ghardt  
 Deed Volume 918  
 574 Dec. 2-1968

George and Eleanor L. Ghardt  
 Deed Volume 743 Page 422 April 1959  
 Rear Bearings Incorrect  
 -010

MAP OF SURVEY FOR STANLEY & THALIA SOOY  
 PART OF SECTION 18 TRACT 5  
 PENFIELD TOWNSHIP - LORAIN COUNTY OHIO  
 Scale 1" = 200' Sept. 2-1971  
 C.E. Penfound Registered Surveyor No. 3200

NICKLE-PLATE DIAG  
 ROAD 60  
 Iron Pin Edging Mon. Box

SECTION 18 TRACT 5  
 SECTION 17 TRACT 5