


21-02-020-000-021
21-E Scan # 48464

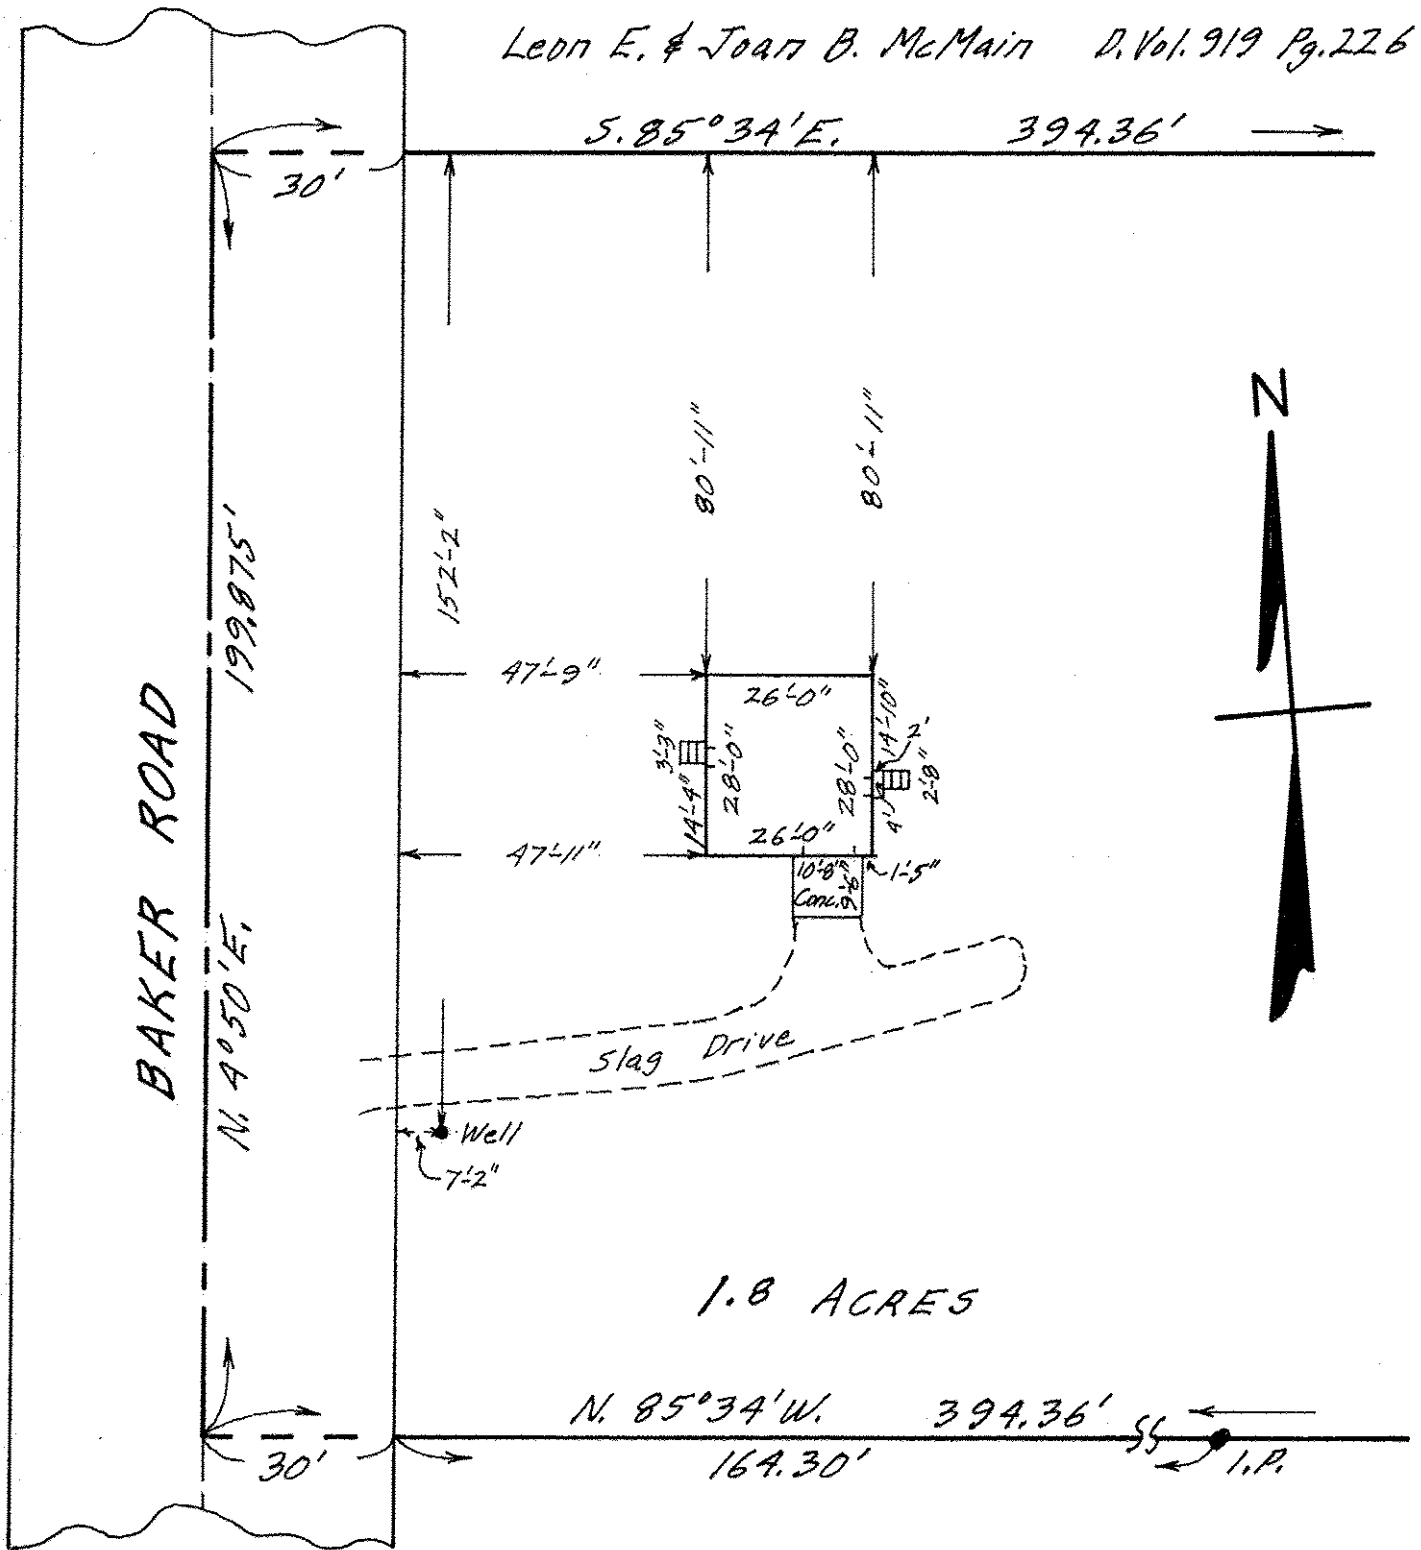

1.8 ACRES

DETAIL SHEET OF PART OF ORIGINAL LOT NO. 20
TRACT NO. 2 HUNTINGTON TOWNSHIP
LORAIN COUNTY OHIO

DETAIL SCALE: 1" = 30' MAR. 13-1970 6:30 P.M.

NOTE: There are no encroachments on this property.

Gary E. Penfound REG. SURVEYOR NO. 4457

CITY TITLE CO. Order No. E-1051-2

Earl to Chapman