



Dane A. HAPONEK
 5444 Stoney Ridge Road North Ridgeville, Ohio 44039 (440) 327-4776
 Registered Surveyor # S6211

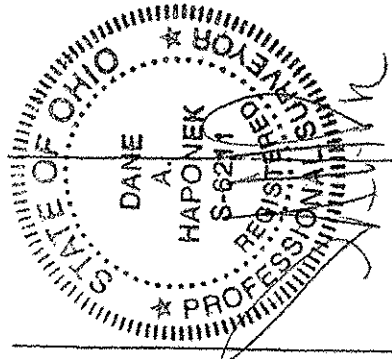

DATE: MAY 2006
 SCALE: 1"=30'

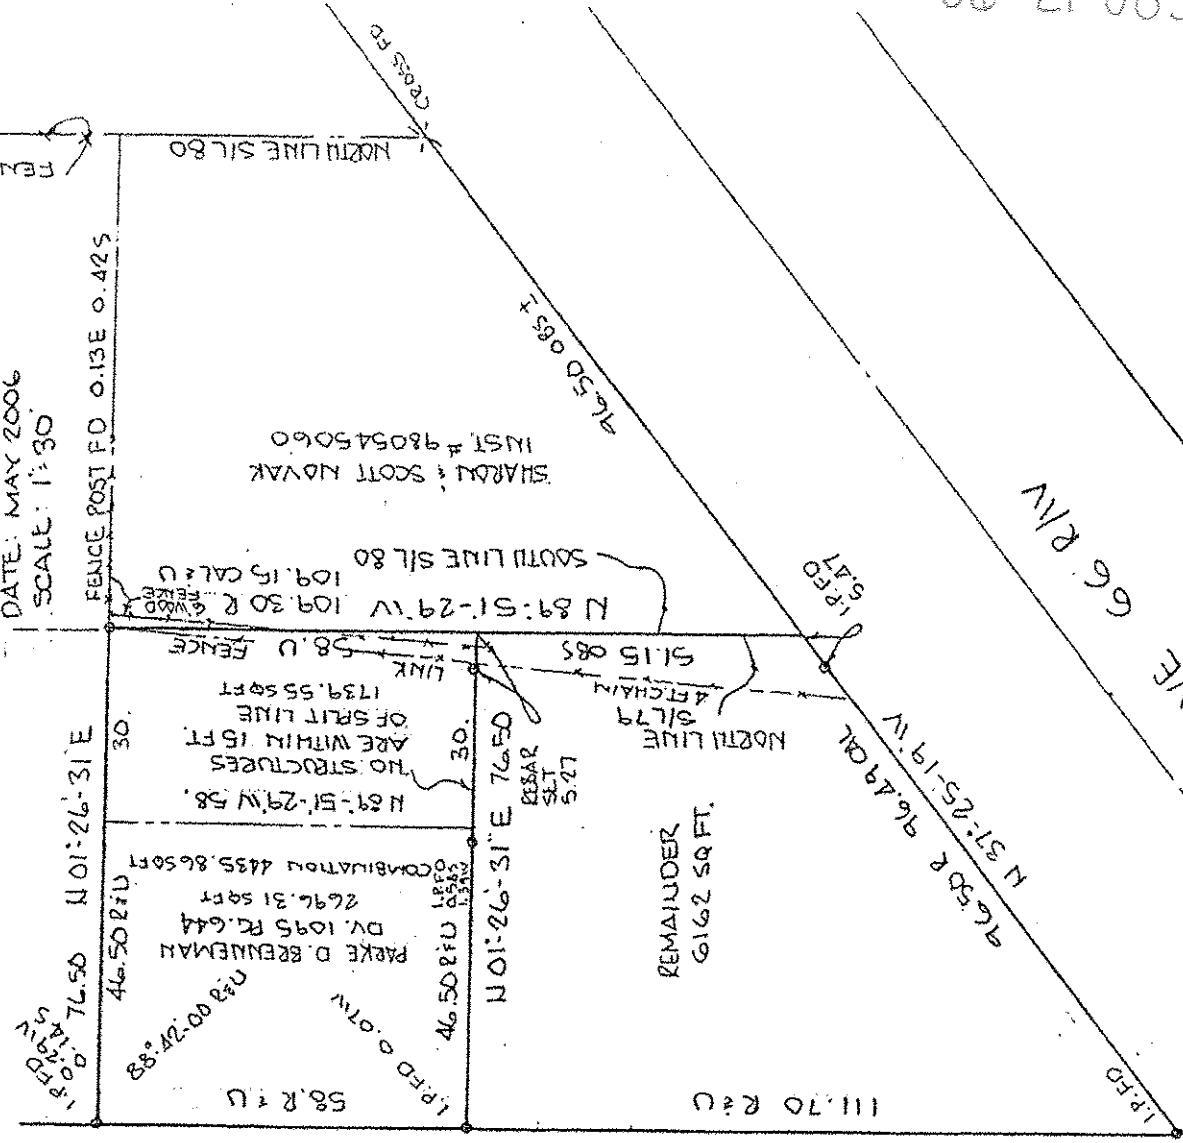

SURVEY
 OF PART OF
 SUBLOT NO 79

WM. A. BRAMAN SUBN.
 PLAT VOL 3 PG 1
 PART OF ORIG. ELYRIA TWP. LOS
 26, 27, 70, 83 AND 84 WEST OF SUECK CR

PREPARED FOR:
 EDWARD KEARNEY
 27250 CAPEL RD.
 COLUMBIA STA., OH 44028

03289

APPROVED L.C. CO. M. PT
DATE 9-23-14
PAGE 6-30
BY JHatfield
#14-03289

06-24-083-101-026 SCAN# 48493