


Plat of Survey
Judith Bowles & Ralph Walker

LaGrange Twp. (T 4N, R 17W) O.L. 59
Lorain County Ohio

Carlson Surveys October 2014

Job: 1501-52R

Wakeman-Belden Rd. (S.R. 303) Varies
LOR-303-9.94

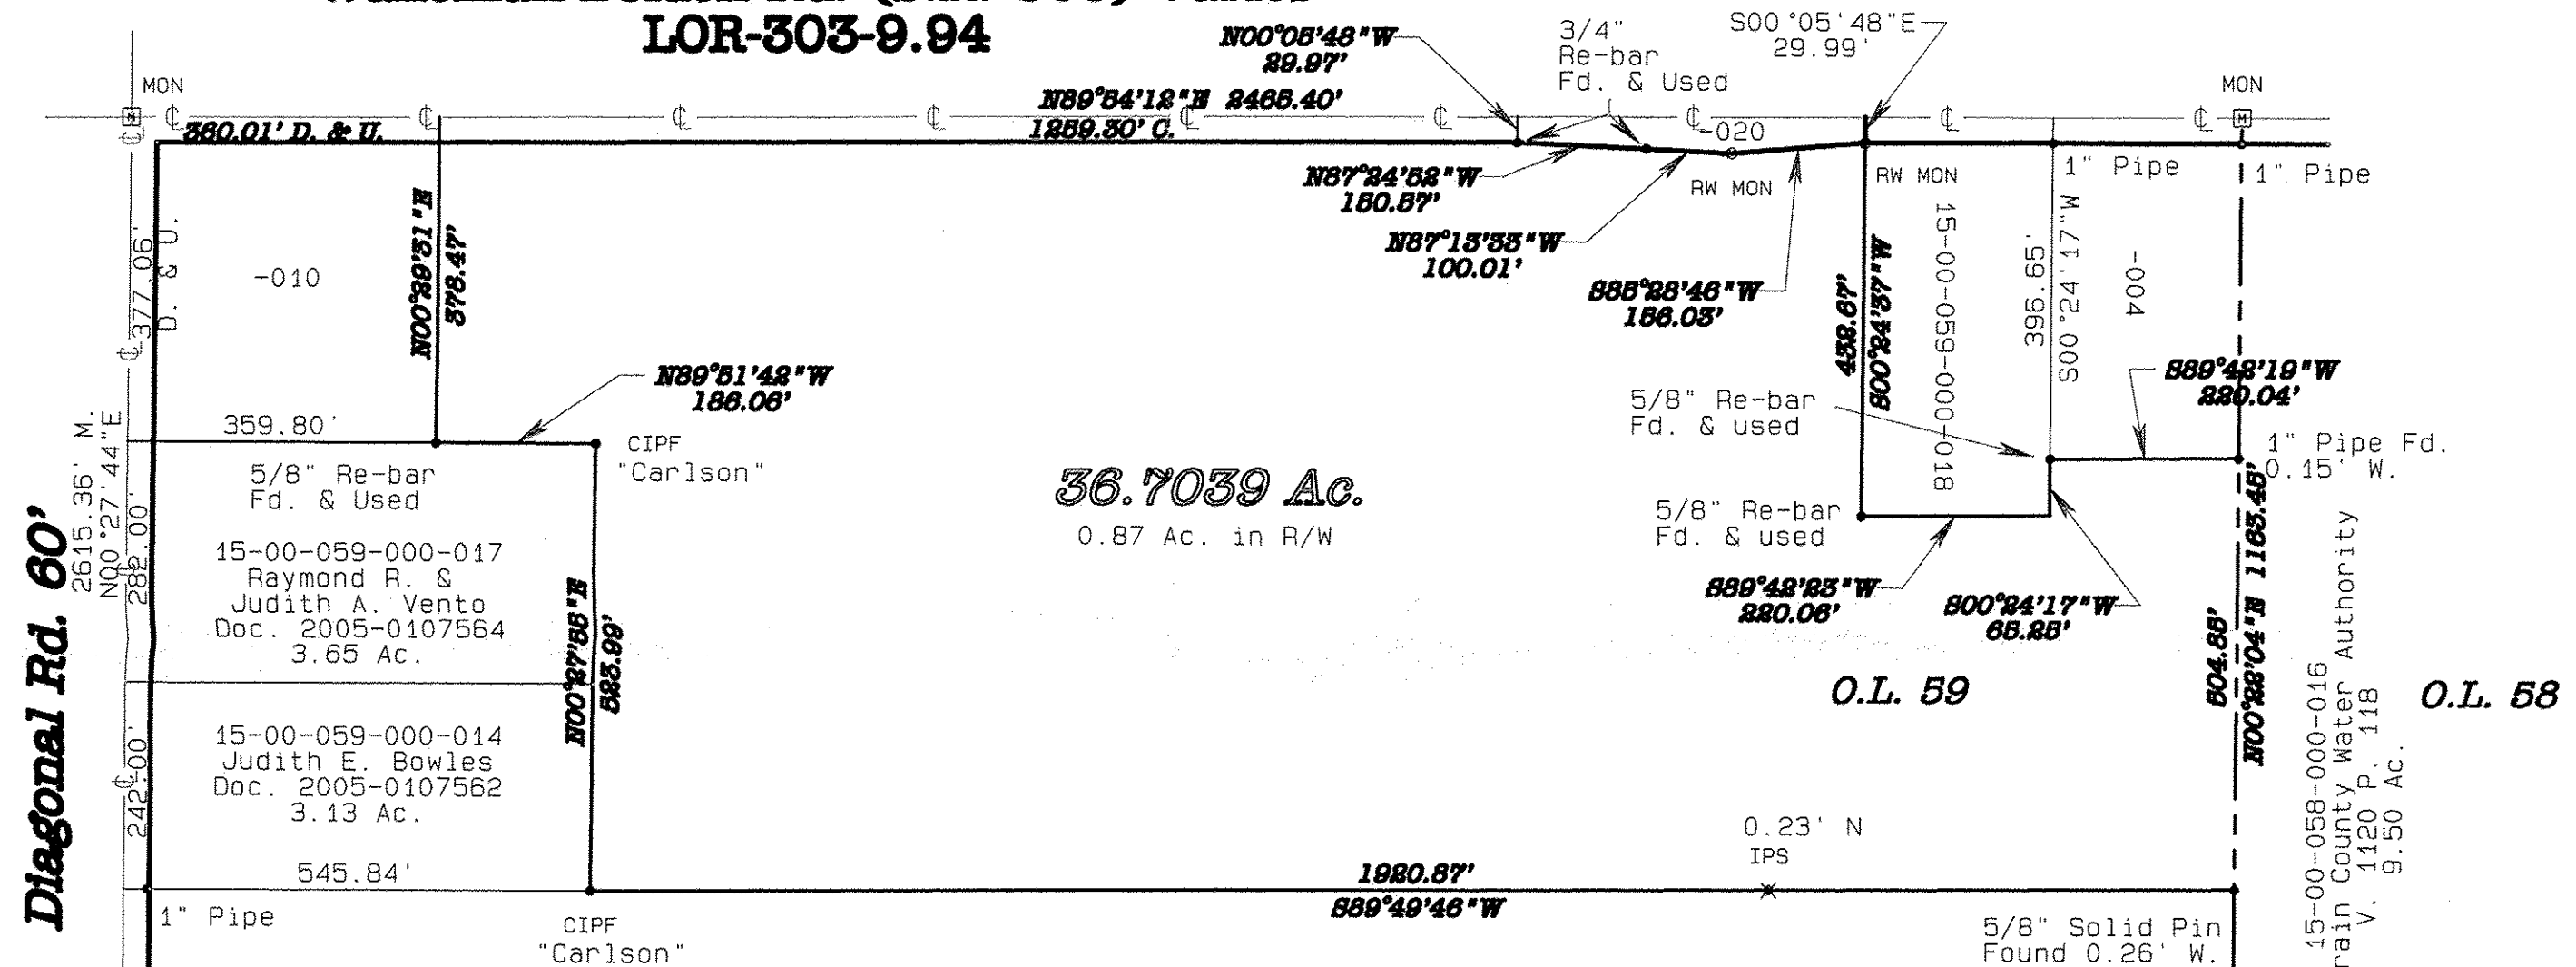

36.7039 Ac.
0.87 Ac. in R/W

15-00-059-000-002
Melvin Hale
Doc. 2007-0235858
50.96 Ac.

Adjoining Property owners

15-00-059-000-004
Oran B. & Reta F. Smith
Doc. 2004-0005551
2.00 Ac.

15-00-059-000-010
Robert W. Stewart Jr., Trustee
Doc. 2009-0317717
3.12 Ac.

15-00-059-000-018
Kelly A. Marks
Doc. 2005-0107565
2.33 Ac.

15-00-059-000-020
State of Ohio
Doc. 2013-0461999
0.06 Ac.

15-00-058-000-016
Rural Lorain County Water Authority
V. 1120 P. 118
9.50 Ac.

APPROVED
LORAIN CO.
MAP DEPT
DATE 11-24-14
PAGE 15-E
BY R. MAINES
#14-03062-A

15-00-059-000-021
scan # 48516

