


PREPARED FOR

**GEORGE AND VIRGINIA VASCI**


SITUATED IN THE CITY OF AMHERST COUNTY OF LORAIN AND STATE OF OHIO AND KNOWN AS BEING PART OF ORIGINAL AMHERST TOWNSHIP LOTS 98 AND 99

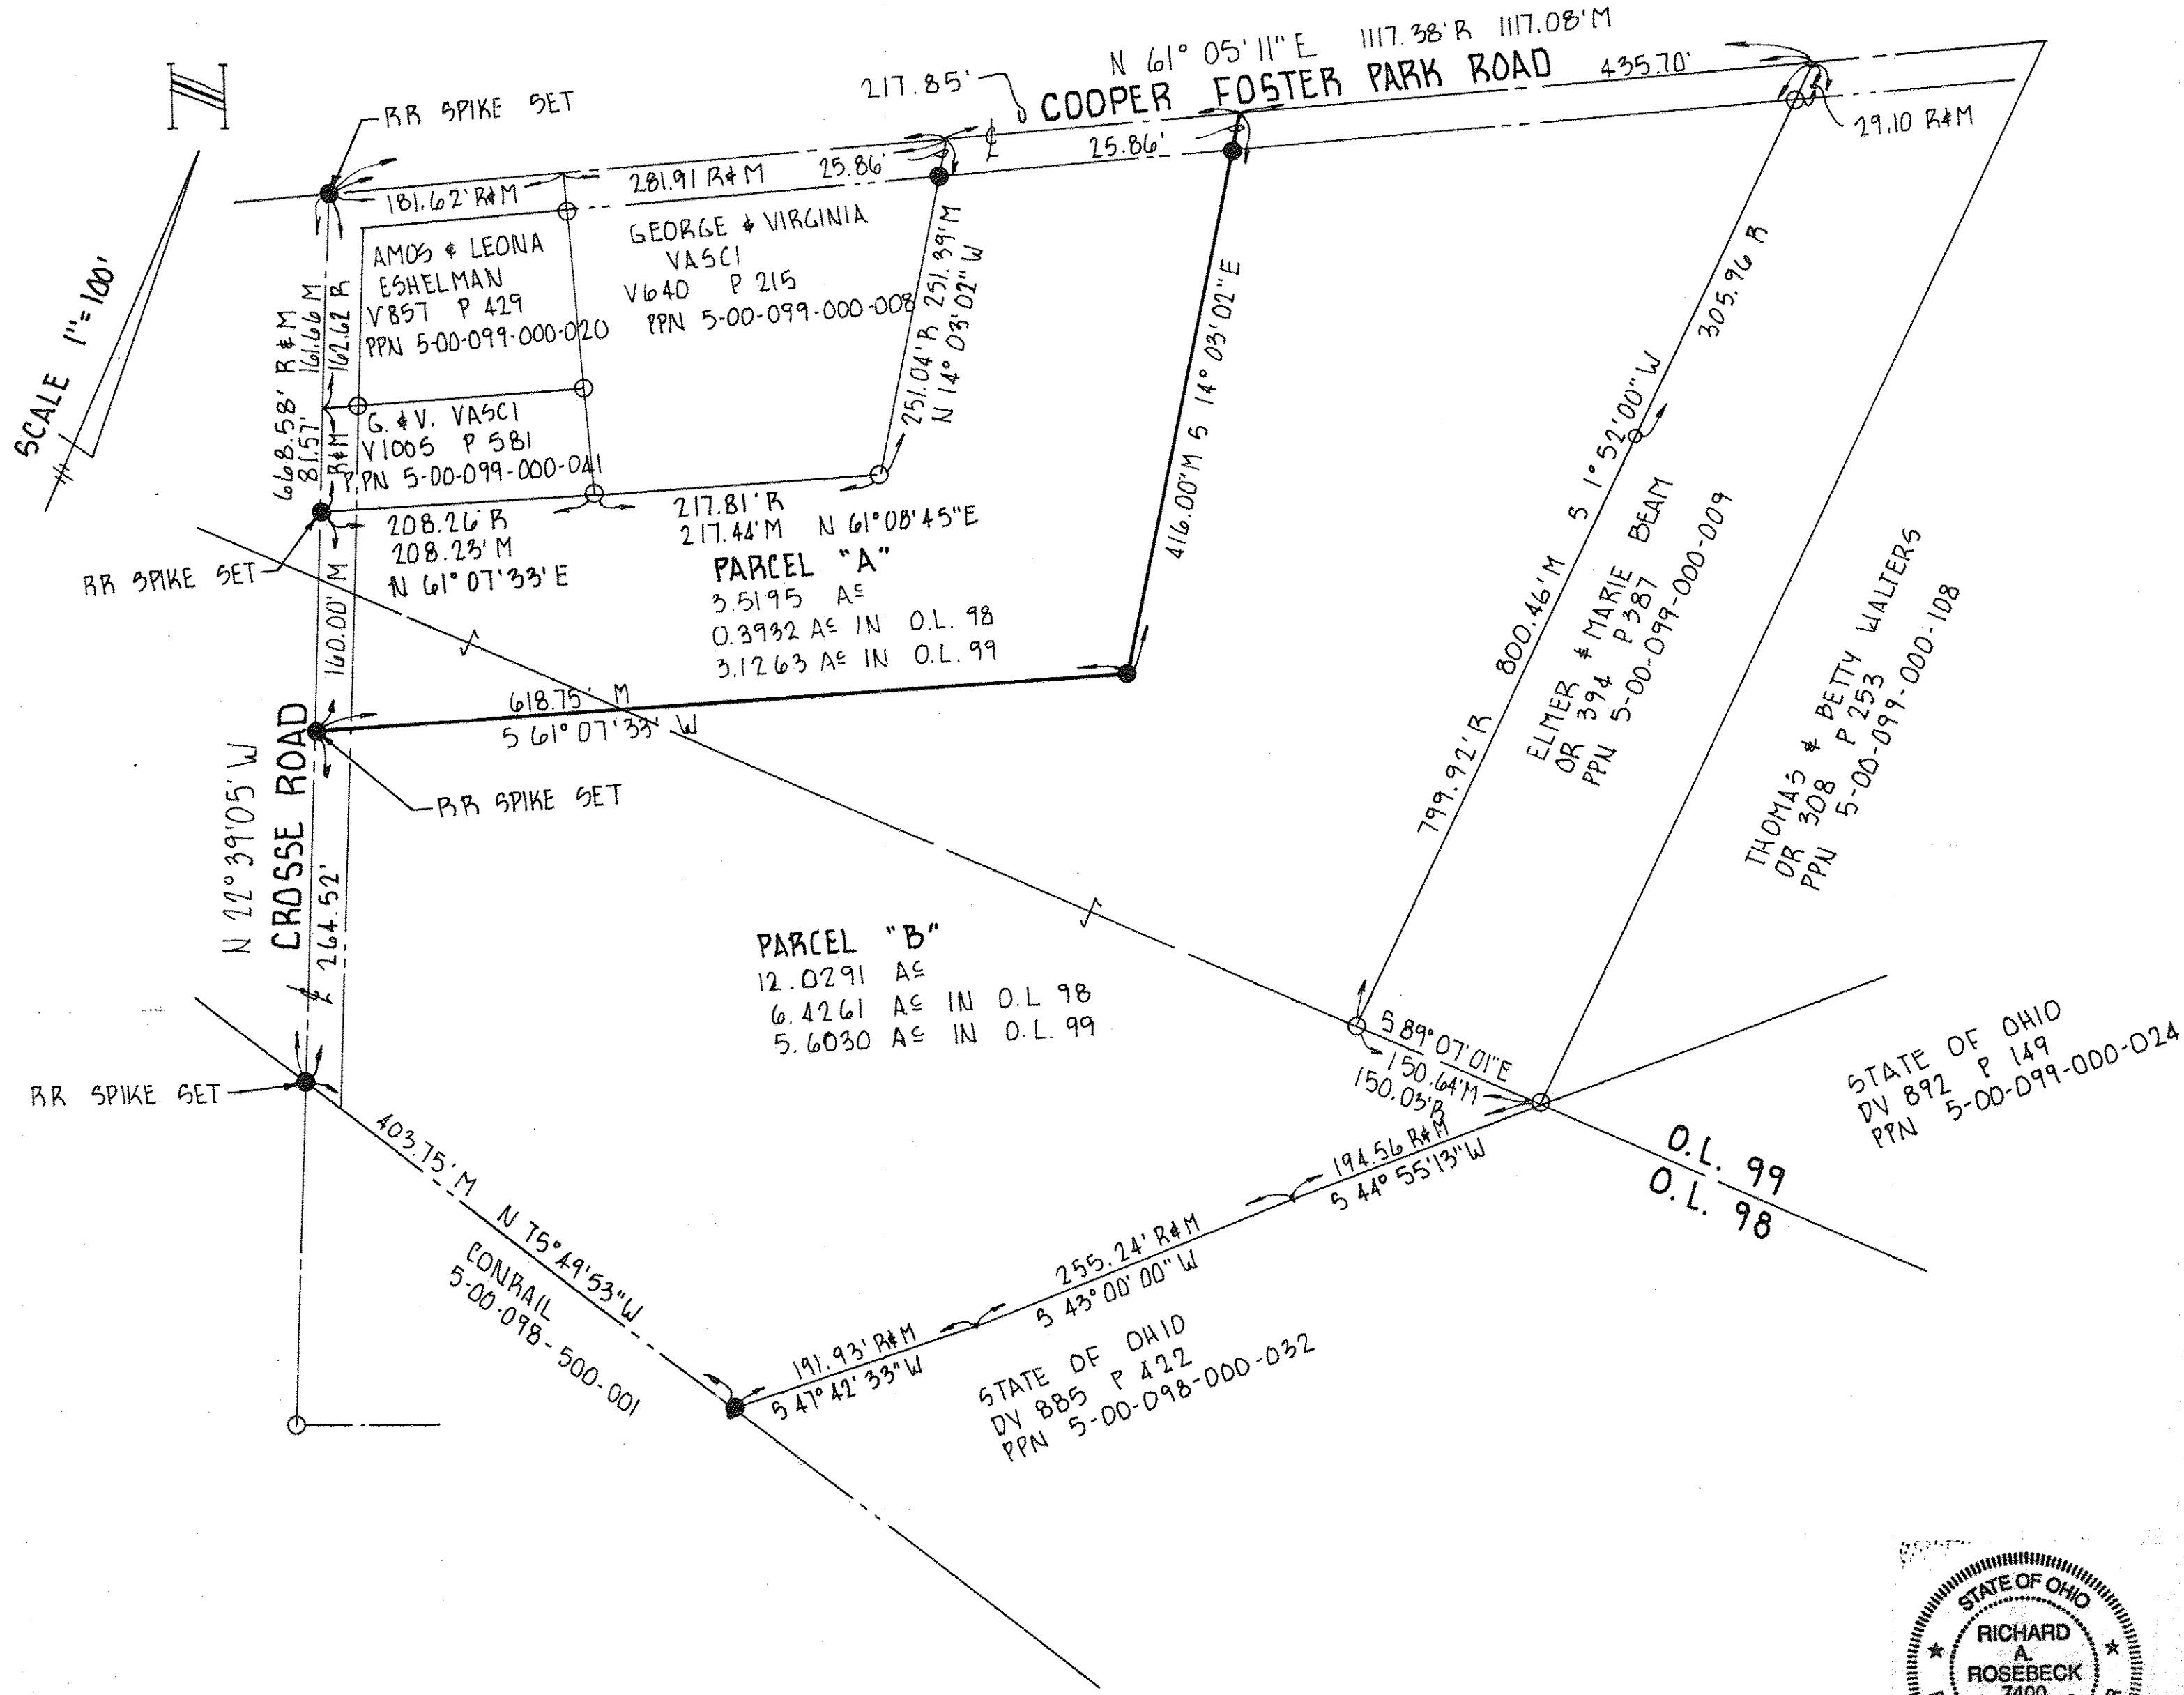

**LEGEND**

- IRON PIPE FOUND
- IRON PIPE SET (UNLESS NOTED OTHERWISE)
- R RECORD DISTANCE
- M MEASURED DISTANCE

BEARINGS ARE GIVEN TO AN ASSUMED MERIDIAN FOR THE PURPOSE OF DESCRIBING ANGLES ONLY. DISTANCES ARE GIVEN IN FEET AND DECIMAL PARTS THEREOF. MONUMENTS WERE FOUND OR SET AT ALL POINTS INDICATED ALL OF WHICH I CERTIFY TO BE CORRECT TO THE BEST OF MY PROFESSIONAL KNOWLEDGE INFORMATION AND BELIEF

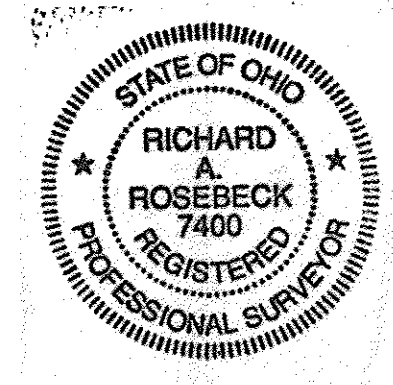

*Richard Rosebeck*  
 RICHARD ROSEBECK SURVEYOR NO 7400