


05-00-099-000-113
 05-00-098-B 114
 Scan # 48560 115

PREPARED FOR

JAMES AND MAXINE MANN

SITUATED IN THE CITY OF AMHERST COUNTY OF LORAIN AND STATE OF OHIO AND KNOWN AS BEING PART OF ORIGINAL AMHERST TOWNSHIP LOTS 98 AND 99

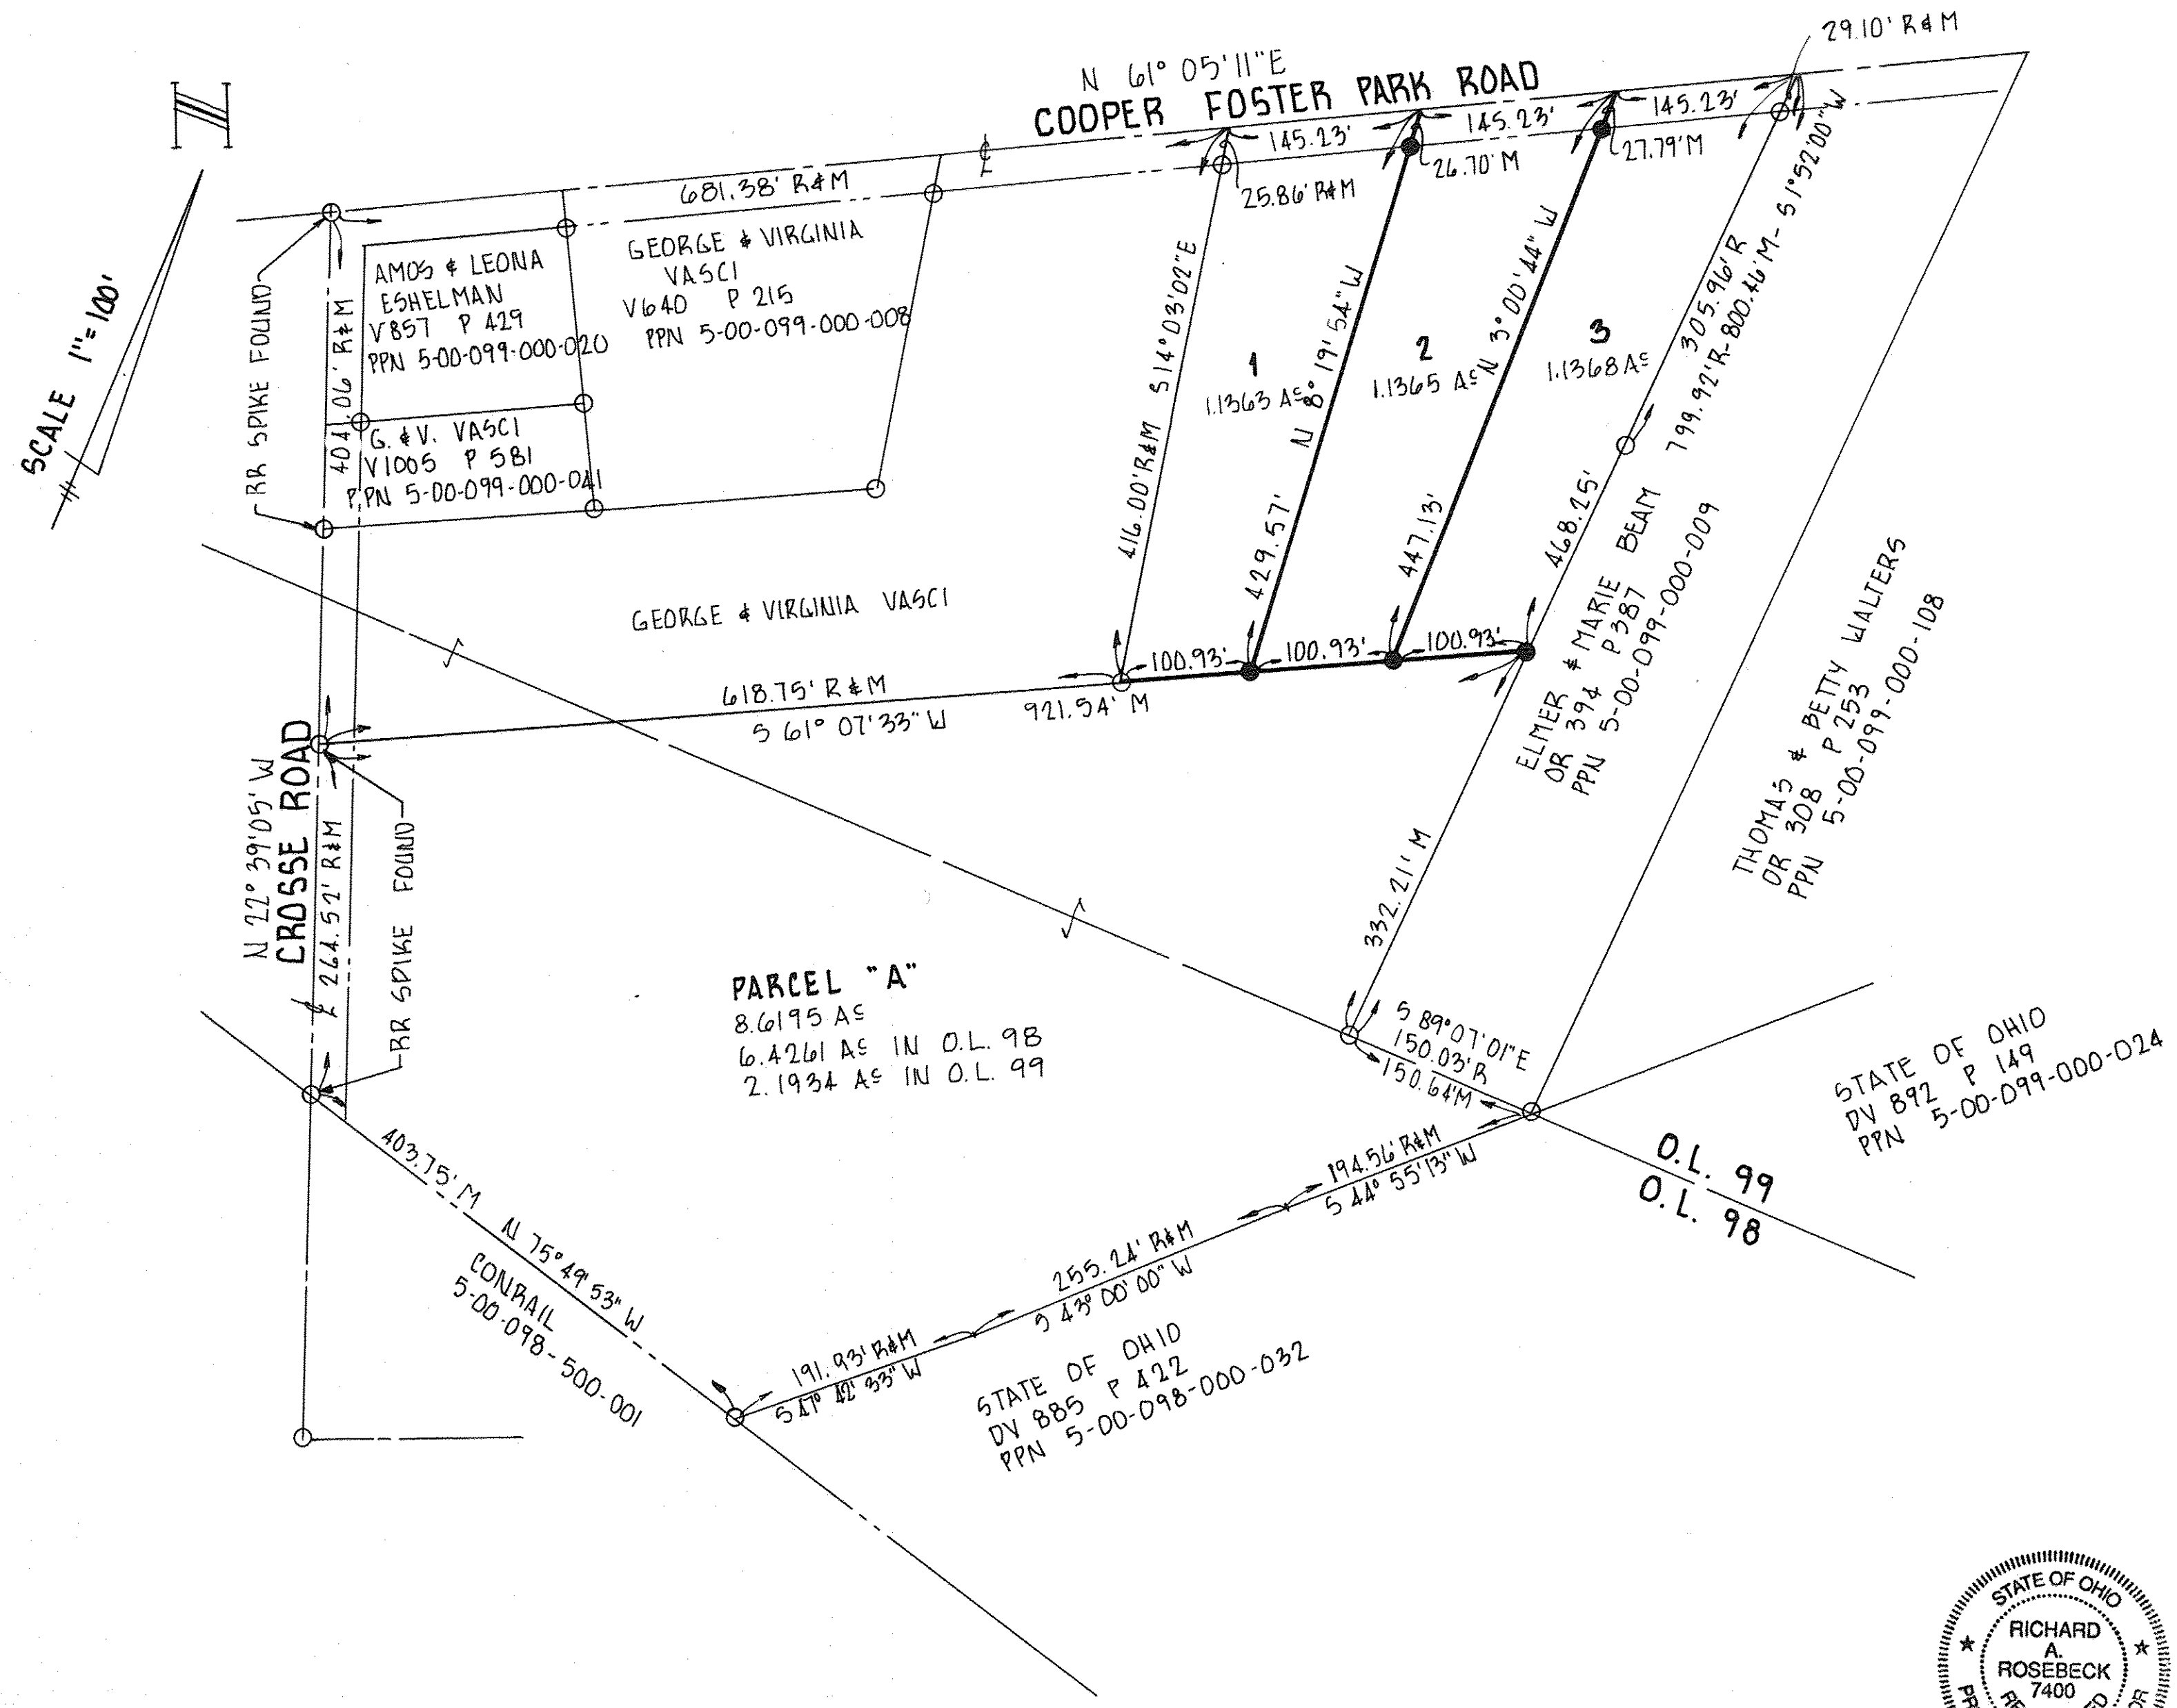

LEGEND

- IRON PIPE FOUND (UNLESS NOTED OTHERWISE)
- IRON PIPE SET
- R RECORD DISTANCE
- M MEASURED DISTANCE

BEARINGS ARE GIVEN TO AN ASSUMED MERIDIAN FOR THE PURPOSE OF DESCRIBING ANGLES ONLY. DISTANCES ARE GIVEN IN FEET AND DECIMAL PARTS THEREOF. MONUMENTS WERE FOUND OR SET AT ALL POINTS INDICATED ALL OF WHICH I CERTIFY TO BE CORRECT TO THE BEST OF MY PROFESSIONAL KNOWLEDGE INFORMATION AND BELIEF



Richard Rosebeck
 RICHARD ROSEBECK

SURVEYOR NO 7400