
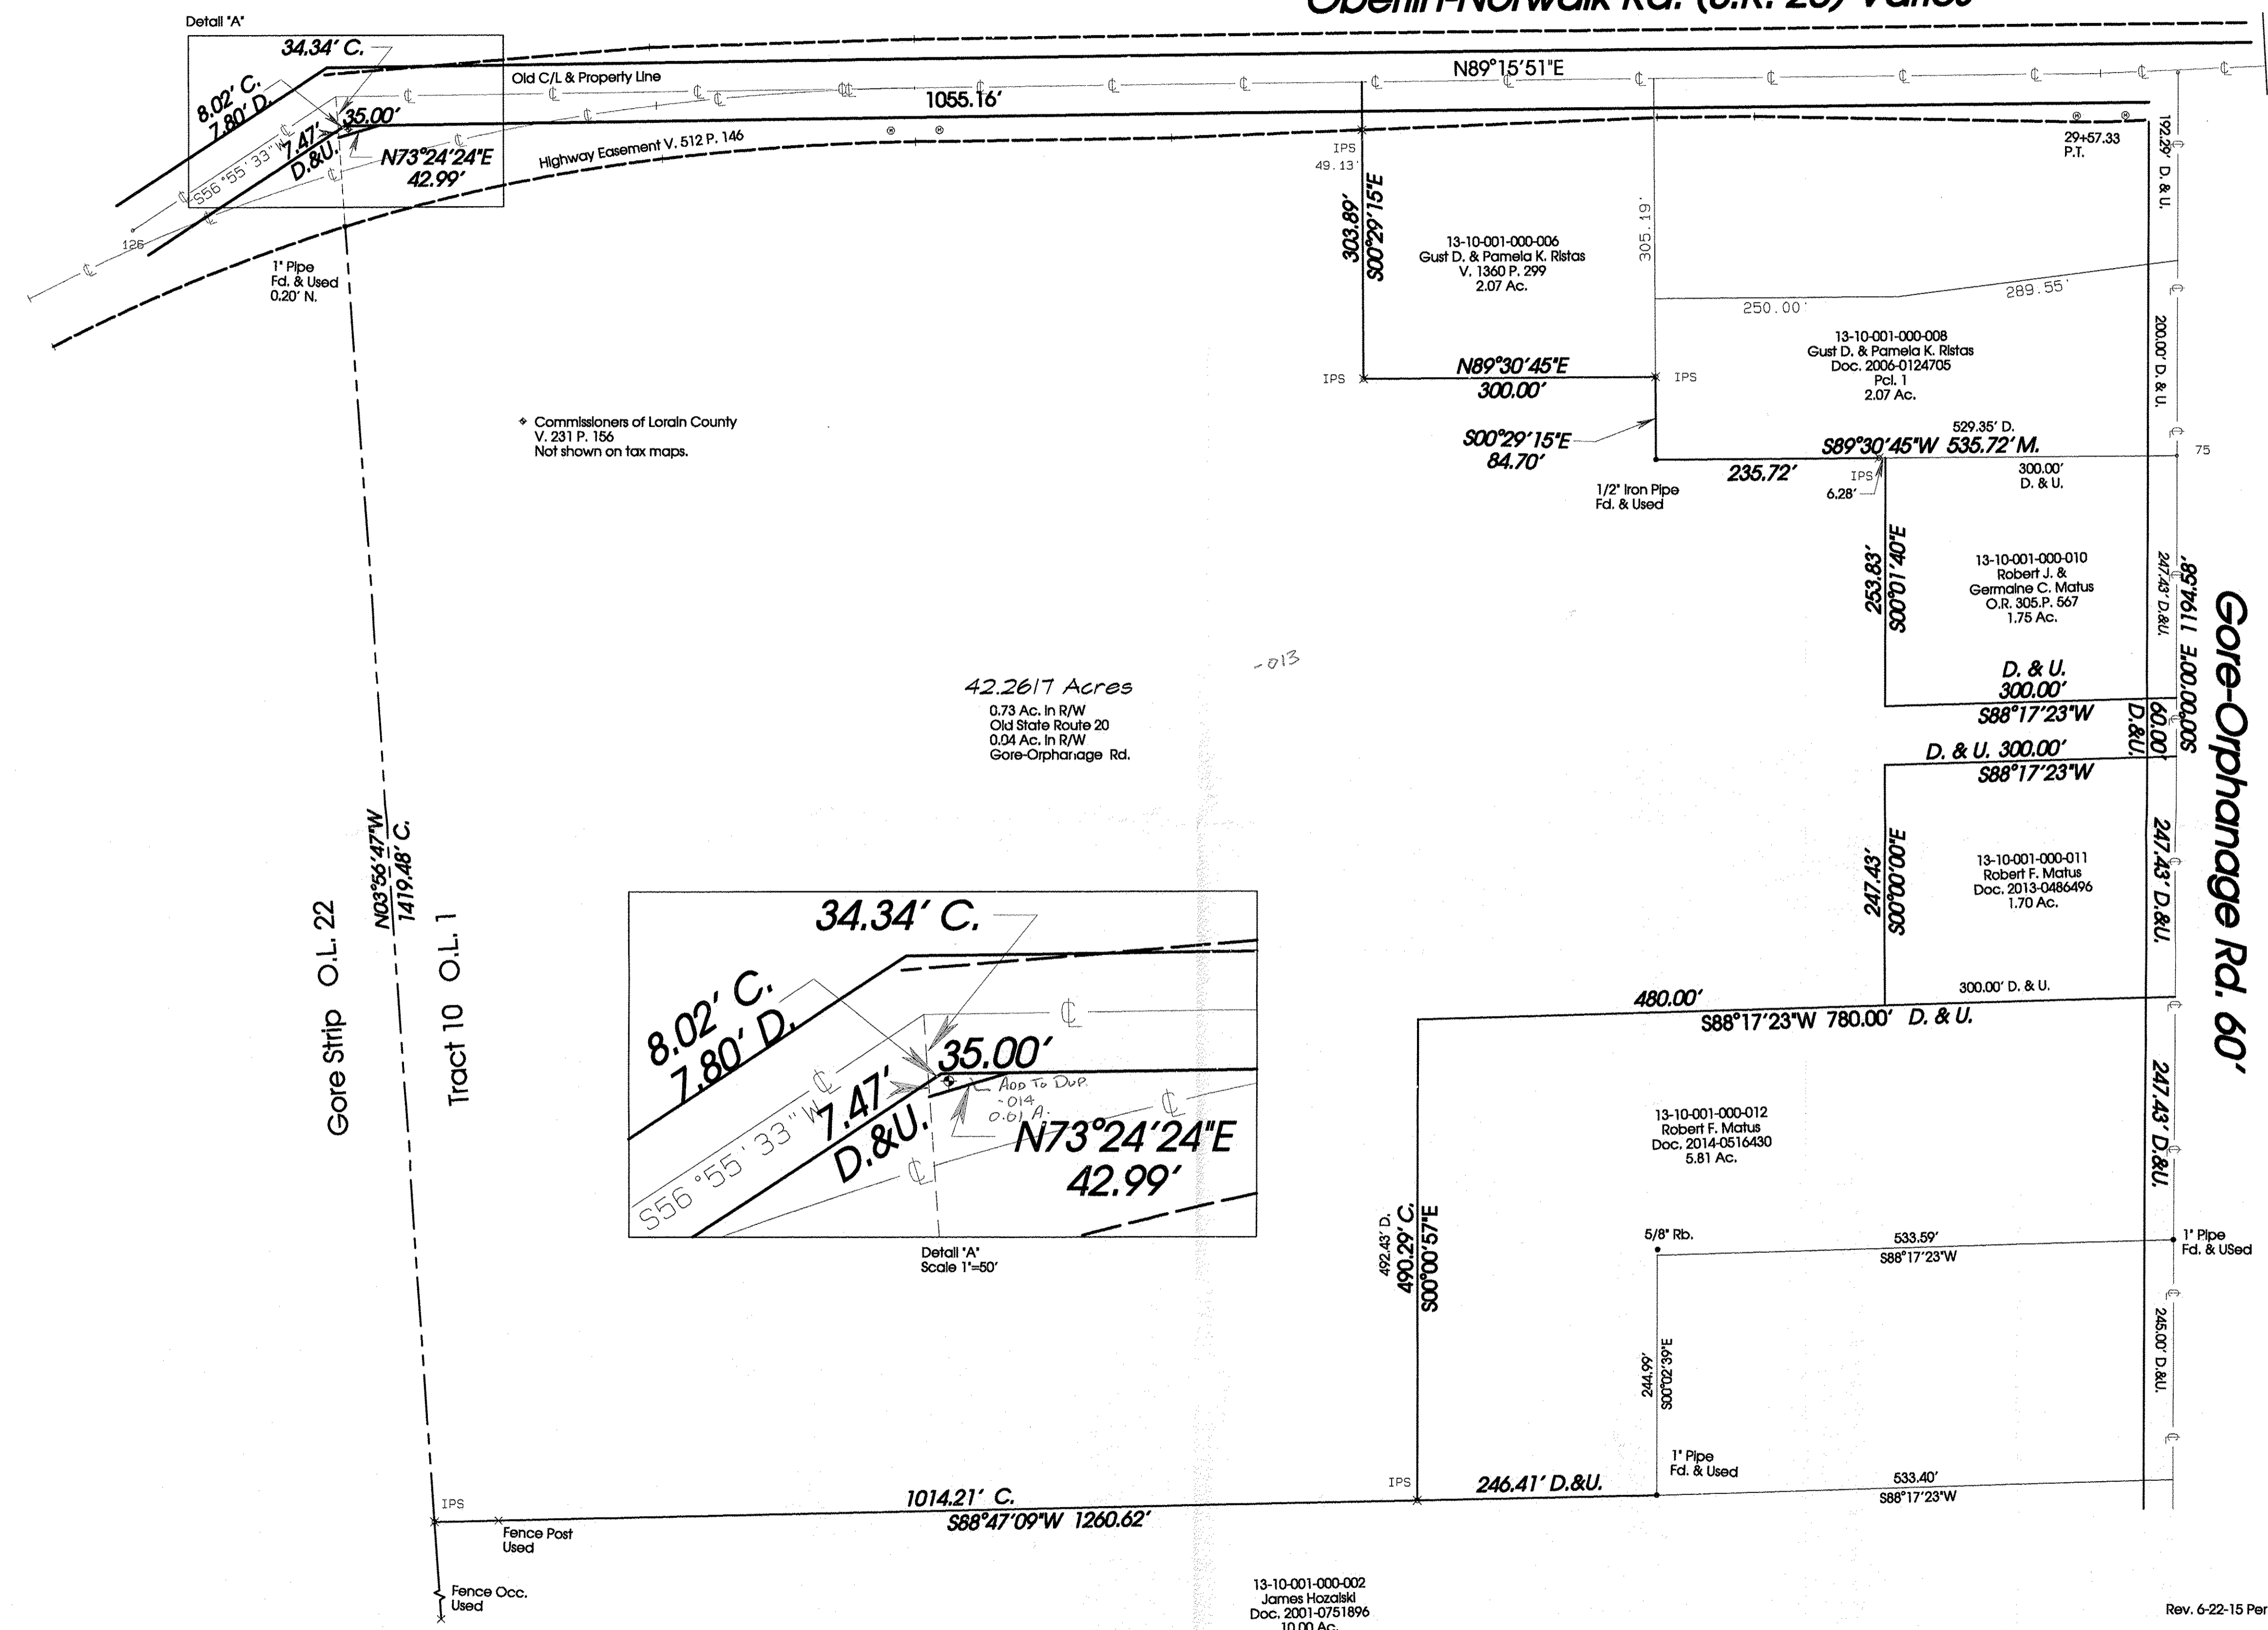


Plat of Survey  
**Robert J. & Germaine C. Matus**  
 Camden Twp. (14N, R 9W) Tr. 10 O.L. 1  
 Lorain Co. Ohio  
 Carlson Surveys Job: 1301-20B  
 October 2014

**Oberlin-Norwalk Rd. (S.R. 20) Varies**

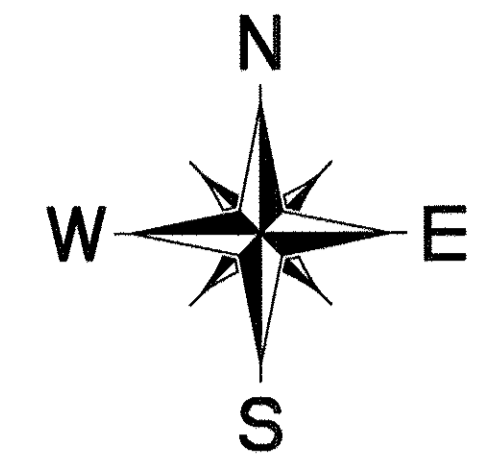


- ⊙ C/L Ref. Mon
- × Iron Pin Set
- Iron Pin Found as noted
- × Fence

◆ Commissioners of Lorain County  
 V. 231 P. 156  
 Not shown on tax maps.

42.2617 Acres  
 0.73 Ac. in R/W  
 Old State Route 20  
 0.04 Ac. in R/W  
 Gore-Orphanage Rd.

Gore-Orphanage Rd. 60'

APPROVED  
 LORAIN CO.  
 MAP DEPT.  
 DATE 01/29/15  
 BY T. SPILNER  
 15-03208-A

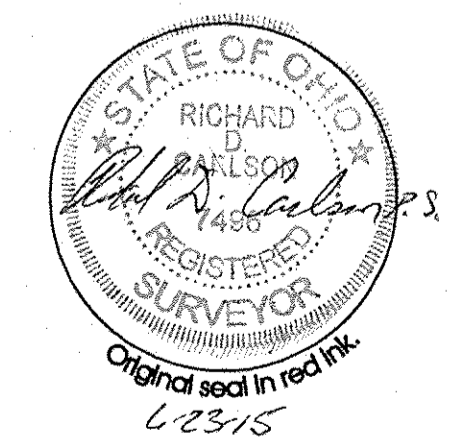

Rev. 6-22-15 Per Tax Map Comments (R/W Old State Route 20).

