

Plot of Survey
The Estate of Lawrence A. Weigel


Grafton Twp. (14N, R16W)
Lorain Co.

Carlson Surveys

Job: 1602-10R

O.L. 89 & 92
Ohio

March 2015

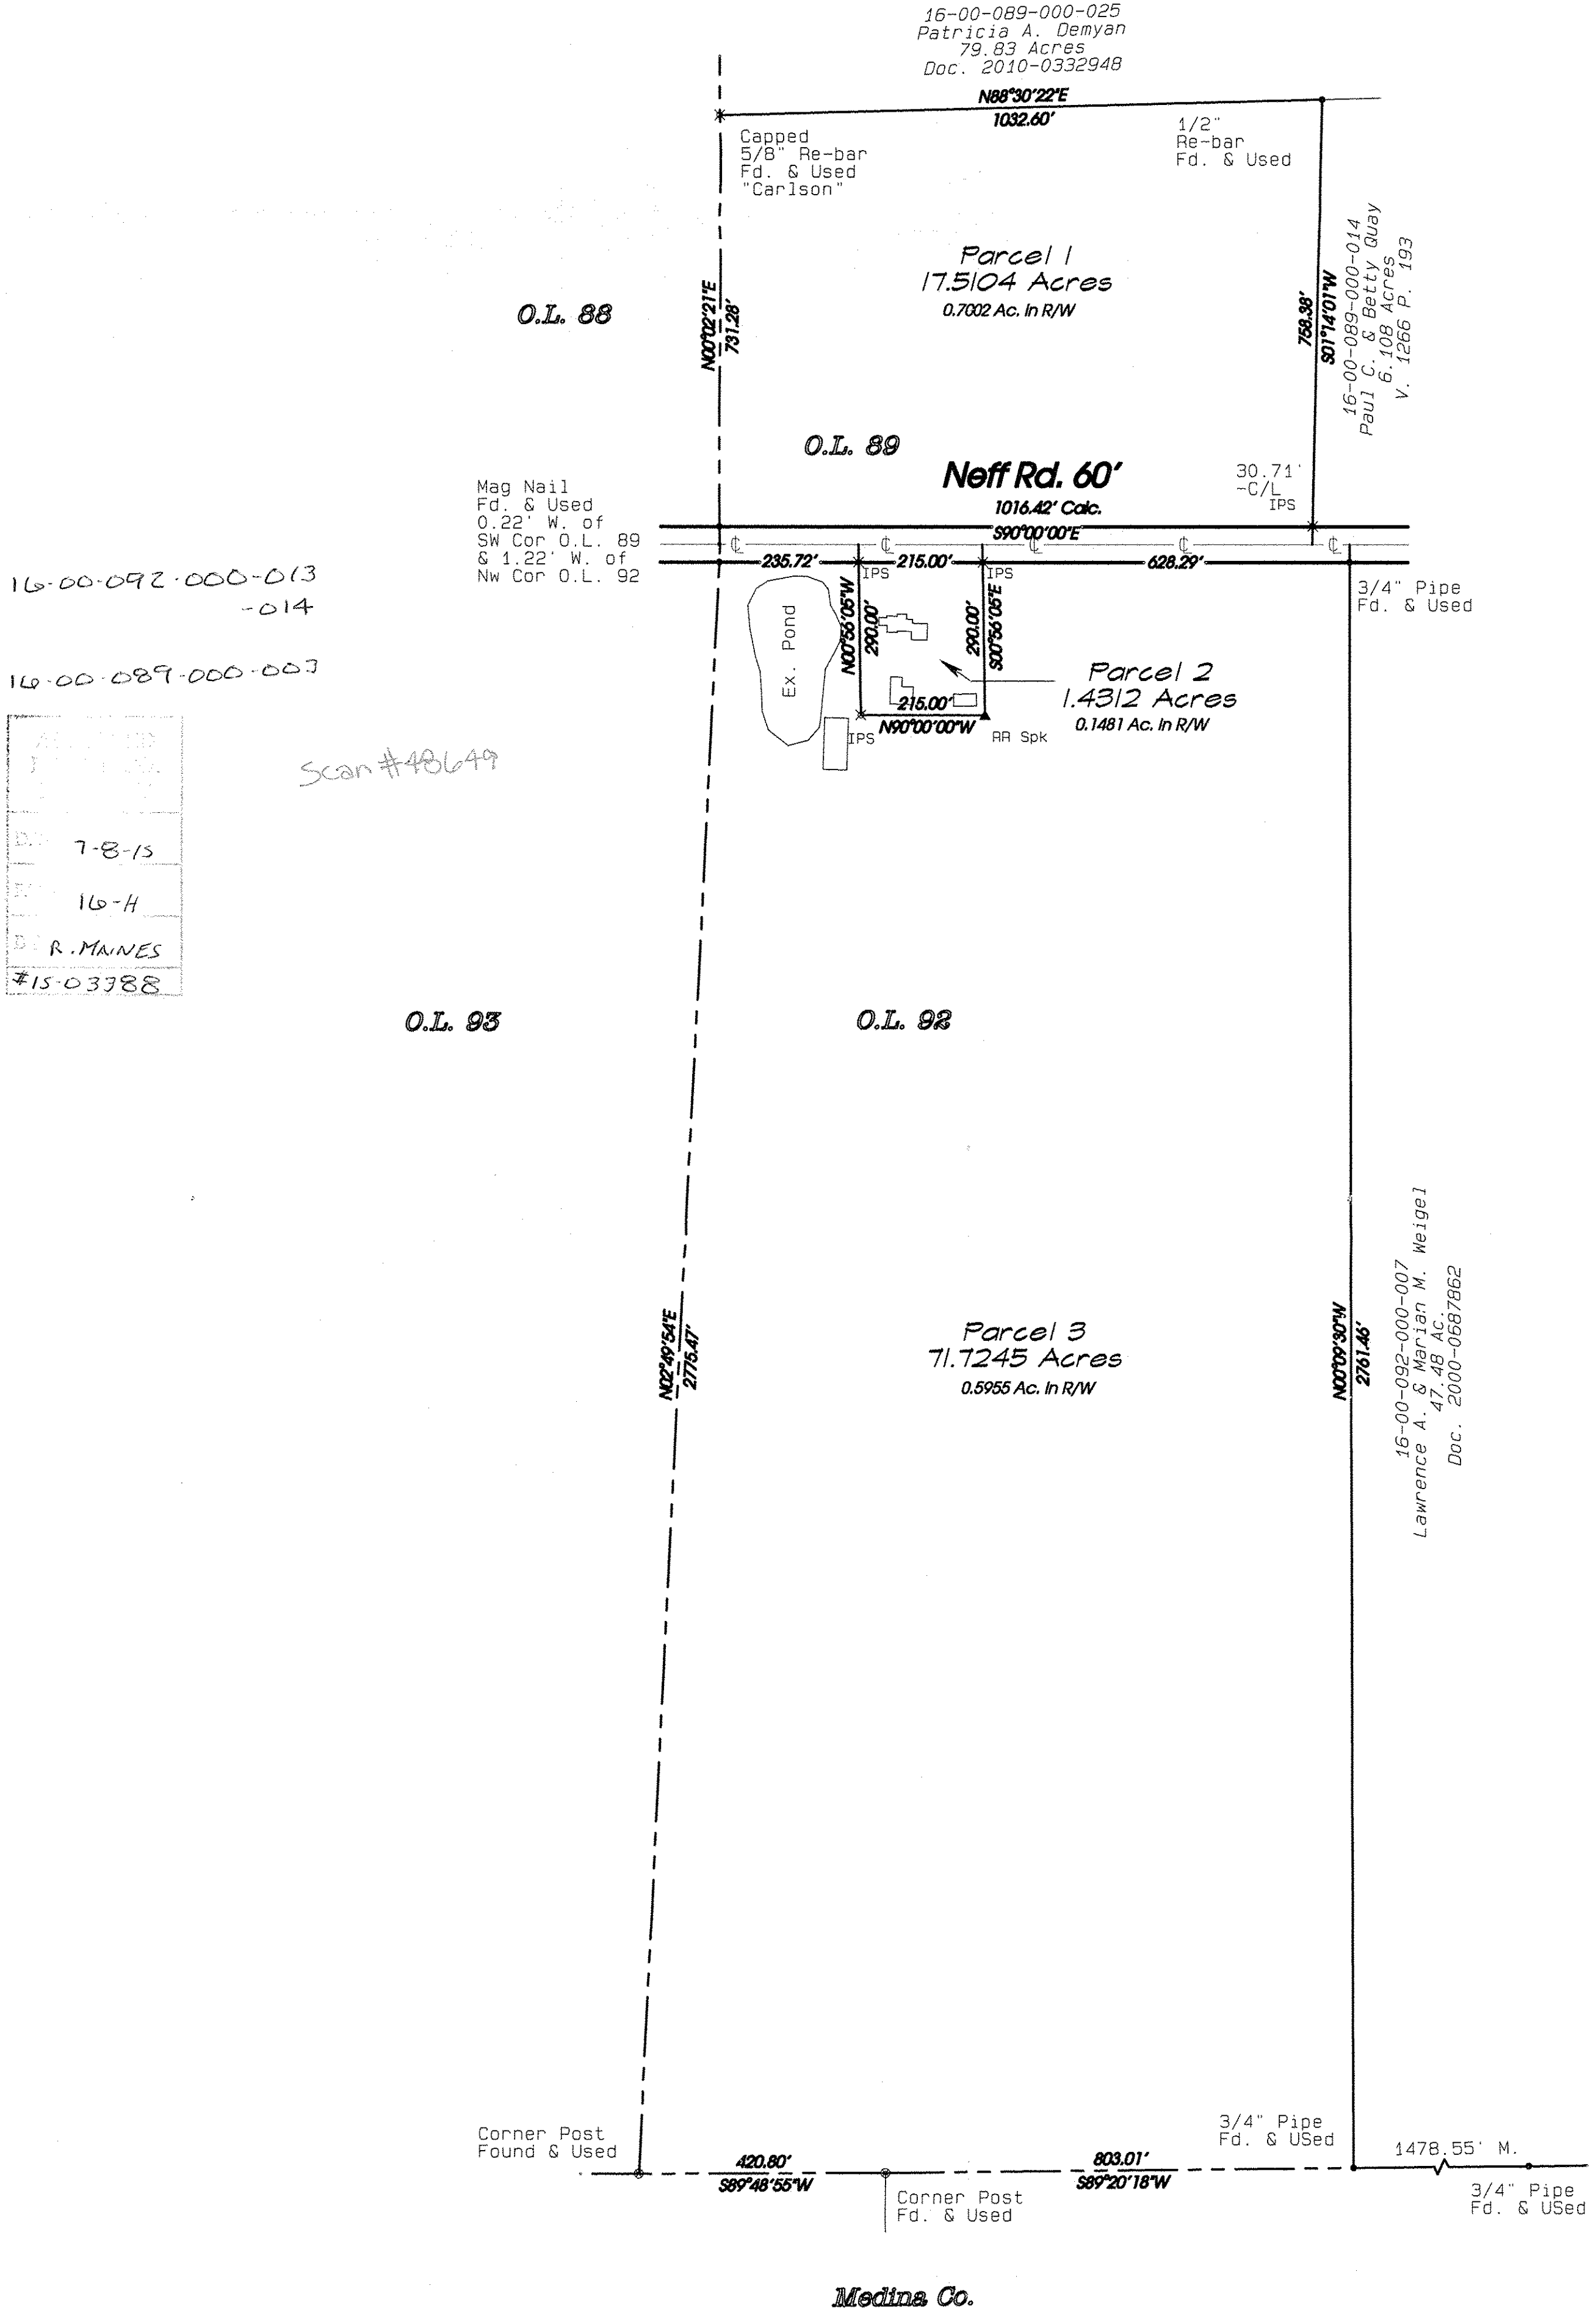

APPROVED
DATE
BY
7-8-15
16-H
R. MANES
#15-03788

