

03-00-037-117-056, -038, -037, -036
 #15-03289-X
 scan # 48699




Scale 1" = 40'
 April 18, 2009

Note: Only copies signed with Red Ink shall be considered Valid.

Patrick A. McGannon
 Patrick A. McGannon P.S. 7154

Prepared for Mr. David Brinkman of 829 Lafayette Boulevard, Sheffield Lake Ohio, 44054.

Being known as part of Sublot 9, and all of subplot 10 and 11 of the Coral Beach Subdivision and Sublots 196, 197, and 198 of the Coral Beach Subdivision Number 2, in the City of Sheffield Lake, Lorain, County of Lorain, in the State of Ohio.

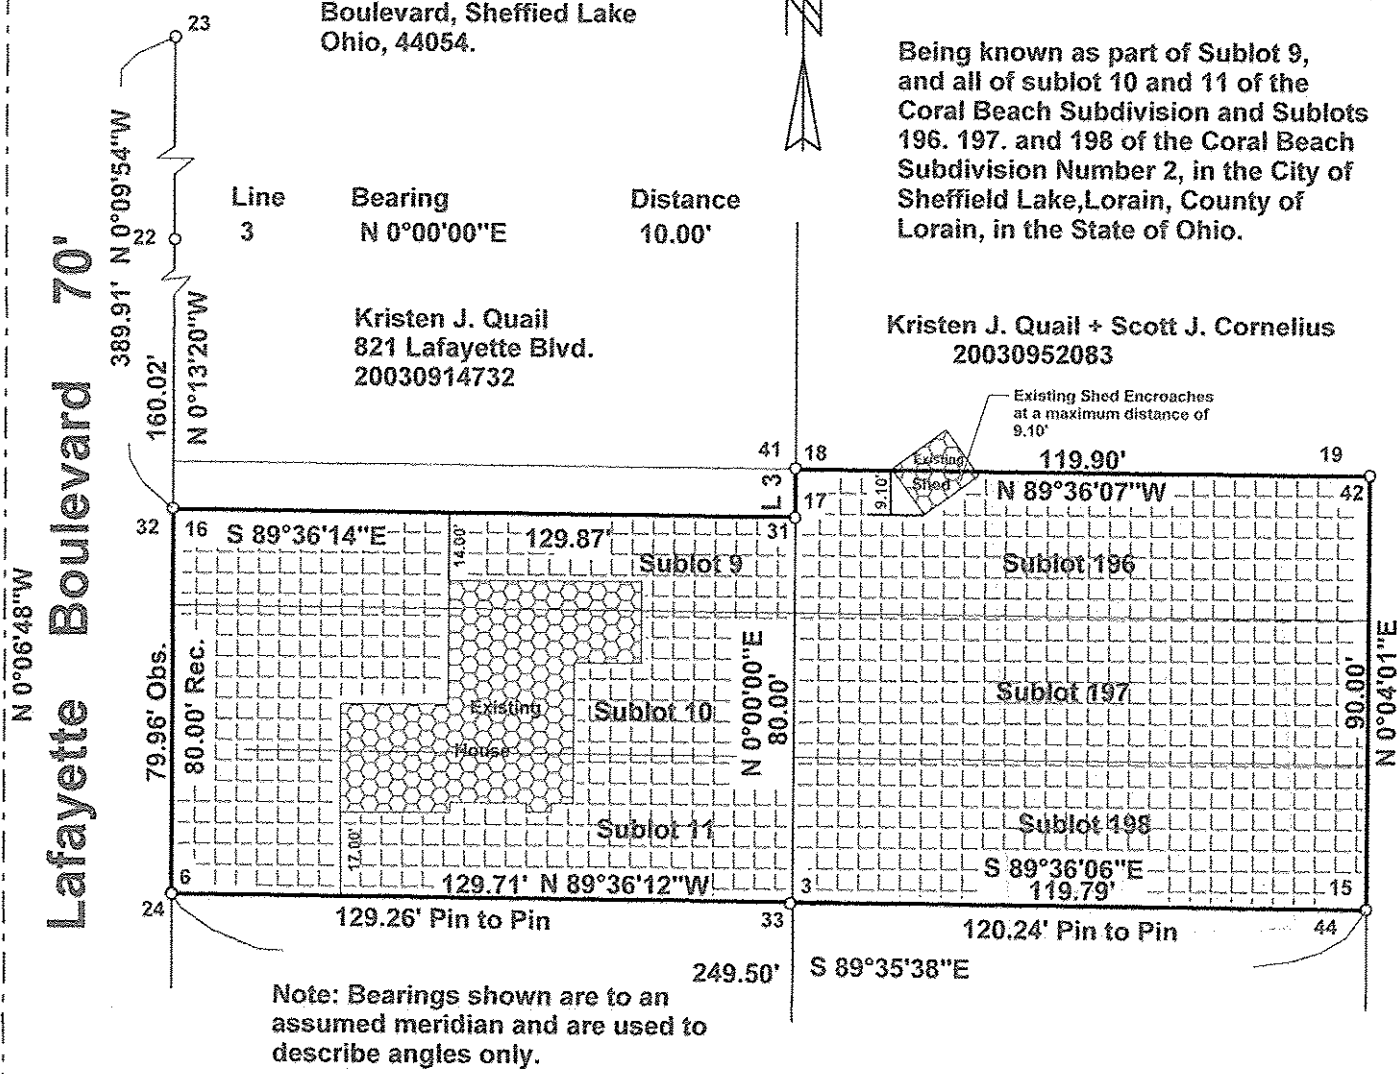

Note: Bearings shown are to an assumed meridian and are used to describe angles only.

Point	Northing	Easting	Description	Point	Northing	Easting	Description
1	500.00000	500.00000		25	1060.83228	380.78452	IRON PIN FOUND
2	500.83238	380.77291		26	1047.33315	308.58441	house
3	980.83238	380.77291		27	1021.36566	308.37798	house
4	949.99970	500.52001		28	1021.24747	286.18924	house
5	501.73128	252.01604		29	998.92267	286.15290	house
6	981.73034	251.06601		30	1042.29849	388.52757	nail
7	471.38134	252.07608		31	1060.60307	380.75878	IRON PIN FOUND
8	471.67238	380.77291		32	1061.72843	250.91540	IRON PIN FOUND
9	1031.73010	250.89730		33	980.48091	380.33303	IRON PIN FOUND
10	1030.83238	380.77291		34	980.84778	380.78161	POINT
11	1040.83238	380.77291		35	1047.17000	348.84269	house
12	1039.99964	500.62386		36	1030.13571	348.82480	house
13	949.99965	500.56001		37	1000.95799	334.82214	house
14	1039.99958	500.67215		38	1071.03602	400.79571	shed
15	979.99967	500.56001		39	1061.51104	407.70160	shed
16	1061.73019	250.90777	IRON PIN FOUND	40	1069.69042	418.98976	shed
17	1060.83238	380.77291		41	1070.84397	380.76926	REBAR SET
18	1070.83238	380.77291		42	1069.99937	500.66913	REBAR SET
19	1069.99961	500.66517		43	986.90578	465.32125	nail
20	1311.72970	250.41326		44	979.99820	500.56747	REBAR SET
21	1310.83238	380.77291		45	1000.63965	330.35466	house
22	1221.74401	250.29491	IRON PIN FOUND	46	999.14050	330.32598	chimney
23	1451.63348	249.79249	IRON PIN FOUND	47	999.01592	325.07728	chimney
24	981.76653	251.07486	IRON PIN FOUND	48	998.87169	309.09748	house

Boundary Survey

Patrick A. McGannon
 Registered Professional Surveyor

1731 Gettysburg Drive, Lorain, Ohio 44053

(440)-2822712

