

SURVEY

OF

PARCEL 06-24-158-000-039 WEST OF BLACK RIVER

110 CASCADE STREET

CITY OF ELYRIA COUNTY OF LORAIN STATE OF OHIO




DATE: DEC 1, 2015

SCALE: 1" = 30'

06-24-158-000-036

06-24-158-000-037
BAYVIEW LOAN SERV. LLC
INST# 2015-0548159

06-24-158-000-038
ELYRIA CITY
INST# 2011-0360940

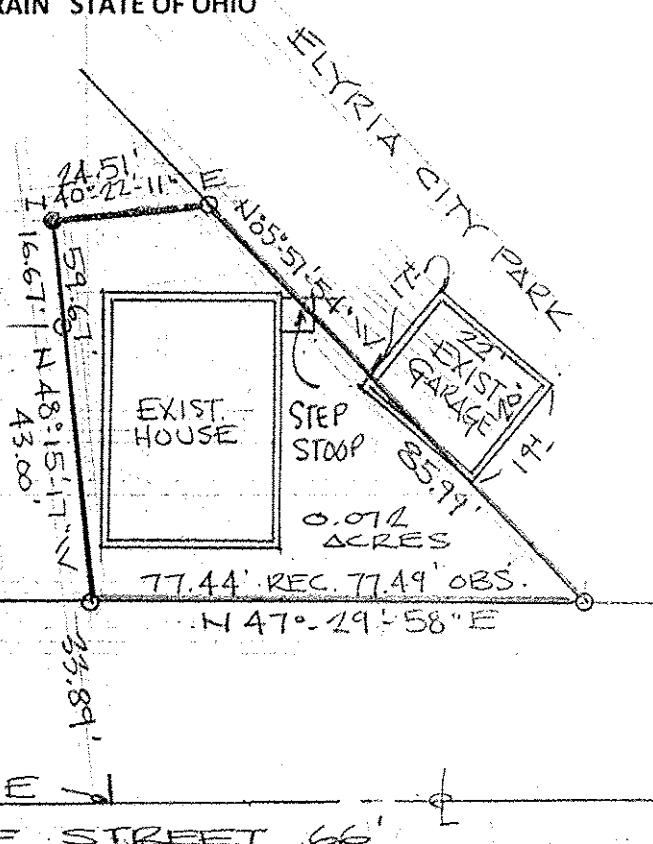

142.61'

N 47° 29' 58" E

CASCADE STREET 66'

LAVE AVE. 66'

SCAN# 48736

06-24-158-000-039

PREPARED FOR:
REAL ADVANTAGE LLC
1000 COMMERCE DRIVE,
SUITE 520
PITTSBURGH, PA 15275

LEGEND:
○ = PIPE FOUND
● = SPIKE FOUND OR SET

APPROVED LORAIN CO. RECEIPT	DATE 12-11-15	PAGE 6-24	BY R. MAJES	# 15-03344-X
-----------------------------------	------------------	--------------	----------------	-----------------

