
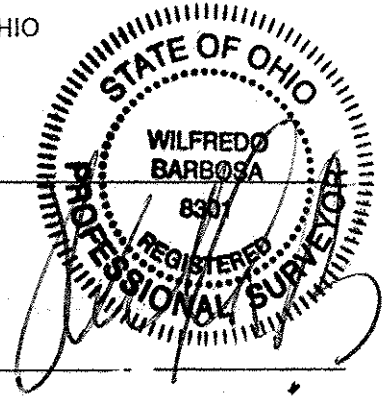



SURVEY
OF
PARCEL 06-24-026-103-002
ORIGINAL ELYRIA TWP. LOT 26 WEST OF BLACK RIVER
CITY OF ELYRIA COUNTY OF LORAIN STATE OF OHIO

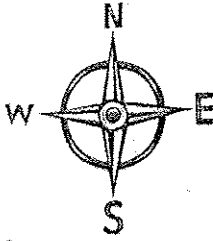

DATE: SEPT. 2015 BELL AVENUE 60'
SCALE: 1" = 30'

06-24-026-103-002 SKIPPY SCAN # 48757

PENFIELD AVENUE 66'

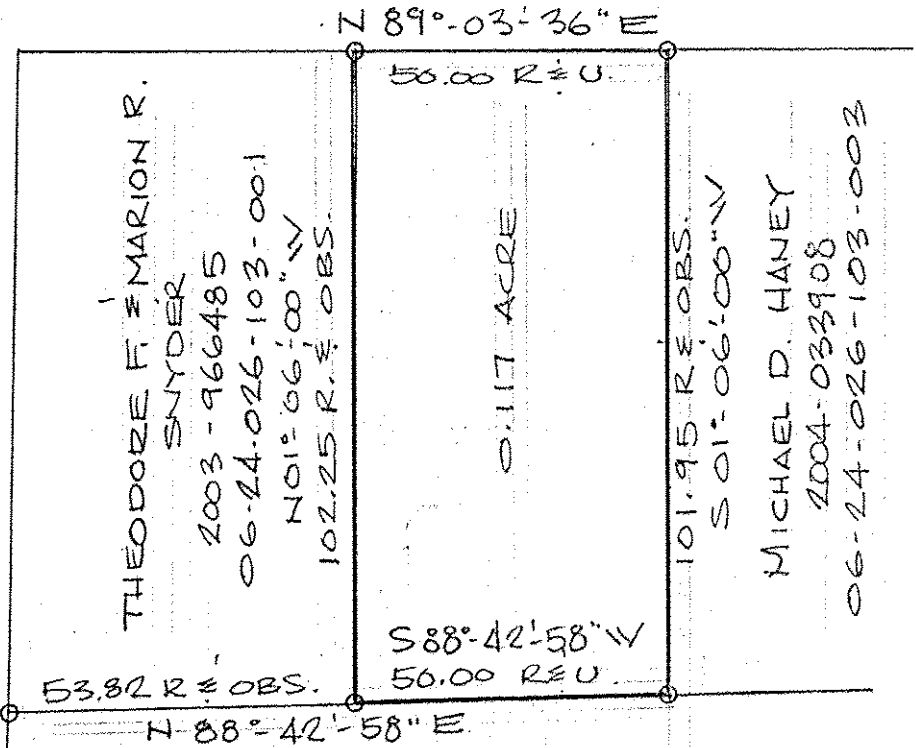

LEGEND:
O = IRON PIPE FND.
R = RECORD
U = USED
OBS = OBSERVED

HINKSON'S ALLOTMENT NO. 1 P.V. 9 PG. 31

PREPARED FOR:
Marc Chappo, Administrator for the Estate of Mary Rose Chappo
1057 Bell Ave. Elyria Ohio 44035

APPROVED FOR RECORD	DATE	PAGE	BY
	10-28-15	6-79	R. MAINES
			#15-03324-D