

MAP OF SURVEY
PREPARED FOR
KOENIG



Situated in the Village of Wellington, County of Lorain
State of Ohio; and known as being part of Original Wellington
Township Lot No. 22

| | |
|------|------------|
| DATE | 9-27-16 |
| PLAT | 18-00-022 |
| BY | R. MAINE S |
| # | 16-03529-D |

18-00-022-110-004




Scale : 1" = 30'
Date : September, 2016

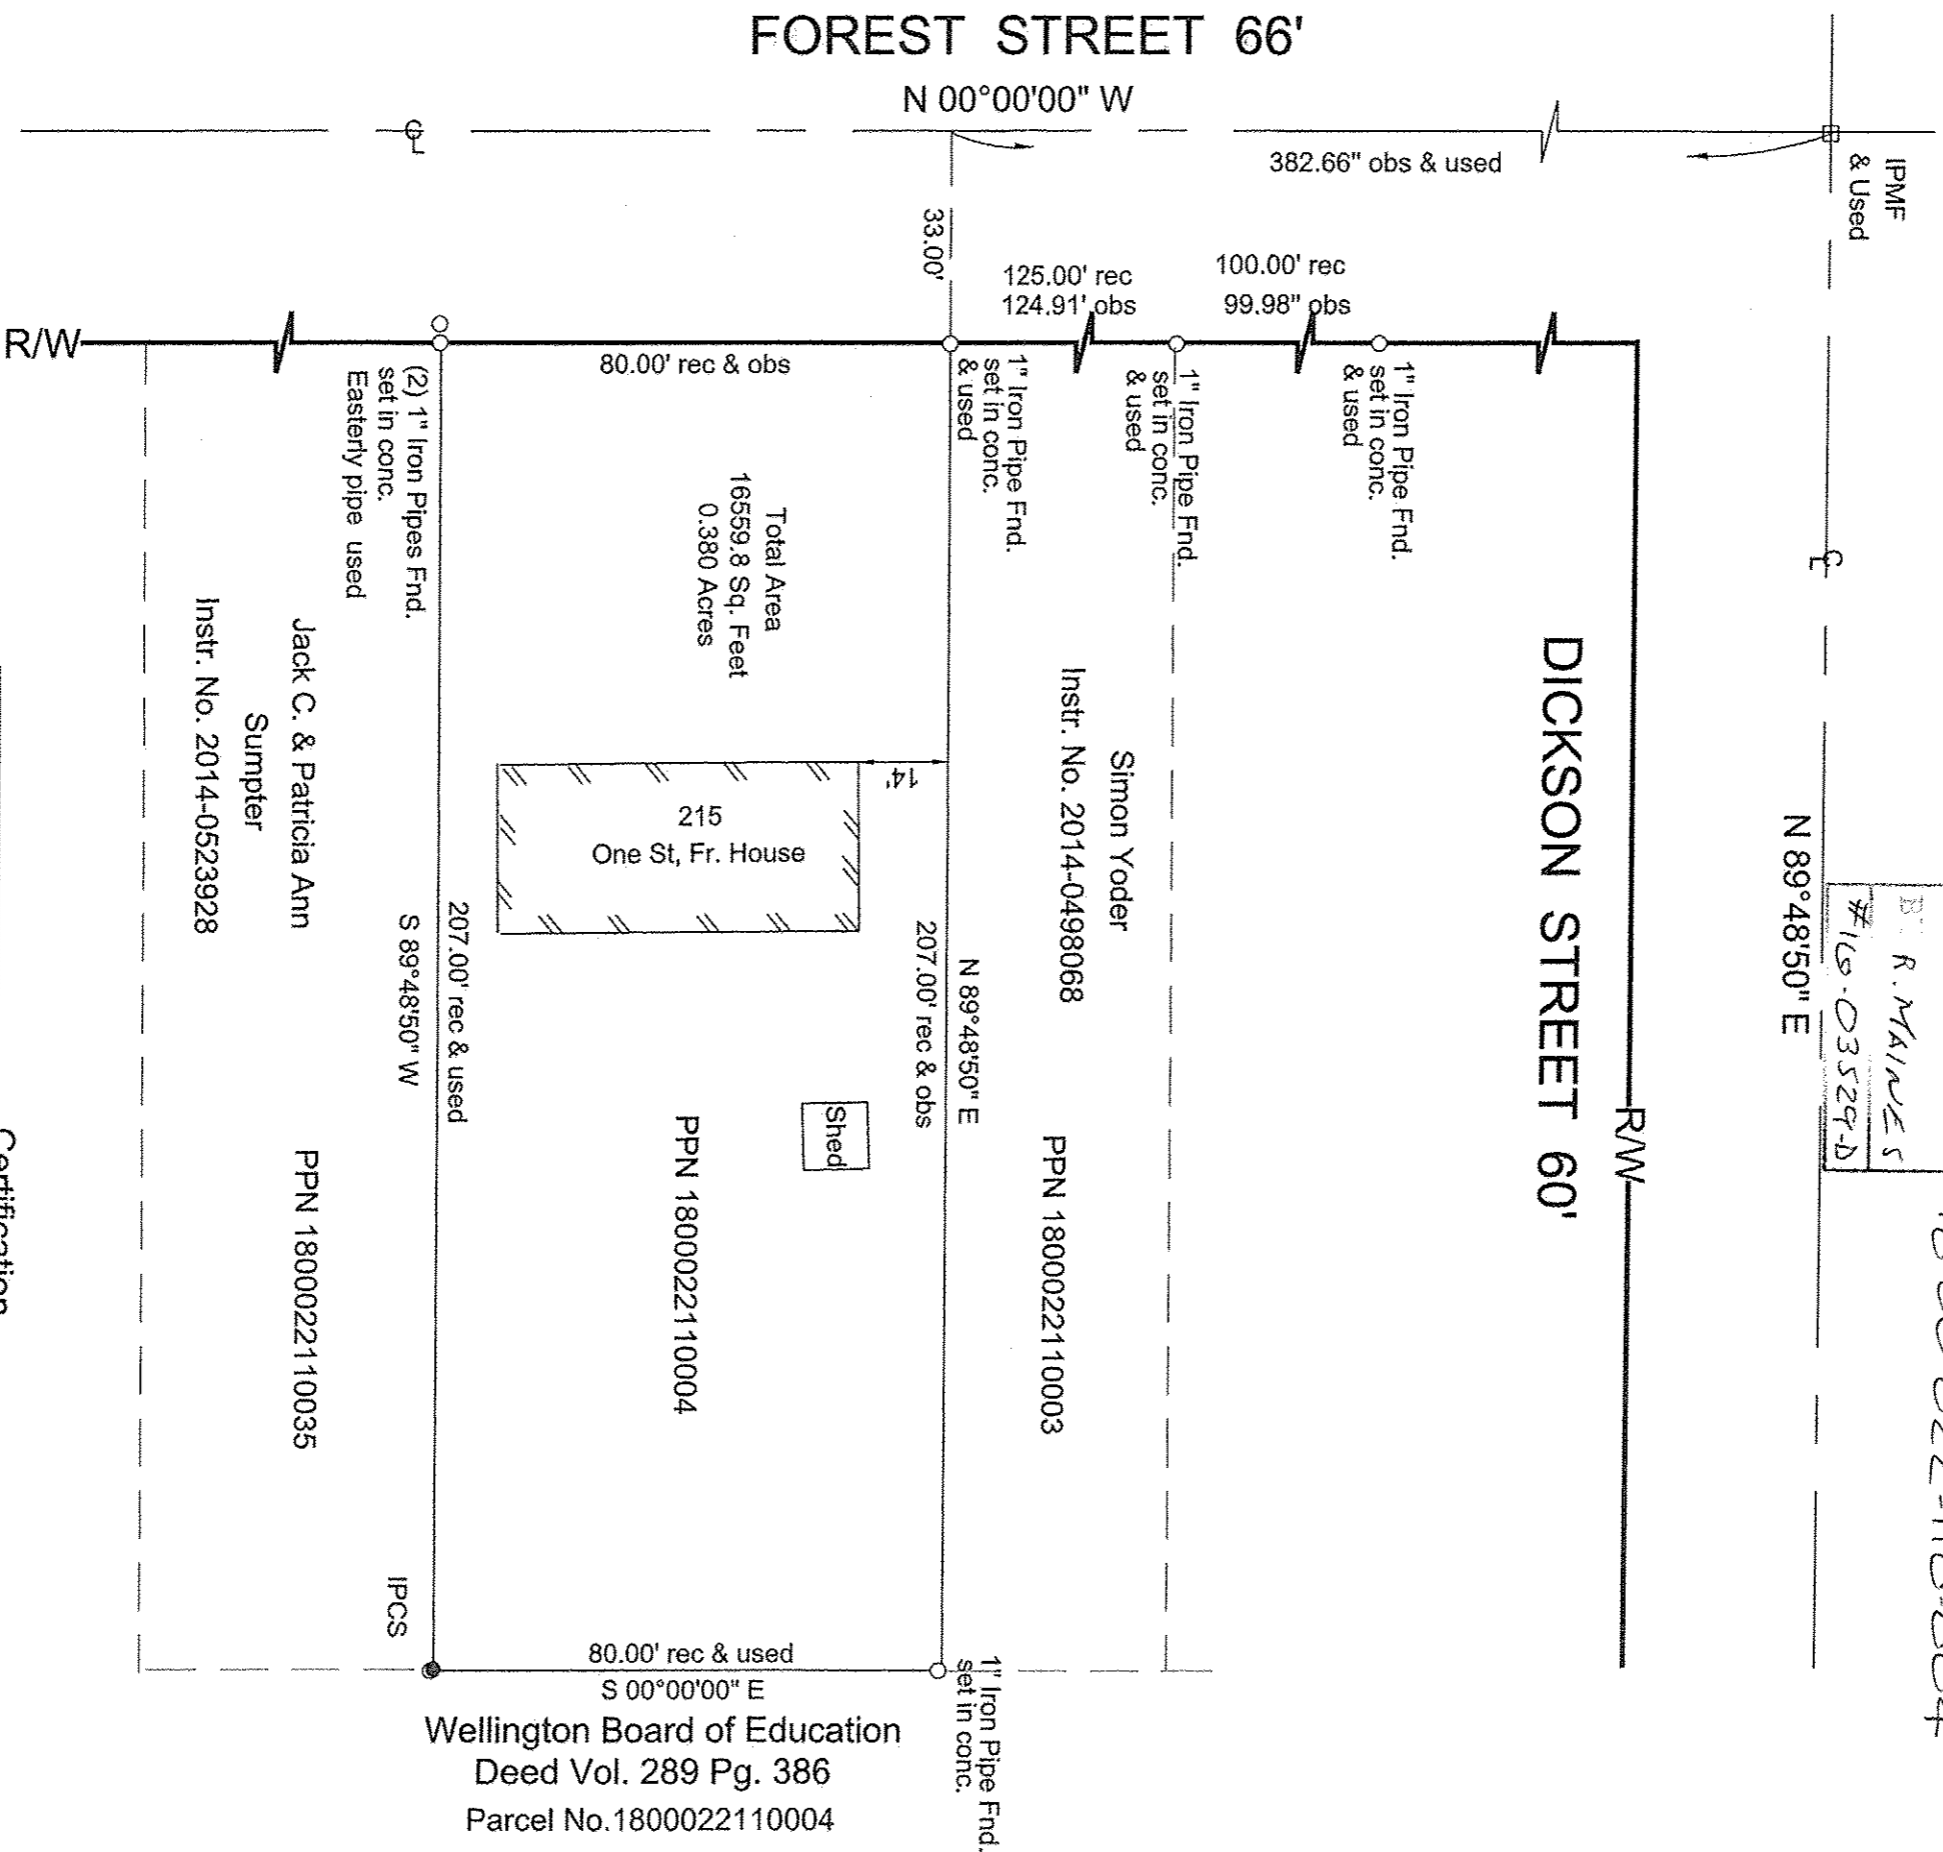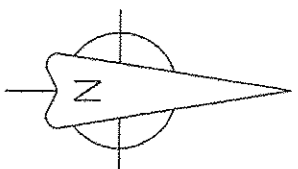

LEGEND

- IPCS = Iron Pin Capped Set
- IPF = Iron Pin Found
- IPCF = Iron Pin W/Cap Found
- IPMF = Iron Pin Monument Found

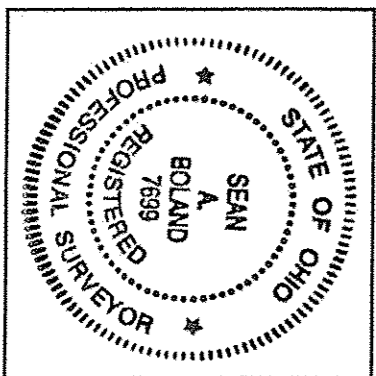

Certification

This Plat was prepared from the analysis of Recorded Plats, Recorded Deeds and Lorain County Records. Bearings are to an assumed meridian and are used to indicate angles only. Distances are given in feet and decimal parts thereof. All of which I certify to be correct to the best of my knowledge.

Sean A. Boland, P.S.
Registered Ohio Professional
Surveyor 7699

Wellington Board of Education
Deed Vol. 289 Pg. 386
Parcel No. 1800022110004