


Note: Bearings shown are based on the Ohio State Plane, Grid North (3401), but are shown to describe angles only.

Being known as part of Original Lots 56 and 65 of Columbia Township, and known as Lorain County Parcel Numbers
 12-00-056-000-012, 12-00-056-000-033,
 12-00-056-000-026, 12-00-065-000-27,
 12-00-065-000-029 in the Township of Columbia, County of Lorain and the State of Ohio.

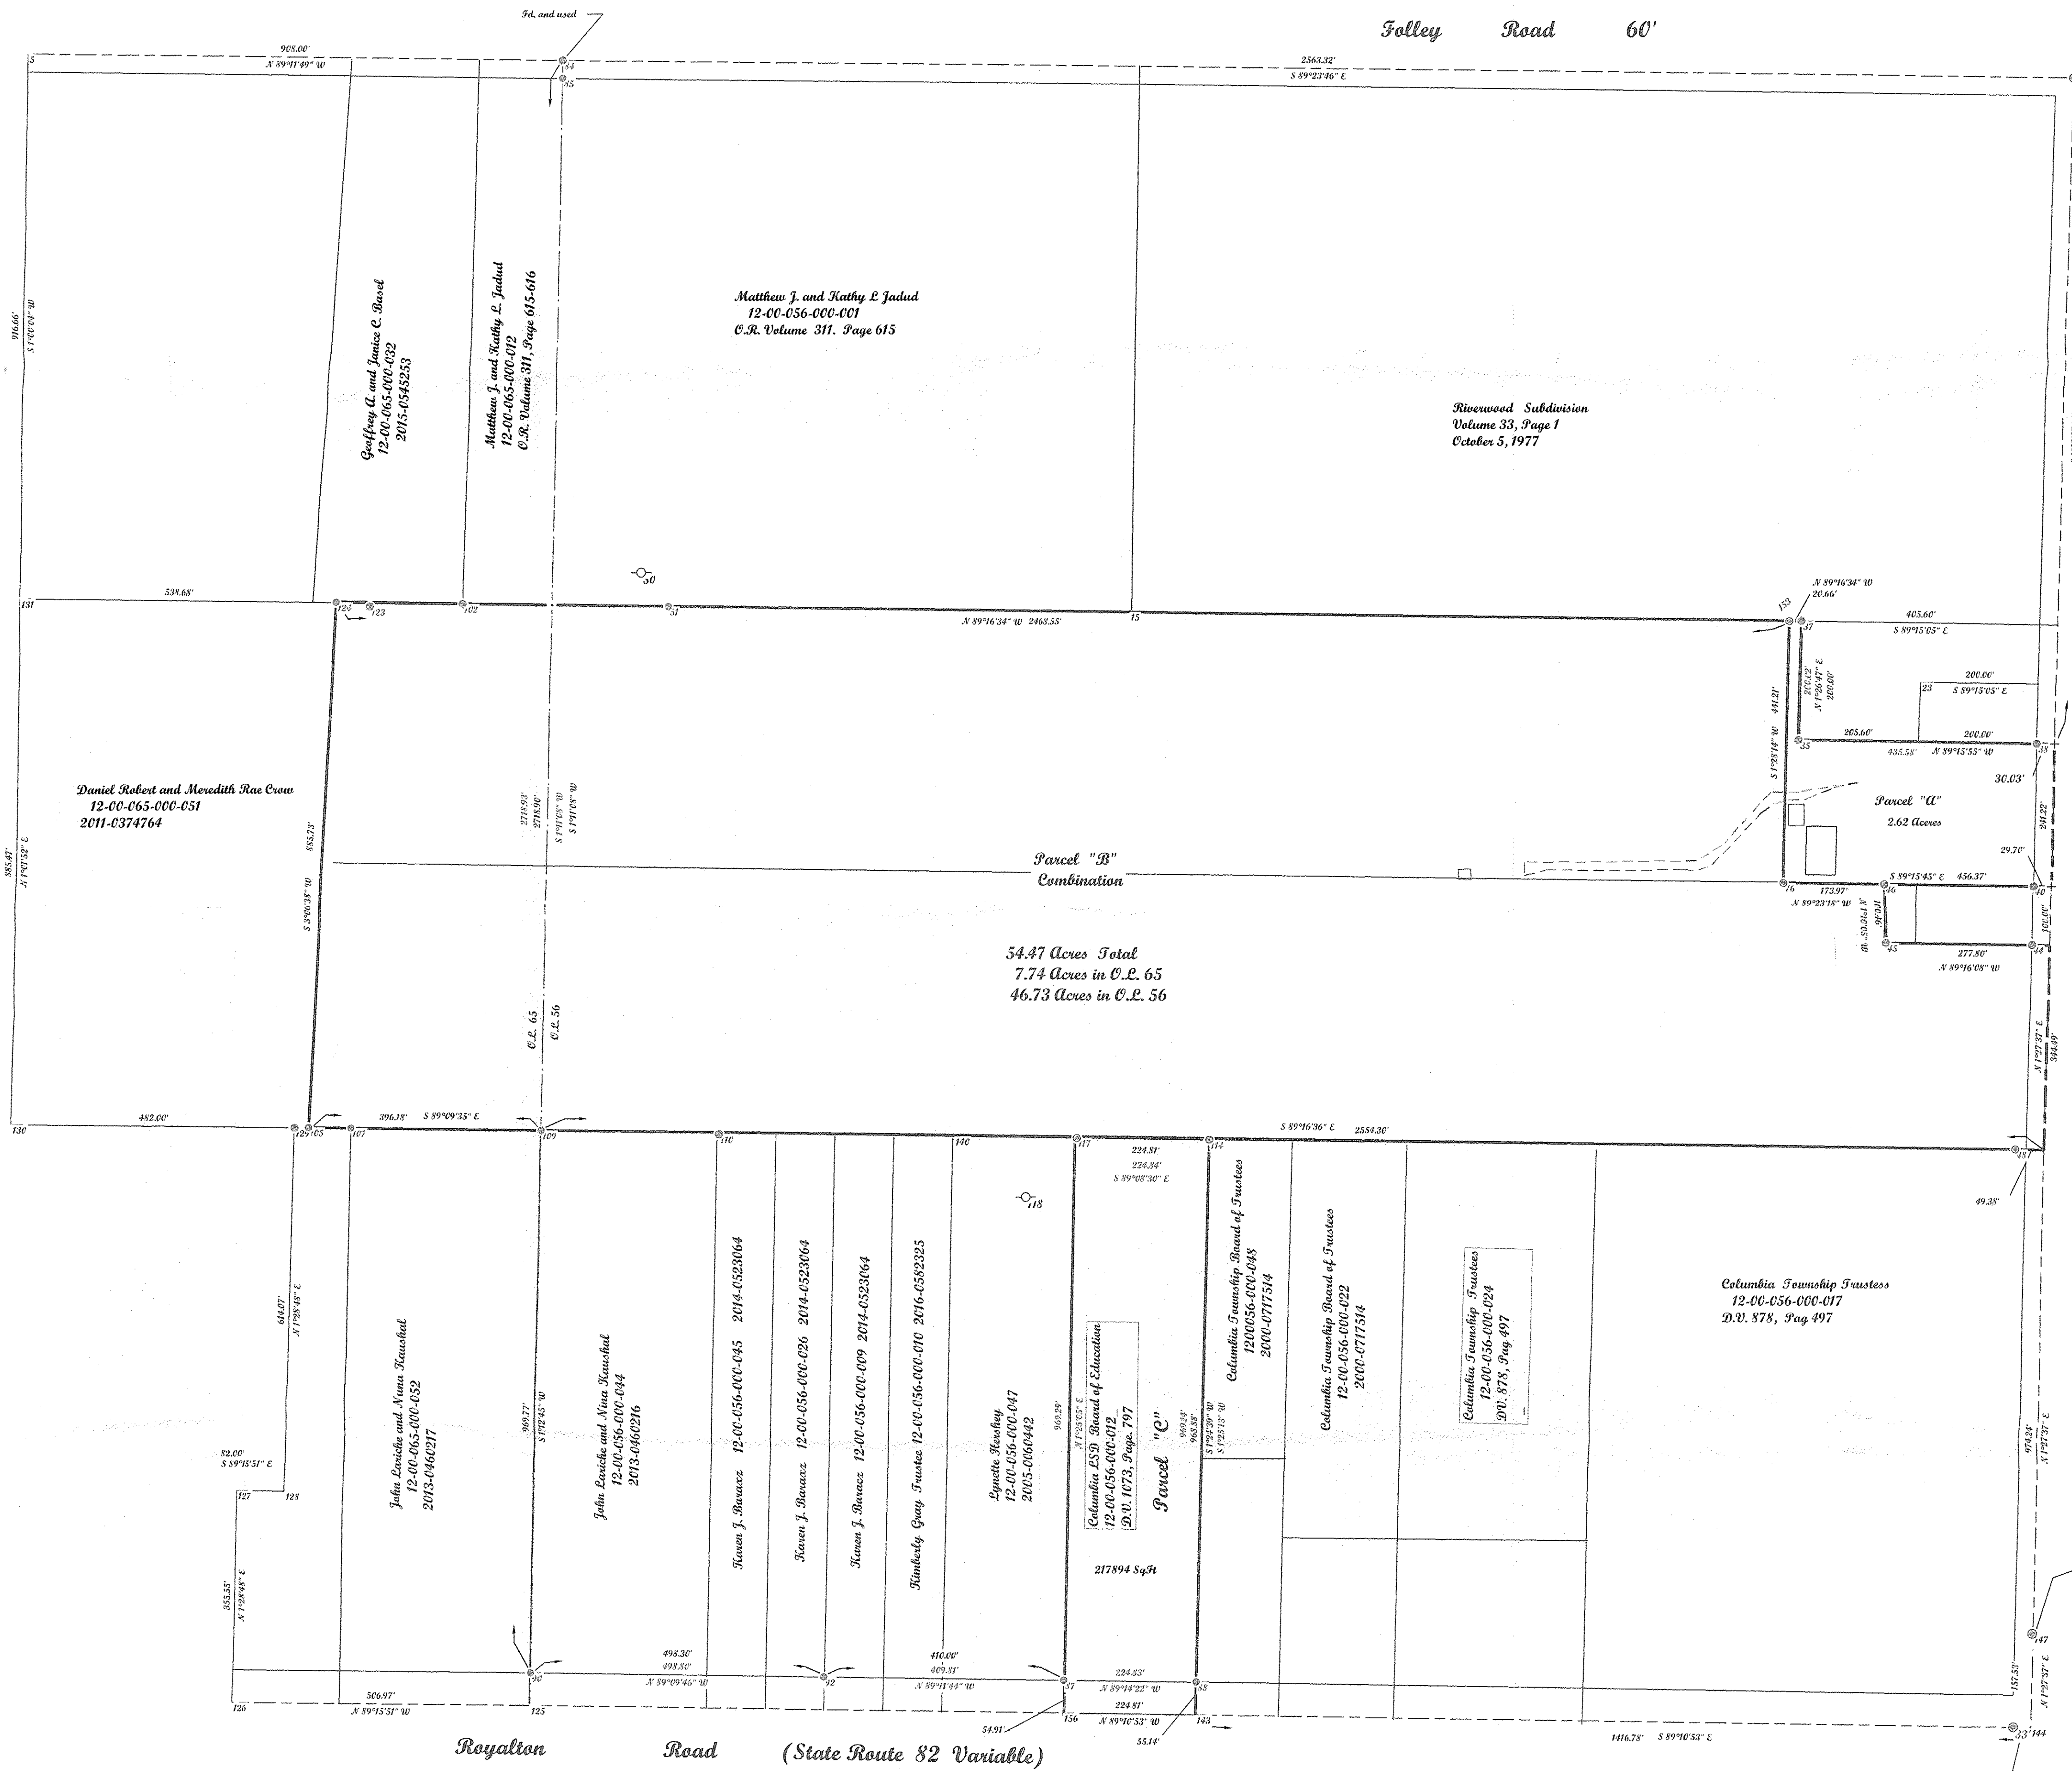

- POINTS DESCRIBE
- 5
 - 6
 - 10
 - 15
 - 20
 - 23
 - 31 IRON PILE FOUND IN A MONUMENT BEY
 - 32 IRON PILE FOUND IN A MONUMENT BEY
 - 33 IRON PILE FOUND IN A MONUMENT BEY
 - 34 IRON PILE FOUND
 - 35 IRON PILE FOUND
 - 36 IRON PILE FOUND
 - 37 IRON PILE FOUND
 - 38 IRON PILE FOUND
 - 40 IRON PILE FOUND bent
 - 44 IRON PILE FOUND
 - 45 1 1/4 in iron bar found bent
 - 46 IRON PILE FOUND
 - 48 REBAR SET
 - 50 POWER POLE
 - 51 REBAR FOUND vert eng
 - 76 REBAR SET
 - 84 IRON PILE FOUND
 - 85 REBAR FOUND vert eng
 - 87 REBAR FOUND by pp
 - 88 REBAR FOUND by pp
 - 90 REBAR FOUND bent
 - 92 REBAR FOUND
 - 102 IRON PILE FOUND
 - 104 IRON PILE FOUND inch and a half
 - 105 REBAR FOUND
 - 107 REBAR FOUND neff
 - 109 REBAR FOUND neff
 - 110 IRON PILE FOUND inch and a half
 - 113 IRON PILE FOUND
 - 114 IRON PILE FOUND
 - 117 REBAR SET
 - 118 POWER POLE
 - 123 IRON PILE FOUND pipe
 - 124 REBAR FOUND neff
 - 125
 - 126
 - 127
 - 128
 - 129
 - 130
 - 131
 - 140
 - 143
 - 144
 - 147
 - 153 Rebar Set
 - 156


APPROVED
 LORAIN CO.
 M...
 DATE 4-6-17
 PAGE 12-00-056
 BY J. Hofford
 #17-03655

McGannon Surveying, LLC
 Boundary Survey
 Patrick A. McGannon
 Registered Professional Surveyor
 1731 Gettysburg Drive, Lorain, Ohio 44053 (440) 282-2712
 www.mcgannonsurveying.com

Note: Only copies signed with Red ink shall be considered Valid.

Patrick A. McGannon
 Patrick A. McGannon P.S. 7154

Prepared for Columbia LSO Board of Education

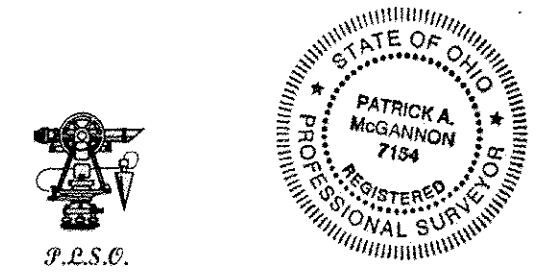

Note: Dimensions shown in Blue are record values and those shown in red are field observed values.

Columbia schools 2017 Gps. 780 J.N. 1566