

TOTAL AREA  
0.3449 ACRES (15,023.8971 FT<sup>2</sup>)

LEGEND

SET	FOUND	DESCRIPTION
○	●	IRON PIN/ROD
◇	◆	SURVEY NAIL
⊙	⊛	MAG SPIKE
⊗	⊘	DRILL HOLE
⊕	⊖	RAILROAD SPIKE
⊠	⊡	MONUMENT BOX
⊙	⊚	CONCRETE MONUMENT
○	○	IRON PIPE
▲	▲	STONE
■	■	WOOD POST

REFERENCES

**Lorain County Subdivision Plat Records**  
 Gama Homes Inc. Subdivision No. 2 (PV 24, Pg 11)(Sep, 1964)  
 Gama Homes Inc. Subdivision No. 3 (PV 24, Pg 12)(Apr, 1964)  
 Gama Homes Inc. Subdivision No. 5B (PV 24, Pg 61)(Jul, 1966)


**Lorain County Deed Records**  
 Volume and Pages as indicated

ABBREVIATIONS

(D) PER DEED (M) MEASURED (P) PER PLAT  
(C) CALCULATED

ALL IRON PINS SET ARE 5/8"x30" REBAR WITH YELLOW PLASTIC CAPS STAMPED "HOZALSKI P.S. 8677/ VECTOR SURVEYING"


ALL DRILL HOLES SET ARE 5/8" IN DIAMETER

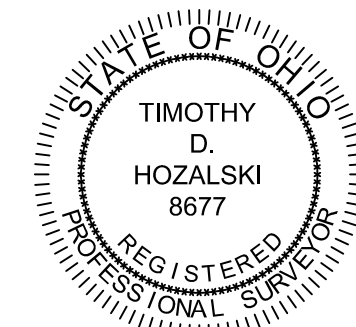

Timothy D. Hozalski, P.S.  
12-22-16  
Date



Retracement for RJ Perritt Construction  
 Being a parcel of land located in Sublot 3 in Gama Homes, Inc. Subdivision No. 2, Original Avon Township Lot 18, City of Avon Lake, Twp 7 North, Range 16 West, Connecticut Western Reserve, Lorain County, Ohio

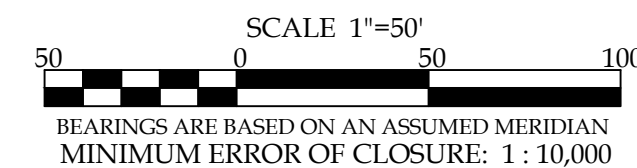

OFFICE: 440-865-8445 WAKEMAN, OH  
 VECTORSURVEYING@YAHOO.COM

Job No.	16-100	Drawn By:	CAD
Date:	Dec, 2016	Checked By:	TDH